

# Addendum Number 02

**Gensler**

<b>Project</b>	Ramsey - Basketball Locker Room	<b>Date</b>	11/30/2021
<b>Project Location</b>	92 Catamount Road Cullowhee, NC 28723	<b>Architect's Project Number</b>	09.9478.000
<b>Owner / Client</b>	Western Carolina University	<b>File</b>	A2 <b>This is page</b> 1 of 2
<b>To</b>	Western Carolina University, Facilities Management	<b>Attention</b>	Daniel Fiskeaux
<b>Address</b>	3476 Old Cullowhee Road		
<b>City</b>	Cullowhee	<b>State</b>	NC <b>Zip Code</b> 28723
<b>Delivered via:</b>	<input type="checkbox"/> <b>Messenger</b>	<input type="checkbox"/> <b>Hand carried</b>	<input type="checkbox"/> <b>Facsimile</b>
	<input type="checkbox"/> <b>Express</b>	<input type="checkbox"/> <b>Pick-up</b>	<input checked="" type="checkbox"/> <b>E-mail Address</b>
	<input type="checkbox"/> <b>Mail</b>	<input type="checkbox"/> <b>UPS</b>	<input type="checkbox"/> <b>Website Address</b>

This Addendum will become part of the Contract Documents. The Contractor shall promptly inform subcontractors and all others performing or supplying any of the Work of all relevant contents of this Addendum. In case of conflicting provisions with previous addenda or communications, provisions in this Addendum supersede only those conflicting issues. It is the responsibility of the Contractor to notify all subcontractors from whom it accepts bids of all changes in the drawings and specifications covering this project. Receipt shall be acknowledged by inserting the addendum number and its date in the bid form.

<b>Distribution</b>	WCU, Gensler		
<b>Prepared by Gensler by</b>	Ariadne Cerritelli	<b>Date Signed</b>	11/30/2021

## Instructions / Description / References / Dates

Addendum 02 forms a part of the Contract Documents for the above referenced project. The following specifications are revised to capture the questions in RF11. The following drawings are added and revised to capture the questions in RF11, updated door frame and hardware, and added game clock scoreboard.

### SPECIFICATIONS

The following specifications are new and issued herewith:

Attachment #1: 102113 - Toilet Compartments

The following specifications are revised and issued herewith:

000022 Proposal:

Attachment #2: 000022 Form of Proposal

The following specifications are deleted from the project scope:

No deleted specifications

### DRAWINGS

The following drawings are new and issued herewith:

Attachment # 3: 211130\_WCU Addendum 02 Drawings

I1.110 - INTERIOR ELEVATIONS @ SHOWERS

The following drawings are revised and issued herewith, dated November 30, 2021:

Attachment # 3: 211130\_WCU Addendum 02 Drawings

G0.00 - COVER

G1.01 - DRAWING INDEX, MAPS, PROJECT INFO, GRAPHIC SYMBOLS, & ABBREVIATIONS

G6.01 - DOOR ELEVATIONS, DOOR AND HARDWARE SCHEDULES

G6.02 - FINISH & EQUIPMENT SCHEDULE

D1.001 - DEMOLITION PLAN

I1.100 - ENLARGED PLAN, RCP & INTERIOR ELEVATIONS OF FILM ROOM

2020 K Street, NW  
Suite 200  
Washington DC 20006  
Tel: +1 202.721.5200  
Fax: +1 202.872.8587

# Addendum Number 02 continued

---

<b>Project</b>	Ramsey - Basketball Locker Room	<b>Date</b>	11/30/2021
----------------	---------------------------------	-------------	------------

---

<b>Project Location</b>	92 Catamount Road Cullowhee, NC 28723	<b>This is page</b>	2 of 2
-------------------------	--	---------------------	--------

---

- I1.101 - INTERIOR ELEVATIONS OF FILM ROOM
- I1.102 - ENLARGED PLAN, RCP & INTERIOR ELEVATIONS OF MEN'S LOUNGE
- I1.104 - ENLARGED PLAN, RCP & INTERIOR ELEVATIONS OF MEN'S LOCKER
- I1.106 - ENLARGED PLAN, RCP & INTERIOR ELEVATIONS OF WOMEN'S LOCKER AND LOUNGE
- I1.107 - INTERIOR ELEVATIONS OF WOMEN'S LOCKER AND LOUNGE
- I1.109 - ENLARGED PLAN, RCP & INTERIOR ELEVATIONS OF STORAGE
- I5.200 - MILLWORK DETAILS
- I5.201 - MILLWORK DETAILS
- I5.300 - FINISH & FLOOR TRANSITION DETAILS

The following drawings are deleted from the project scope:  
No deleted drawings

## **SUPPLEMENTAL INFORMATION**

The following supplemental Information are new and issued herewith, dated November 30, 2021:  
Attachment #4: 211130\_RFI1

**END OF ADDENDUM 01**

**Gensler**  
009.9478.000  
SCO #: 21-22998-01  
CIP #: 42029, item 305  
WCU#: 2020-006

November 30, 2021  
Addendum 02

**WCU Ramsey -  
Basketball Locker Room**  
Cullowhee, North  
Carolina

## TABLE OF CONTENTS

### DIVISION 00 - PROCUREMENT AND CONTRACTING REQUIREMENTS

SECTION 006000 - PROJECT FORMS

### DIVISION 01 - GENERAL REQUIREMENTS

SECTION 011000 - SUMMARY  
SECTION 011300 - DELEGATED DESIGN REQUIREMENTS  
SECTION 011400 - WORK RESTRICTIONS  
SECTION 012600 - CONTRACT MODIFICATION PROCEDURES  
SECTION 012613 - REQUESTS FOR INTERPRETATION (RFIS)  
SECTION 012900 - PAYMENT PROCEDURES  
SECTION 013100 - PROJECT MANAGEMENT AND COORDINATION  
SECTION 013200 - CONSTRUCTION PROGRESS DOCUMENTATION  
SECTION 013300 - SUBMITTAL PROCEDURES  
SECTION 014000 - QUALITY REQUIREMENTS  
SECTION 014200 - REFERENCES  
SECTION 015000 - TEMPORARY FACILITIES AND CONTROLS  
SECTION 016000 - PRODUCT REQUIREMENTS  
SECTION 017300 - EXECUTION  
SECTION 017329 - CUTTING AND PATCHING  
SECTION 017419 - CONSTRUCTION WASTE MANAGEMENT AND DISPOSAL  
SECTION 017700 - CLOSEOUT PROCEDURES

### DIVISION 02 - EXISTING CONDITIONS

SECTION 024119 - SELECTIVE DEMOLITION

### DIVISION 03 - CONCRETE

SECTION 035416 - HYDRAULIC CEMENT UNDERLAYMENT

### DIVISION 04 - MASONRY

NOT APPLICABLE

### DIVISION 05 - METALS

SECTION 054000 - COLD-FORMED METAL FRAMING  
SECTION 055000 - METAL FABRICATIONS  
SECTION 057000 - DECORATIVE METAL

**Gensler**

009.9478.000

SCO #: 21-22998-01

CIP #: 42029, item 305

WCU#: 2020-006

November 30, 2021

Addendum 02

**WCU Ramsey -**

**Basketball Locker Room**

Cullowhee, North

Carolina

**DIVISION 06 - WOOD, PLASTICS, AND COMPOSITES**

SECTION 061053 - MISCELLANEOUS ROUGH CARPENTRY

SECTION 064023 - INTERIOR ARCHITECTURAL WOODWORK

**DIVISION 07 - THERMAL AND MOISTURE PROTECTION**

SECTION 070180 - RETROFIT FIRE-RESISTIVE MATERIALS

SECTION 078413 - PENETRATION FIRESTOPPING

SECTION 079200 - JOINT SEALANTS

**DIVISION 08 - OPENINGS**

SECTION 081113 - HOLLOW METAL DOORS AND FRAMES

SECTION 081216 - INTERIOR ALUMINUM DOORS AND FRAMES

SECTION 083113 - ACCESS DOORS AND FRAMES

SECTION 087100 - DOOR HARDWARE

SECTION 088000 - GLAZING

**DIVISION 09 - FINISHES**

SECTION 092216 - NON-STRUCTURAL METAL FRAMING

SECTION 092900 - GYPSUM BOARD

SECTION 093000 - TILING

SECTION 095423 - LINEAR FELT CEILINGS

SECTION 095446 - FABRIC-WRAPPED CEILING PANELS

SECTION 096513 - RESILIENT WALL BASE AND ACCESSORIES

SECTION 096813 - TILE CARPETING

SECTION 097713 - STRETCHED-FABRIC WALL SYSTEMS

SECTION 099123 - INTERIOR PAINTING

**DIVISION 10 - SPECIALTIES**

**SECTION 102113 - TOILET COMPARTMENTS**

SECTION 104400 - FIRE-PROTECTION SPECIALTIES

SECTION 105100 - LOCKERS

**DIVISION 11 - EQUIPMENT**

SECTION 113100 - PANTRY APPLIANCES

**DIVISION 12 - FURNISHINGS**

SECTION 126100 - FIXED AUDIENCE SEATING

**Gensler**  
009.9478.000  
SCO #: 21-22998-01  
CIP #: 42029, item 305  
WCU#: 2020-006

November 30, 2021  
Addendum 02

**WCU Ramsey -  
Basketball Locker Room**  
Cullowhee, North  
Carolina

## SECTION 102113 - TOILET COMPARTMENTS

### PART 1 -GENERAL

#### 1.1 SUMMARY

- A. Section includes [toilet compartments] [and] [screens] as follows:
1. Type: Solid-plastic, phenolic core.
  2. Compartment Style: Ceiling hung on existing supports.
  3. Screen Style: Wall hung.

#### 1.2 ACTION SUBMITTALS

- A. Product Data: For each product indicated.
- B. Shop Drawings: Include plans, elevations, sections, details of installation, and attachments to other Work.
- C. Samples: For each exposed finish and for each color and pattern required.

### PART 2 -PRODUCTS

#### 2.1 MANUFACTURERS

- A. Manufacturers: Subject to compliance with requirements, provide products by one of the following:
1. Phenolic Core, Solid Plastic:
    - a. Accurate Partitions Corporation.
    - b. Bradley Corporation.
    - c. Capital Partitions, Inc.
    - d. Bobrick Washroom Equipment, Inc.
    - e. General Partitions Manufacturing Corporation.
    - f. Global Steel Products Corporation.
    - g. Metpar Corporation.

#### 2.2 MATERIALS

- A. Panel, Pilaster, and Door Material:

**Gensler**  
009.9478.000  
SCO #: 21-22998-01  
CIP #: 42029, item 305  
WCU#: 2020-006

November 30, 2021  
Addendum 02

**WCU Ramsey -  
Basketball Locker Room**  
Cullowhee, North  
Carolina

1. Solid-Plastic, Phenolic Core: Solid phenolic core with melamine facing on both sides, fused to substrate without visible glue line or seam. Provide units with eased edges and with minimum 3/4 inch thick doors and pilasters and minimum 1/2 inch thick panels and screens.

a. Color: **White**, as selected from manufacturer's full range.

B. Stirrup Brackets: Manufacturer's standard.

### 2.3 ACCESSORIES

A. Hardware and Accessories: Manufacturer's standard design, heavy-duty operating hardware and accessories.

1. Material: Chrome-plated zamac, **or** clear-anodized aluminum.
2. Hinges: Manufacturer's standard integral hinge for solid-polymer doors.
3. Latch and Keeper: Manufacturer's standard surface-mounted latch unit designed for emergency access and with combination rubber-faced door strike and keeper. Provide units that comply with regulatory requirements for accessibility at compartments designated as accessible.
4. Coat Hook: Manufacturer's standard combination hook and rubber-tipped bumper, sized to prevent in-swinging door from hitting compartment-mounted accessories.
5. Door Bumper: Manufacturer's standard rubber-tipped bumper at out-swinging doors.
6. Door Pull: Manufacturer's standard unit at out-swinging doors that complies with regulatory requirements for accessibility. Provide units on both sides of doors at compartments designated as accessible.

B. Overhead Bracing: Manufacturer's standard continuous, extruded-aluminum head rail with antigrip profile and in manufacturer's standard finish.

C. Anchorages and Fasteners: Manufacturer's standard exposed fasteners of stainless steel or chrome-plated steel or brass, finished to match the items they are securing, with theft-resistant-type heads. Provide sex-type bolts for through-bolt applications. For concealed anchors, use stainless steel, hot-dip galvanized steel, or other rust-resistant, protective-coated steel.

### 2.4 FABRICATION

A. Toilet Compartments: Ceiling hung.

B. Urinal Screens: Wall hung.

C. Solid-Plastic, Polymer-Resin Units: Provide aluminum heat-sink strips at exposed bottom edges of panels and doors.

**Gensler**  
009.9478.000  
SCO #: 21-22998-01  
CIP #: 42029, item 305  
WCU#: 2020-006

November 30, 2021  
Addendum 02

**WCU Ramsey -  
Basketball Locker Room**  
Cullowhee, North  
Carolina

- D. Doors: Unless otherwise indicated, 24 inch wide in-swinging doors for standard toilet compartments and 36 inch wide out-swinging doors with a minimum 32 inch wide clear opening for compartments indicated to be accessible to people with disabilities.
- E. Door Hardware: Stainless steel. Provide units that comply with accessibility requirements of authorities having jurisdiction at compartments indicated to be accessible to people with disabilities.
  - 1. Hinges: Self-closing type, adjustable to hold door open at any angle up to 90 degrees.
  - 2. Latches and Keepers: Surface-mounted unit designed for emergency access and with combination rubber-faced door strike and keeper. Provide units that comply with accessibility requirements of authorities having jurisdiction at compartments indicated to be handicapped accessible.
  - 3. Coat Hook: Combination hook and rubber-tipped bumper, sized to prevent door from hitting compartment-mounted accessories.
  - 4. Door Bumper: Rubber-tipped bumpers at out-swinging doors or entrance screen doors.
  - 5. Door Pull: Provide at out-swinging doors. Provide units on both sides of doors at compartments indicated to be accessible to people with disabilities.

### **PART 3 -EXECUTION**

#### **3.1 INSTALLATION**

- A. Install units rigid, straight, level, and plumb, with not more than 1/2 inch between pilasters and panels and not more than 1 inch between panels and walls. Provide brackets, pilaster shoes, bracing, and other components required for a complete installation. Use theft-resistant exposed fasteners finished to match hardware. Use sex-type bolts for through-bolt applications.
  - 1. Brackets: Align brackets at pilasters with brackets at walls. Locate wall brackets so holes for wall anchors occur in masonry or tile joints.
  - 2. Set hinges on in-swinging doors to hold open approximately 30 degrees from closed position when unlatched. Set hinges on out-swinging doors and swing doors in entrance screens to return to fully closed position.

**END OF SECTION 102113**

# FORM OF PROPOSAL

Project: Ramsey – Basketball Locker Room Renovation Contract: \_\_\_\_\_

Western Carolina University Bidder: \_\_\_\_\_

SCO ID No.: 21-22998-02A Date: \_\_\_\_\_

The undersigned, as bidder, hereby declares that the only person or persons interested in this proposal as principal or principals is or are named herein and that no other person than herein mentioned has any interest in this proposal or in the contract to be entered into; that this proposal is made without connection with any other person, company or parties making a bid or proposal; and that it is in all respects fair and in good faith without collusion or fraud. The bidder further declares that he has examined the site of the work and the contract documents relative thereto, and has read all special provisions furnished prior to the opening of bids; that he has satisfied himself relative to the work to be performed. The bidder further declares that he and his subcontractors have fully complied with NCGS 64, Article 2 in regards to E-Verification as required by Section 2.(c) of Session Law 2013-418, codified as N.C. Gen. Stat. § 143-129(j).

The Bidder proposes and agrees if this proposal is accepted to contract with the State of North Carolina through the Western Carolina University in the form of contract specified below, to furnish all necessary materials, equipment, machinery, tools, apparatus, means of transportation and labor necessary to complete the construction of

Ramsey Center Men’s and Women’s Basketball Locker Room and Video Room Renovations

in full in complete accordance with the plans, specifications and contract documents, to the full and entire satisfaction of the State of North Carolina, and the

(Western Carolina University, Facilities Management and Gensler Architecture, Design & Planning, P.C.)

with a definite understanding that no money will be allowed for extra work except as set forth in the General Conditions and the contract documents, for the sum of:

## SINGLE PRIME CONTRACT:

Base Bid: \_\_\_\_\_ Dollars(\$)

General Subcontractor:  
\_\_\_\_\_ Lic \_\_\_\_\_

Plumbing Subcontractor:  
\_\_\_\_\_ Lic \_\_\_\_\_

Mechanical Subcontractor:  
\_\_\_\_\_ Lic \_\_\_\_\_

Electrical Subcontractor:  
\_\_\_\_\_ Lic \_\_\_\_\_

GS143-128(d) requires all single prime bidders to identify their subcontractors for the above subdivisions of work. A contractor whose bid is accepted shall not substitute any person as subcontractor in the place of the subcontractor listed in the original bid, except (i) if the listed subcontractor's bid is later determined by the contractor to be non-responsible or non-responsive or the listed subcontractor refuses to enter into a contract for the complete performance of the bid work, or (ii) with the approval of the awarding authority for good cause shown by the contractor.



**ALTERNATES:**

Should any of the alternates as described in the contract documents be accepted, the amount written below shall be the amount to be "added to" or "deducted from" the base bid.

**GENERAL CONTRACT:**

Alternate No. G-1    *Lockers to be procured and installed by Contractor.*

(Add) (Deduct) \_\_\_\_\_ Dollars(\$) \_\_\_\_\_

Alternate No. G-2    *Broadloom inlay carpet for Men's Player Locker room 1422 and women's player locker room 1426.*

(Add) (Deduct) \_\_\_\_\_ Dollars(\$) \_\_\_\_\_

**PLUMBING CONTRACT:**

Alternate No. P-1    *Not Applicable to Bid Alternate.*

(Add) (Deduct) \_\_\_\_\_ Dollars(\$) \_\_\_\_\_

**HVAC CONTRACT:**

Alternate No. H-1    *Not Applicable to Bid Alternate.*

(Add) (Deduct) \_\_\_\_\_ Dollars(\$) \_\_\_\_\_

**ELECTRICAL CONTRACT:**

Alternate No. E-1    *Not Applicable to Bid Alternate.*

(Add) (Deduct) \_\_\_\_\_ Dollars (\$) \_\_\_\_\_

**UNIT PRICES**

Unit prices quoted and accepted shall apply throughout the life of the contract, except as otherwise specifically noted. Unit prices shall be applied, as appropriate, to compute the total value of changes in the base bid quantity of the work all in accordance with the contract documents.

**GENERAL CONTRACT:**

No. 1 Not Applicable to Bid. \_\_\_\_\_ (Unit)    Unit Price (\$) \_\_\_\_\_

**PLUMBING CONTRACT:**

No. 1 Not Applicable to Bid. \_\_\_\_\_ (Unit)    Unit Price (\$) \_\_\_\_\_

**HVAC CONTRACT:**

No. 1 Not Applicable to Bid. \_\_\_\_\_ (Unit)    Unit Price (\$) \_\_\_\_\_

**ELECTRICAL CONTRACT:**

No. 1 Not Applicable to Bid. (Unit) Unit Price (\$)\_\_\_\_\_

The bidder further proposes and agrees hereby to commence work under this contract on a date to be specified in a written order of the designer and shall fully complete all work thereunder within the time specified in the Supplementary General Conditions Article 23. Applicable liquidated damages amount is also stated in the Supplementary General Conditions Article 23.

**MINORITY BUSINESS PARTICIPATION REQUIREMENTS**

Provide with the bid - Under GS 143-128.2(c) the undersigned bidder shall identify **on its bid** (Identification of Minority Business Participation Form) the minority businesses that it will use on the project with the total dollar value of the bids that will be performed by the minority businesses. **Also** list the good faith efforts (Affidavit **A**) made to solicit minority participation in the bid effort.

**NOTE:** A contractor that performs all of the work with its own workforce may submit an Affidavit (**B**) to that effect in lieu of Affidavit (**A**) required above. The MB Participation Form must still be submitted even if there is zero participation.

After the bid opening - The Owner will consider all bids and alternates and determine the lowest responsible, responsive bidder. Upon notification of being the apparent low bidder, the bidder shall then file within 72 hours of the notification of being the apparent lowest bidder, the following:

An Affidavit (**C**) that includes a description of the portion of work to be executed by minority businesses, expressed as a percentage of the total contract price, which is equal to or more than the 10% goal established. This affidavit shall give rise to the presumption that the bidder has made the required good faith effort and Affidavit **D** is not necessary

\* **OR** \*

If less than the 10% goal, Affidavit (**D**) of its good faith effort to meet the goal shall be provided. The document must include evidence of all good faith efforts that were implemented, including any advertisements, solicitations and other specific actions demonstrating recruitment and selection of minority businesses for participation in the contract.

**Note:** Bidders must always submit **with their bid** the Identification of Minority Business Participation Form listing all MB contractors, vendors and suppliers that will be used. If there is no MB participation, then enter none or zero on the form. Affidavit A **or** Affidavit B, as applicable, also must be submitted with the bid. Failure to file a required affidavit or documentation with the bid or after being notified apparent low bidder is grounds for rejection of the bid.

**Proposal Signature Page**

The undersigned further agrees that in the case of failure on his part to execute the said contract and the bonds within ten (10) consecutive calendar days after being given written notice of the award of contract, the certified check, cash or bid bond accompanying this bid shall be paid into the funds of the owner's account set aside for the project, as liquidated damages for such failure; otherwise the certified check, cash or bid bond accompanying this proposal shall be returned to the undersigned.

Respectfully submitted this day of \_\_\_\_\_

\_\_\_\_\_  
(Name of firm or corporation making bid)

WITNESS:

\_\_\_\_\_  
(Proprietorship or Partnership)

By: \_\_\_\_\_  
Signature

Name: \_\_\_\_\_  
Print or type

Title \_\_\_\_\_  
(Owner/Partner/Pres./V.Pres)

Address \_\_\_\_\_

ATTEST:

By: \_\_\_\_\_

Title: \_\_\_\_\_  
(Corp. Sec. or Asst. Sec. only)

License No. \_\_\_\_\_

Federal I.D. No. \_\_\_\_\_

Email Address: \_\_\_\_\_

(CORPORATE SEAL)

Addendum received and used in computing bid:

Addendum No. 1 \_\_\_\_\_ Addendum No. 3 \_\_\_\_\_ Addendum No. 5 \_\_\_\_\_ Addendum No. 7 \_\_\_\_\_

Addendum No. 2 \_\_\_\_\_ Addendum No. 4 \_\_\_\_\_ Addendum No. 6 \_\_\_\_\_ Addendum No. 8 \_\_\_\_\_





## WESTERN CAROLINA UNIVERSITY

92 Catamount Road  
Cullowhee, NC 28723

### Gensler

2020 K St NW  
Washington, DC 20006  
United States

Tel (202) 721-5200  
Fax +1 202.872.8587



### MEP ENGINEERS

1927 South Tryon Street  
Suite 300  
Charlotte, NC 28203  
Tel 704.338.1292

# WCU RAMSEY - BASKETBALL LOCKER ROOM

SCO ID: 21-22998-01

CIP: 42029

ITEM: 305

WCU PROJECT #: 2020-006

## ADDENDUM 02

11/30/2021




# ABBREVIATIONS


Table of abbreviations for construction and architectural terms, including AND, ACCESS, ADJ, AFF, etc.

# GRAPHIC SYMBOLS (CONT.)


## REFLECTED CEILING

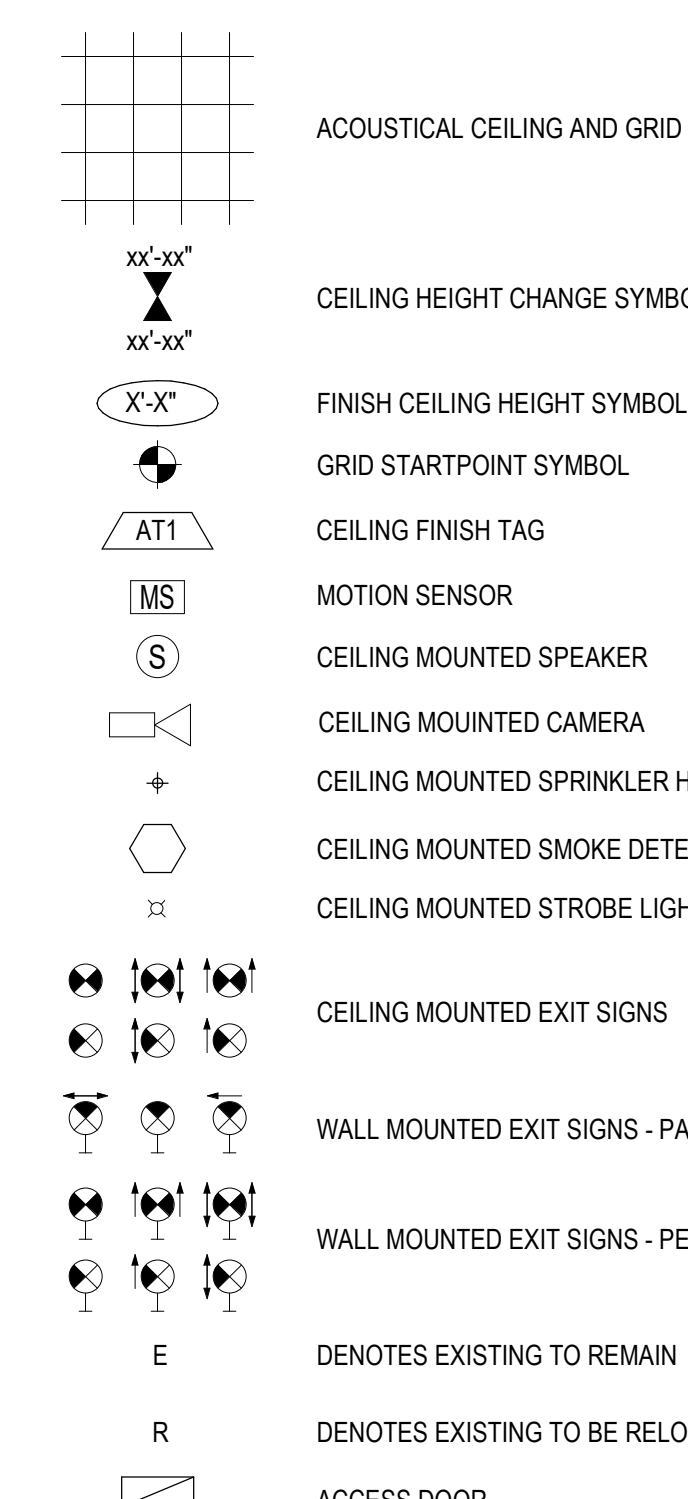

## LIGHT FIXTURES




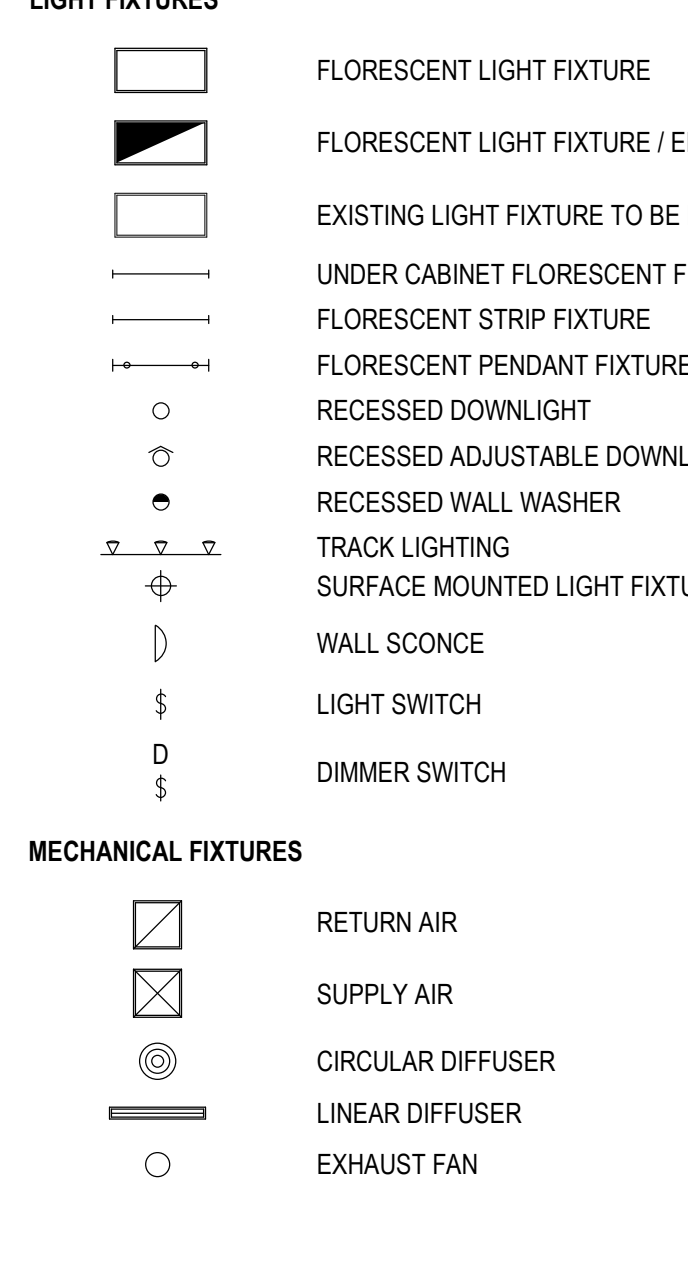


## MECHANICAL FIXTURES

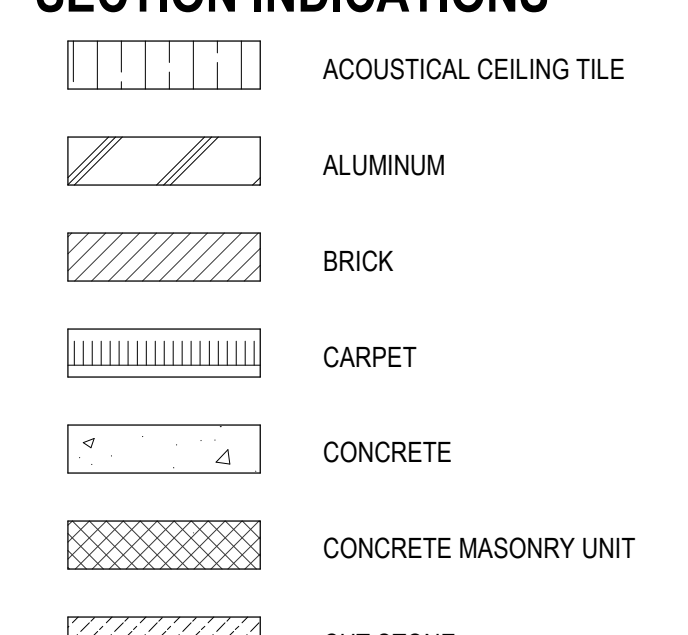


# GRAPHIC SYMBOLS


## CONSTRUCTION

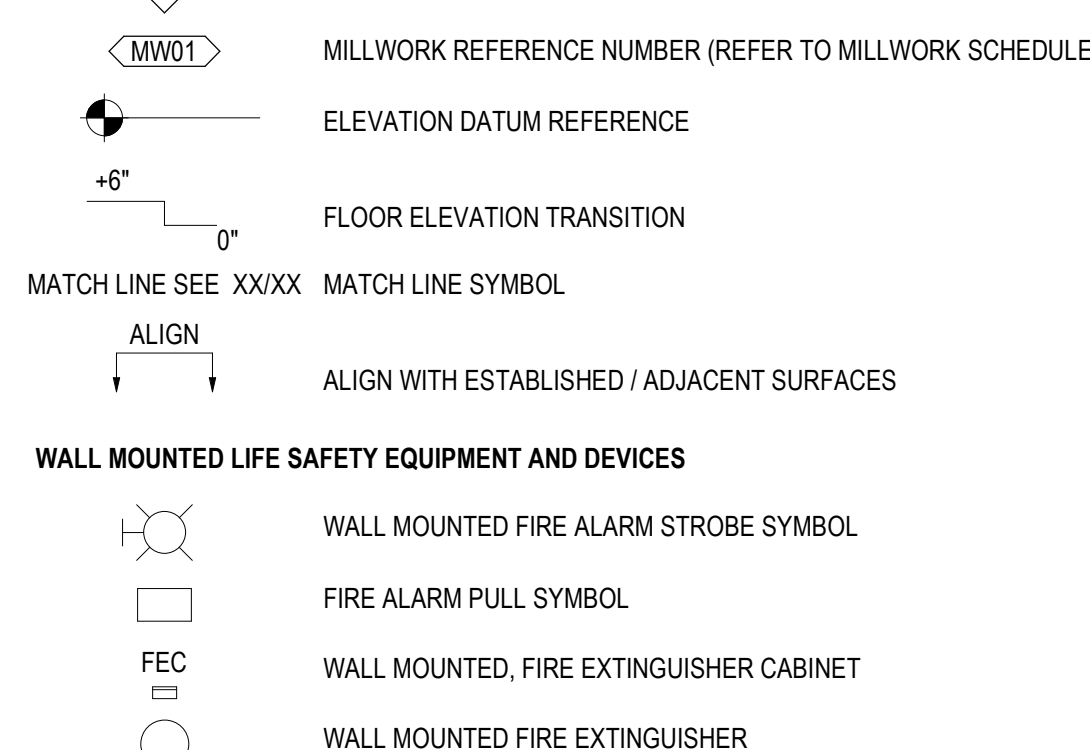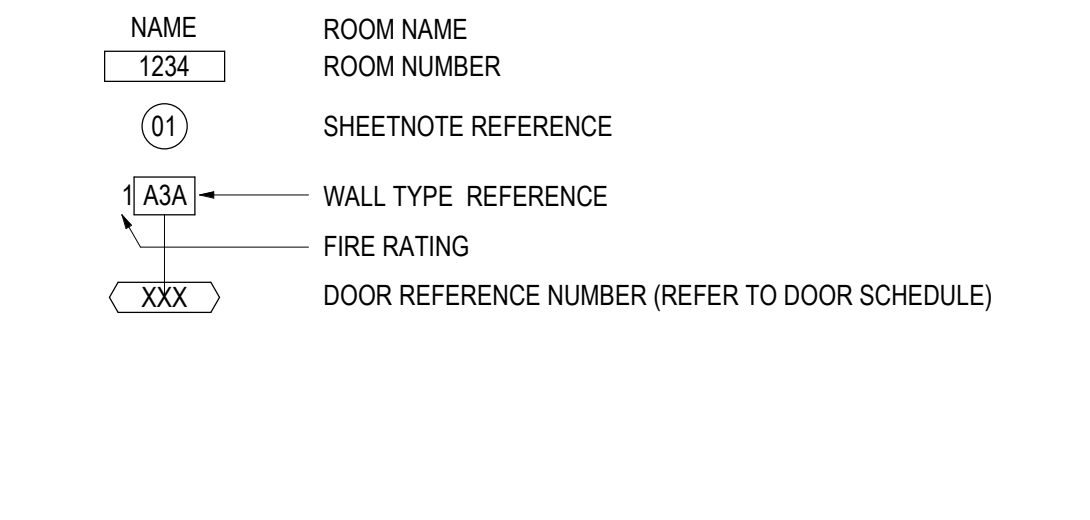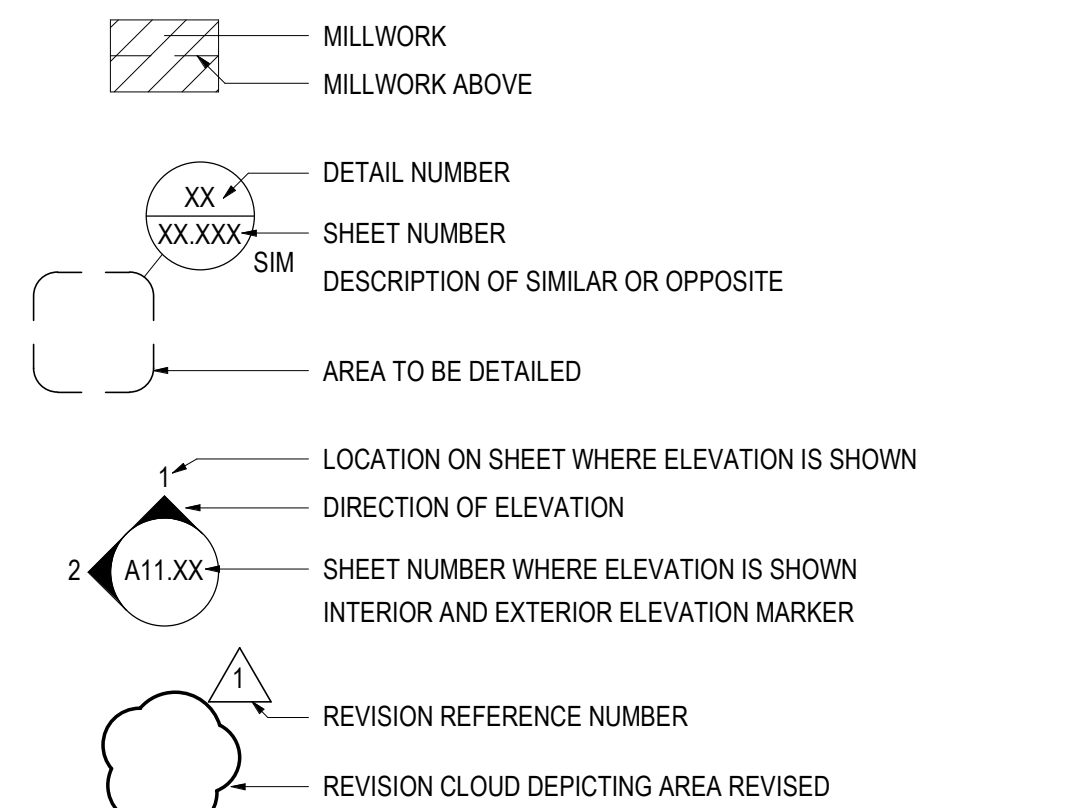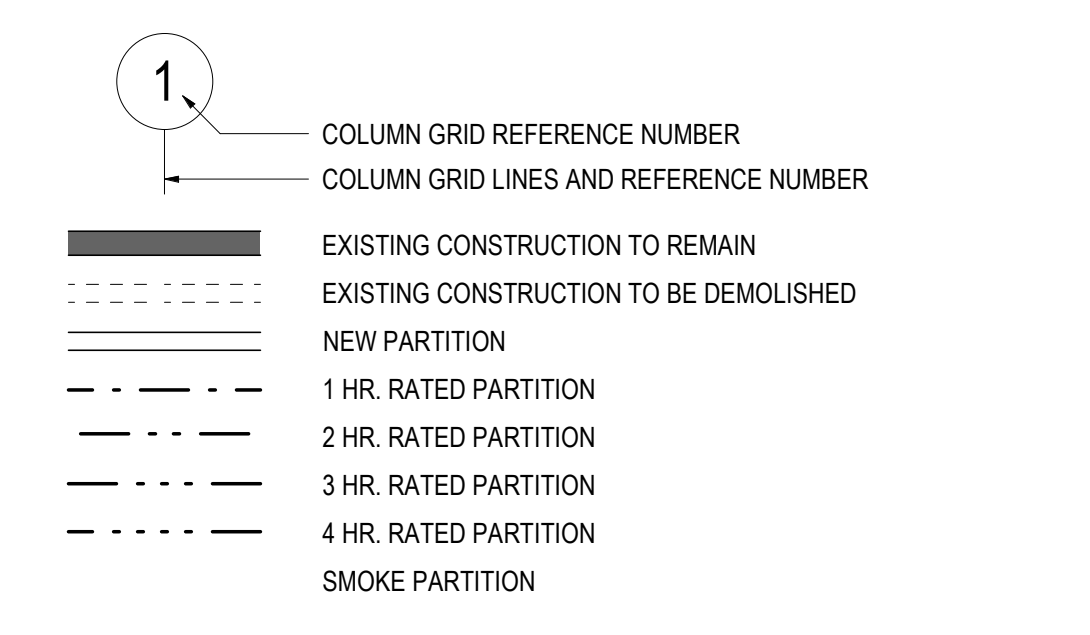


## FINISH

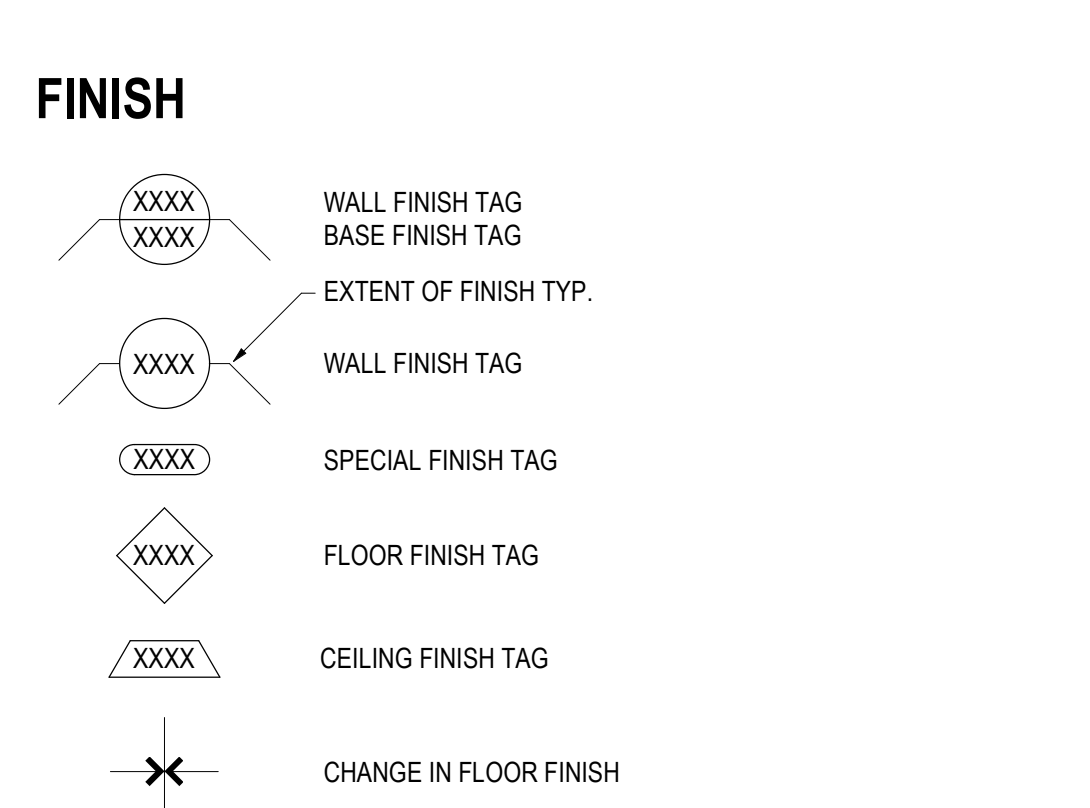


## ELEVATION INDICATION

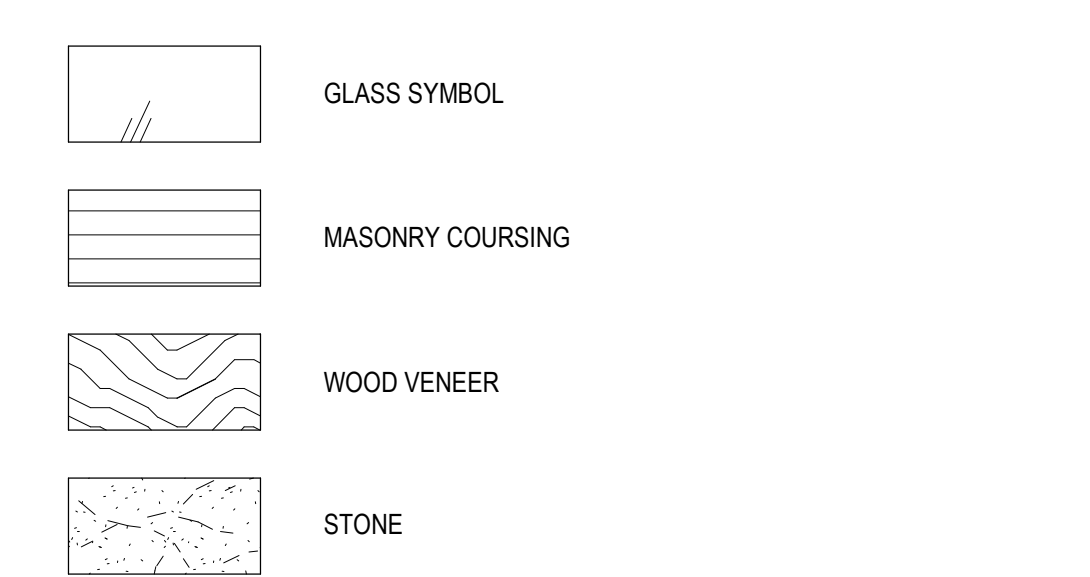

# VICINITY MAP

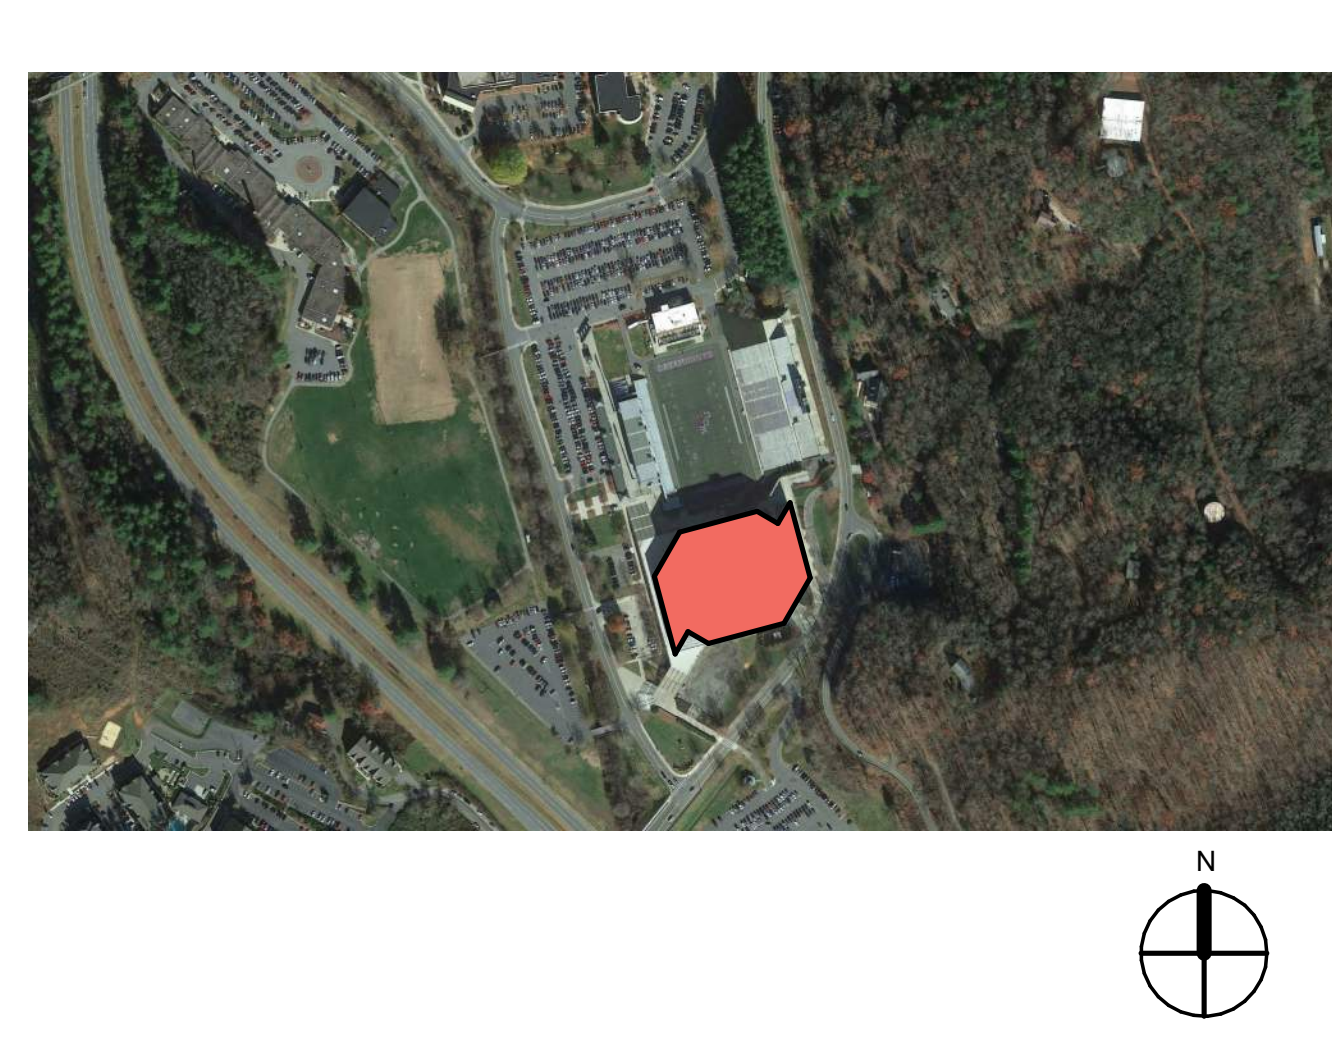

# LOCATION MAP

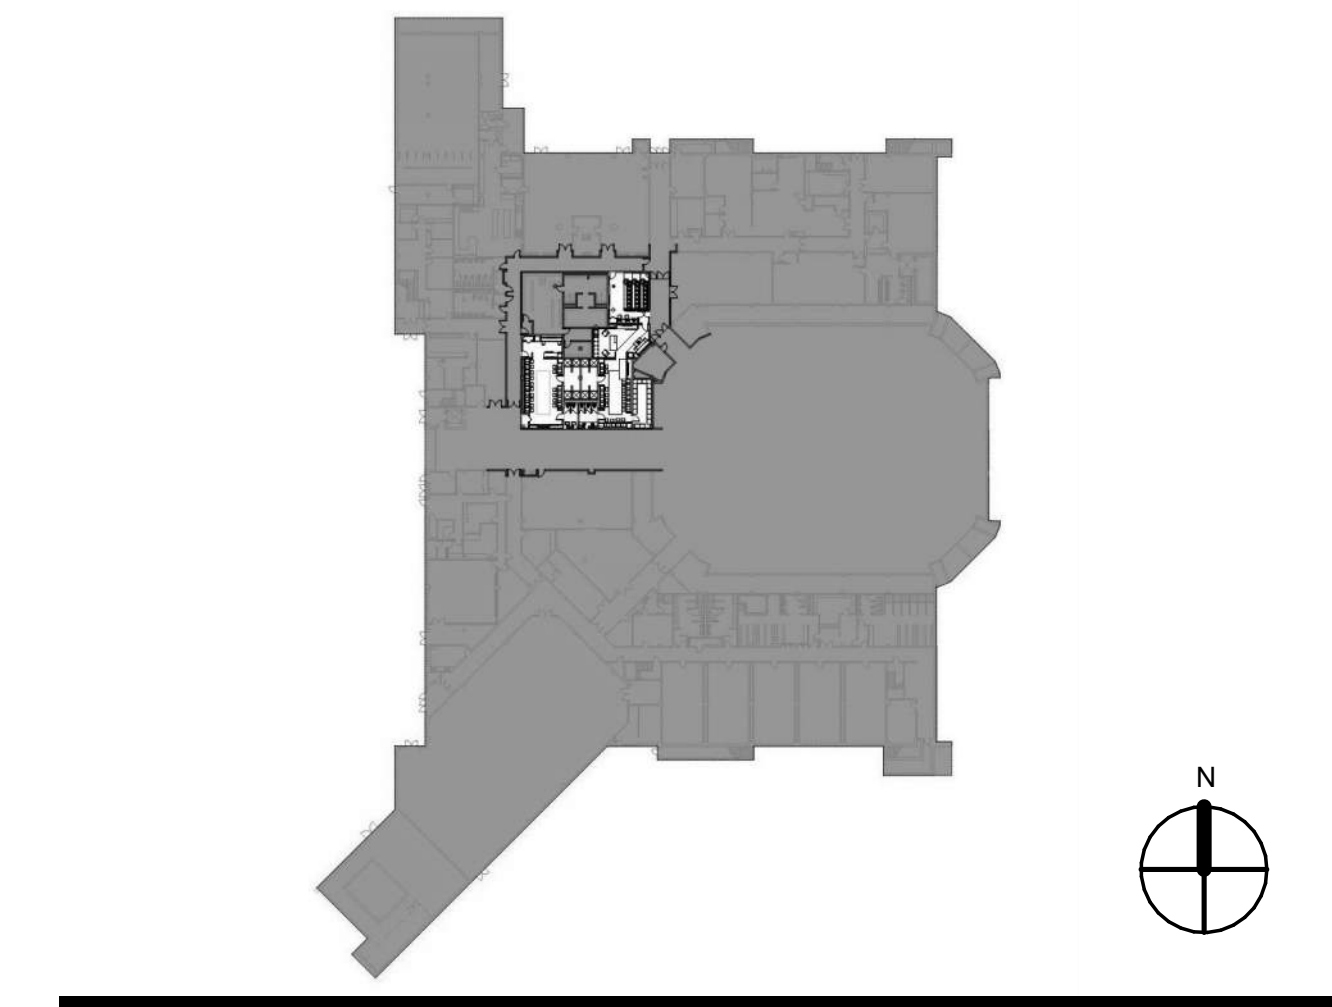

# PROJECT DESCRIPTION

FOLLOWING OUTLINES THE SCOPE OF WORK REQUIRED FOR THE RENOVATION OF THE EXISTING MEN'S AND WOMEN'S BASKETBALL LOCKER ROOM AREAS AS WELL AS SEVERAL AUXILIARY SPACES.

# AREA OF WORK

Table with columns: Space Type, Room Description, SF, Comments, Level. Lists program spaces like DATA ROOM, MEN'S RESTROOM, etc.

# PROJECT SCOPE

THE SCOPE OF WORK INCLUDES RENOVATION WORK TO THE MEN'S AND WOMEN'S BASKETBALL OPS AREA INCLUDING LOCKER ROOM, LOUNGE, FILM ROOM, AND AUXILIARY SPACES.

# SHEET INDEX

Table with columns: Sheet Number, Sheet Name, Current Revision Description, Current Revision Date.

Table listing sheet numbers and titles such as COVER, APPENDIX B, DRAWING INDEX, etc.

## DEMOLITION

Table listing demolition sheets like D1.001 DEMOLITION PLAN.

## ARCHITECTURAL

Table listing architectural sheets like A1.000 OVERALL BUILDING PLAN, A1.001 CONSTRUCTION PLAN, etc.

## FIRE PROTECTION

Table listing fire protection sheets like FP1.101 FIRE PROTECTION LEGEND.

## PLUMBING

Table listing plumbing sheets like P1.101 PLUMBING LEGEND.

## MECHANICAL

Table listing mechanical sheets like M0.001 MECHANICAL LEGEND, M1.101 MECHANICAL DEMOLITION PLAN, etc.

## ELECTRICAL

Table listing electrical sheets like E1.001 ELECTRICAL NOTES & LEGENDS, E1.101 ELECTRICAL DEMOLITION PLAN, etc.

## TECHNOLOGY

Table listing technology sheets like T1.101 TECHNOLOGY, T1.102 TECHNOLOGY, etc.



92 Catamount Road, Cullowhee, NC 28723

Gensler logo and contact information: 2020 K St NW, Washington, DC 20006, United States.

optima engineering logo and contact information: 1927 South Tryon Street, Suite 300, Charlotte, NC 28203, Tel 704.338.1292

MEP ENGINEERS logo and contact information: 1927 South Tryon Street, Suite 300, Charlotte, NC 28203, Tel 704.338.1292

SCO ID: 21-22998-01, CIP: 42029

Table with columns: Date, Description. Lists revision dates and descriptions.

Seal / Signature

Project Name: RAMSEY - BASKETBALL LOCKER ROOM RENOVATION, Project Number: 009.9478.000, Description: DRAWING INDEX, MAPS, PROJECT INFO, GRAPHIC SYMBOLS, & ABBREVIATIONS

Scale: 12" = 1'-0"

G1.01




**DOOR, FRAME AND HARDWARE SCHEDULE**

DOOR SCHEDULE													
DOOR	DOOR TYPE	ROOM NAME	WIDTH	HEIGHT	THICKNESS	FRAME MATERIAL	FRAME FINISH	PANEL MATERIAL	PANEL FINISH	FIRE RATING	HARDWARE TYPE	STC RATING	COMMENTS
1401A	F	FILM ROOM	3'-0"	7'-0"	0'-1 3/4"	HM	PAINT TO MATCH ADJACENT PARTITIONS	HM/GL	GL01 WITH FROSTED FILM	60	05	-	NEW DOOR AND FRAME WITHIN EXISTING OPENING.
1401B	C	FILM ROOM	3'-0"	7'-0"	0'-1 3/4"	HM	PAINT TO MATCH ADJACENT PARTITIONS	HM	PT01	60	01	50-60	
1403	C	MENS PLAYER LOUNGE	3'-0"	7'-0"	0'-1 3/4"	HM	PAINT TO MATCH ADJACENT PARTITIONS	HM	PT01	60	01	50-60	REUSE AD-200 PUSHBUTTON LOCK CURRENTLY ON EXISTING DOOR.
1420	A	STORAGE	3'-0"	7'-0"	0'-1 3/4"	HM	PAINT TO MATCH ADJACENT PARTITIONS	HM	PT01	-	01	-	NEW DOOR AND FRAME WITHIN EXISTING OPENING; REUSE CORBIN KEY LOCK CURRENTLY ON EXISTING DOOR.
1423	E	WOMENS SHOWER	3'-0"	7'-0"	0'-1 3/4"	HM	PAINT TO MATCH ADJACENT PARTITIONS	HM/GL	GL01 WITH FROSTED FILM	-	03	-	NEW DOOR AND FRAME WITHIN EXISTING OPENING.
1423A	E	MENS SHOWER	3'-0"	7'-0"	0'-1 3/4"	HM	PAINT TO MATCH ADJACENT PARTITIONS	HM/GL	GL01 WITH FROSTED FILM	-	03	-	NEW DOOR AND FRAME WITHIN EXISTING OPENING.
1424	E	WOMENS RESTROOM	3'-0"	7'-0"	0'-1 3/4"	HM	PAINT TO MATCH ADJACENT PARTITIONS	HM/GL	GL01 WITH FROSTED FILM	-	03	-	NEW DOOR AND FRAME WITHIN EXISTING OPENING.
1424A	E	MENS RESTROOM	3'-0"	7'-0"	0'-1 3/4"	HM	PAINT TO MATCH ADJACENT PARTITIONS	HM/GL	GL01 WITH FROSTED FILM	-	03	-	NEW DOOR AND FRAME WITHIN EXISTING OPENING.
1425	D	STORAGE	3'-0"	7'-0"	0'-1 3/4"	HM	PAINT TO MATCH ADJACENT PARTITIONS	HM	PT01	-	04	-	
1427	B	WOMENS PLAYER LOUNGE	3'-0"	7'-0"	0'-1 3/4"	HM	PAINT TO MATCH ADJACENT PARTITIONS	HM	PT01	60	01	-	NEW DOOR AND FRAME WITHIN EXISTING OPENING; REUSE AD-200 PUSHBUTTON LOCK CURRENTLY ON EXISTING DOOR.
1428	D	STORAGE	3'-0"	7'-0"	0'-1 3/4"	HM	PAINT TO MATCH ADJACENT PARTITIONS	HM	PT01	-	04	-	EXISTING LOCK TO BE REUSED IN NEW DOOR.

**DOOR, FRAME AND HARDWARE SCHEDULE**

DOOR HARDWARE SCHEDULE																							
SET NO.	SET DESCRIPTION	HANGING DEVICE				SECURING DEVICE (ACTIVE LEAF)				OPERATING TRIM				CLOSING DEVICE				STOP OR HOLDER				COMMENTS	
		DESCRIPTION	MANUFACTURER / MODEL	FINISH	QTY.	DESCRIPTION	MANUFACTURER / MODEL	FINISH	QTY.	DESCRIPTION	MANUFACTURER / MODEL	FINISH	QTY.	DESCRIPTION	MANUFACTURER / MODEL	FINISH	QTY.	DESCRIPTION	MANUFACTURER / MODEL	FINISH	QTY.		
01	ENTRY DOORS	BUTT HINGES, HEAVY WEIGHT, BALL BEARING	HAGER BB1199	STAINLESS STEEL	2 SETS	ELECTRIC PUSH BUTTON COMBINATION LOCK AND LATCHSET	SCHLAGE AD-200/AD-201; C06 TRIM	STAINLESS STEEL						CLOSER, SURFACE MOUNTED	LCN 4011	STAINLESS STEEL	1	INTEGRAL STOP				1	KEYPAD; KEY OVERRIDE CORBIN
02	GENERAL DOORS	BUTT HINGES, HEAVY WEIGHT, BALL BEARING	HAGER BB1199	STAINLESS STEEL	2 SETS	CORBIN LOCKSET	CORBIN KEY LOCK	STAINLESS STEEL						CLOSER, SURFACE MOUNTED	LCN 4011	STAINLESS STEEL	1	INTEGRAL STOP				1	COORD LOCK WITH OWNER
03	WET AREA ENTRY DOORS	BUTT HINGES, HEAVY WEIGHT, BALL BEARING		STAINLESS STEEL	1								STRAIGHT ROD PULL, 48"		BLACK ANODIZED								NO LOCK
04	STORAGE DOUBLE DOORS	BUTT HINGES 4" X 3"	HAFELE 926.98.040	STAINLESS STEEL	3	SLIDO DOOR HANDLE	HAFELE SLIDO CLASSIC BI-FOLD 30 SET	STAINLESS STEEL	1					UPPER TRACK	HAFELE 940.43.929	UPPER TRACK ALUMINUM MILL	1	STOP BRACKET	HAFELE 407.58.020	ALUMINUM MIL	1		NO LOCK
05	FILM ROOM DOOR	BUTT HINGES, HEAVY WEIGHT, BALL BEARING		STAINLESS STEEL		ELECTRIC PUSH BUTTON COMBINATION LOCK AND LATCHSET	SCHLAGE AD-200/AD-201; C06 TRIM	STAINLESS STEEL					STRAIGHT ROD PULL, 48"		BLACK ANODIZED							1	KEYPAD; KEY OVERRIDE CORBIN

**DOOR TYPES**

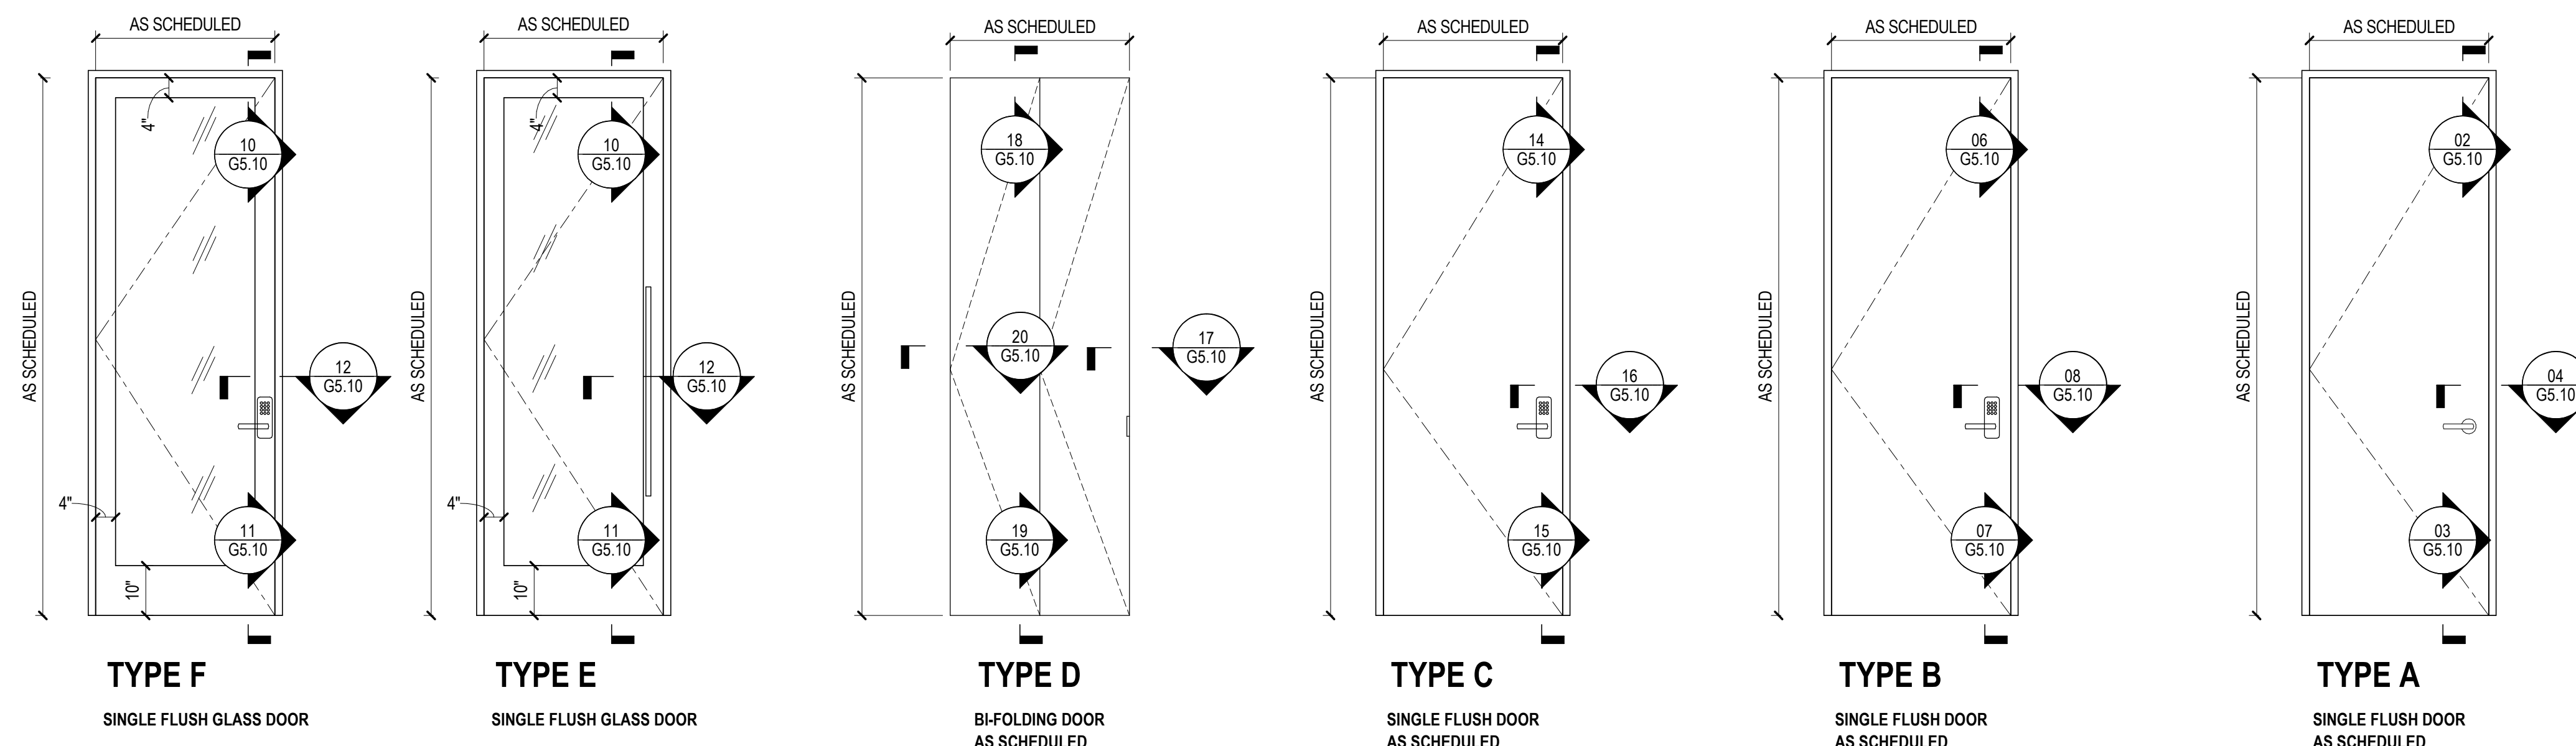

**SHEET NOTES**

**GENERAL NOTES**

- A. COORDINATE ALL KEYING REQUIREMENTS WITH TENANT.
- B. FOR RATED DOORS AND FRAMES, SEE DOOR SCHEDULE.
- C. ALL RATED DOORS, AND FRAMES THAT RECEIVE SECURITY DEVICES TO BE PRE-DRILLED IN FACTORY. FOR LOCATIONS AND SIZE OF HOLES TO BE DRILLED REFER TO SECURITY DRAWINGS.
- D. REFER TO PROJECT MANUAL DIVISION 08 FOR ALL FURTHER HARDWARE SET INFORMATION AND ALL HARDWARE FINISH INFORMATION.
- E. U.N.O. LOCATE DOORS 4" FROM FACE OF INSIDE CORNER OF PARTITION TO DOOR AND 8" FROM OUTSIDE CORNER OF PARTITION TO DOOR.
- F. U.N.O. ALL DOORS TO BE UNDERCUT TO PROVIDE 1/2" CLEAR SPACE BETWEEN THRESHOLD AND DOOR BOTTOM.
- G. LOCATE DOORS WITH CLOSERS NO LESS THAN 1'-6" TO EDGE OF DOOR AT PULL SIDE AND 1'-0" TO EDGE OF DOOR AT PUSH SIDE.
- H. LOCATE ALL SURFACE MOUNTED DOOR CLOSERS ON THE ROOM SIDE OF DOOR.
- I. U.N.O. ALL SOWD DOORS TO BE PAINTED TO MATCH ADJACENT PARTITION FINISH COLOR.
- J. U.N.O. ALL HARDWARE FINISH TO BE STAINLESS STEEL.

**ABBREVIATIONS**  
 ASD - MORTISED AUTOMATIC DOOR BOTTOM BMS - BALANCED MAGNETIC SWITCH  
 CR - CARD READER  
 CVR - CONCEALED VERTICAL ROD EXIT DEVICE FA - FIRE ALARM FR - FIRE RATED HD - HEAVY DUTY  
 HM - HOLLOW METAL LBR - LESS BOTTOM ROD REK - REQUEST-TO-EXIT  
 STC - SOUND TRANSMISSION COEFFICIENT



92 Catamount Road  
 Cullowhee, NC 28723

**Gensler**

2020 K St NW  
 Washington, DC 20006  
 United States  
 Tel (202) 721-5200  
 Fax +1 202.872.8587



MEP ENGINEERS  
 1927 South Tryon Street  
 Suite 300  
 Charlotte, NC 28203  
 Tel 704.338.1292

SCO ID: 21-22998-01  
 CIP: 42029

Seal / Signature

Project Name  
**RAMSEY - BASKETBALL LOCKER ROOM RENOVATION**  
 Project Number  
**009.9478.000**  
 Description  
 DOOR ELEVATIONS, DOOR AND HARDWARE SCHEDULES

Scale  
 1/2" = 1'-0"

**G6.01**



### SPECIALTY EQUIPMENT SCHEDULE

Specialty Equipment Schedule					
Family	Room Name	Room Number	Comments	Furnished/ Installed	
FILM ROOM					
AV Rack	FILM ROOM	1401	LOCKABLE AV STORAGE RACK	AV CONTRACTOR FURNISHED, AV CONTRACTOR INSTALLED	
1 Computer Monitor	FILM ROOM	1401	COMPUTER MONITOR	OFCI	
2 Game Clock1	FILM ROOM	1401	GAME CLOCK SCOREBOARD	OFCI	
1 Recycling Bin	FILM ROOM	1401	RECYCLING BIN	OFCI	
1 Television - Flat Panel	FILM ROOM	1401	TV MONITOR	AV CONTRACTOR FURNISHED, AV CONTRACTOR INSTALLED	
1 Trash Bin	FILM ROOM	1401	TRASH BIN	OFCI	
MENS PLAYER LOCKER ROOM					
Game Clock2	MENS PLAYER LOCKER ROOM	1422	GAME CLOCK SCOREBOARD	OFCI	
1 Television - Flat Panel	MENS PLAYER LOCKER ROOM	1422	TV MONITOR	AV CONTRACTOR FURNISHED, AV CONTRACTOR INSTALLED	
1 WCU Locker Closed	MENS PLAYER LOCKER ROOM	1422	PLAYER LOCKER	OFCI	
16 MENS PLAYER LOUNGE					
1 Microwave	MENS PLAYER LOUNGE	1403	UNDERCOUNTER MICROWAVE OVEN	OFCI	
1 Television - Flat Panel	MENS PLAYER LOUNGE	1403	TV MONITOR	AV CONTRACTOR FURNISHED, AV CONTRACTOR INSTALLED	
2 WOMENS PLAYER LOCKER ROOM					
Game Clock3	WOMENS PLAYER LOCKER ROOM	1426	GAME CLOCK SCOREBOARD	OFCI	
1 Television - Flat Panel	WOMENS PLAYER LOCKER ROOM	1426	TV MONITOR PROVIDE	AV CONTRACTOR FURNISHED, AV CONTRACTOR INSTALLED	
1 WCU Locker Closed	WOMENS PLAYER LOCKER ROOM	1426	PLAYER LOCKER	OFCI	
16 WOMENS PLAYER LOUNGE					
1 Microwave	WOMENS PLAYER LOUNGE	1427	UNDERCOUNTER MICROWAVE OVEN	OFCI	
1 Refrigerator - Soft Drink Display	WOMENS PLAYER LOUNGE	1427	REFRIGERATOR	OFCI	
1 Television - Flat Panel	WOMENS PLAYER LOUNGE	1427	TV MONITOR	AV CONTRACTOR FURNISHED, AV CONTRACTOR INSTALLED	

### FURNITURE SCHEDULE

Furniture Schedule					
Family	Room Name	Room Number	Description	Furnished/ Installed	
71.12.54.54	FILM ROOM	1401	Signature Back with 12S Seat on 4U Platform	OWNER FURNISHED, MANUFACTURER INSTALLED	
18 Chair - Folding	MENS PLAYER LOCKER ROOM	1422	Clarín Husseyseating 4010 Series	OFCI	
16 Chair - Folding	WOMENS PLAYER LOCKER ROOM	1426	Clarín Husseyseating 4010 Series	OFCI	
2 Chair - Task - Generic	FILM ROOM	1401	Ventilated Mesh Fabric	OFCI	
2 Coaslesse Pillows	MENS PLAYER LOUNGE	1403	1 x Pillow-Lumbar	OFCI	
2 Steelcase Coaslesse - Lagunitas - Table - Personal	MENS PLAYER LOUNGE	1403		OFCI	
2 Steelcase Coaslesse - Lagunitas - Table - Personal	WOMENS PLAYER LOUNGE	1427		OFCI	
3 Steelcase Coaslesse - Montara650 - Seating - Stool - Bar Height (1)	MENS PLAYER LOUNGE	1403		OFCI	
3 Steelcase Coaslesse - Montara650 - Seating - Stool - Bar Height (1)	WOMENS PLAYER LOUNGE	1427		OFCI	
6 Steelcase Coaslesse - Sistema - Fully Upholstered1	MENS PLAYER LOUNGE	1403		OFCI	
5 Steelcase Coaslesse - Sistema - Fully Upholstered - Bench1	MENS PLAYER LOUNGE	1403		OFCI	
1 Storage Shelves	STORAGE	1420	Open Shelving	OFCI	
17 Table - Coffee - Modern	MENS PLAYER LOUNGE	1403	Black Table Top	OFCI	

### FINISH MATERIALS LEGEND

**CP02**  
**09 88 16 BROADLOOM SHEET CARPET**  
 MANUFACTURER: EGE HIGHLINE 1100  
 TYPE: BROADLOOM  
 SIZE: 21' 4" X 6' 5"  
 COLOR: PURPLE BROADLOOM CARPET WITH CUSTOM INLAY; FONT TYPE DIAMANTE SERIAL XBOLD IN GOLD LETTERING.  
 LOCATION: WOMEN'S LOCKER  
 NOTE: OPTION 2 WOMEN'S LOCKER CUSTOM CARPET

#### LOCKERS

**SS01**  
**10 51 00 SOLID SURFACE LOCKERS**  
 MANUFACTURER: LOCKER MANUFACTURER TO PROVIDE OPTIONS, ARCHITECT TO APPROVE  
 COLOR: CORIAN CARBON CONCRETE  
 LOCATION: LOCKER ROOM ROOMS

#### UPHOLSTERY

#### UP01

**12 64 13 UPHOLSTERY**  
 MANUFACTURER: ANEZA  
 MATERIAL: 100% POLYURETHANE  
 COLOR: 7214-519 TAJ MAHAL  
 LOCATION: LOCKERS AND MEN'S BANQUETTE SEATING  
 PATTERN NAME: WOW

#### UP02

**12 64 13 UPHOLSTERY**  
 MANUFACTURER: ANEZA  
 MATERIAL: 100% NON-PHTHALATE VINYL  
 COLOR: 7225-12 ARTIST'S PURPLE  
 LOCATION: WOMEN'S BANQUETTE SEATING  
 PATTERN NAME: CROSSHATCH

### EQUIPMENT LEGEND NOTES

- 100 - APPLIANCES :** ITEMS INDICATED AS "N.I.C." SHALL BE PROVIDED BY OWNER & INSTALLED BY CONTRACTOR. ALL OTHER ITEMS SHALL BE PROVIDED & INSTALLED BY CONTRACTOR.
  - 200 - PLUMBING :** ALL ITEMS SHALL BE PROVIDED AND INSTALLED BY CONTRACTOR.
  - 300 - PLUMBING ACCESSORIES :** ALL ITEMS SHALL BE PROVIDED AND INSTALLED BY CONTRACTOR.
  - 400 - GENERAL OFFICE EQUIPMENT :** ALL ITEMS "N.I.C."; ITEMS SHALL BE PROVIDED BY OWNER & INSTALLED BY CONTRACTOR.
  - 500 - MISCELLANEOUS EQUIPMENT :** ITEMS INDICATED AS "N.I.C." SHALL BE PROVIDED BY OWNER & INSTALLED BY CONTRACTOR. ALL OTHER ITEMS SHALL BE PROVIDED & INSTALLED BY CONTRACTOR.
- \*MISCELLANEOUS EQUIPMENT INCLUDING TABLE TOP MICROPHONES, DISPLAYS ETC ARE NOT INCLUDED IN THIS SCHEDULE. REFER TO AV DRAWINGS.

### APPLIANCES EQUIPMENT LEGEND

- 100** DESCRIPTION: REFRIGERATOR  
 MANUFACTURER: TRUE RETAIL  
 MODEL NAME: FULL LENGTH MERCHANDISER  
 MODEL NUMBER: FLM 77-TSL01  
 FINISH/COLOR: STAINLESS STEEL  
 SIZE: 27" W x 79" H x 30-3/8" D  
 ELECTRICAL YES / NO :YES
- 101** DESCRIPTION: TRADITIONAL MICROWAVE  
 MANUFACTURER: FISHER & PAYKEL  
 MODEL NAME: SERIES 5 CONTEMPORARY  
 MODEL NUMBER: MO-24SS-3Y  
 FINISH/COLOR: STAINLESS STEEL  
 SIZE: 27" W x 79" H x 30-3/8" D  
 ELECTRICAL YES / NO :YES
- 102** DESCRIPTION: CEILING HUNG TOILET PARTITIONS  
 MODEL NAME: HADRIAN  
 FINISH/COLOR: PHENOLIC; WHITE  
 NOTE: REPLACE IN KIND/ LIKE TO EXISTING TOILETS

### PLUMBING ACCESSORIES LEGEND

- 200** DESCRIPTION: WALL-MOUNTED TOP SPUD FLUSHOMETER BOWL  
 MANUFACTURER: KOHLER  
 MODEL NAME: KINGSTON  
 MODEL NUMBER: K-4325-0  
 FINISH/COLOR: WHITE  
 ELECTRICAL YES / NO :NO  
 PLUMBING YES / NO :YES  
 NOTE: SLOAN 111-1-28-DFB FLUSH VALVE
- 201** DESCRIPTION: COUNTER MOUNTED BATHROOM SINK  
 MANUFACTURER: KOHLER  
 MODEL NAME: PENNINGTON  
 MODEL NUMBER: K-2196-4-0  
 FINISH/COLOR: WHITE  
 SIZE: 20" X 70" OVAL  
 ELECTRICAL YES / NO :NO  
 PLUMBING YES / NO :YES
- 202** DESCRIPTION: WALL-MOUNT/CONCEALED ARM CARRIER BATHROOM SINK WITH 4" CENTERSET FAUCET HOLES  
 MANUFACTURER: KOHLER  
 MODEL NAME: GREENWICH  
 MODEL NUMBER: K-2032-0  
 FINISH/COLOR: WHITE  
 SIZE: 20" X 18"  
 ELECTRICAL YES / NO :NO  
 PLUMBING YES / NO :YES
- 203** DESCRIPTION: BATTERY-POWERED DECK-MOUNTED LOW INTEGRATED BASE BODY FAUCET  
 MANUFACTURER: SLOAN  
 MODEL NAME: OPTIMA  
 MODEL NUMBER: EBF-650  
 FINISH/COLOR: BRUSHED STAINLESS  
 SIZE: 20" X 70" OVAL  
 ELECTRICAL YES / NO :YES  
 PLUMBING YES / NO :YES

### MISCELLANEOUS EQUIPMENT

- 400** DESCRIPTION: FIXED PLAYER SEATING  
 ELECTRICAL YES / NO :TBD  
 NOTE: PROVIDED & INSTALLED BY OWNER; G.C. TO COORDINATE W/ OWNER
- 401** DESCRIPTION: CUSTOM PLAYER LOCKER  
 FINISH/COLOR: REFER TO ELEVATIONS  
 SIZE: REFER TO PLANS  
 ELECTRICAL YES / NO :TBD
- 402** DESCRIPTION: GAME CLOCK SCOREBOARD  
 MANUFACTURER: DAKTRONICS, INC.  
 MODEL NAME: TI-2031/3031 LOCKER ROOM CLOCK  
 SIZE: REFER TO ELEVATIONS  
 ELECTRICAL YES / NO :YES  
 NOTE: FLUSH MOUNT METHOD; OFCI

### FINISH MATERIALS LEGEND

**RB02**  
**09 85 13 RESILIENT WALL BASE & ACCESSORIES**  
 DESCRIPTION: STAIR NOSING  
 MANUFACTURER: JOHNSSONITE  
 NUMBER: RCN-XX-B  
 COLOR: COLOR TO MATCH RB01  
 LOCATION: FILM ROOM RISERS

#### INTERIOR ARCHITECTURAL WOODWORK

**QS01**  
**06 40 23 INTERIOR ARCHITECTURAL WOODWORK**  
 NAME: SOLID SURFACE  
 MANUFACTURER: CORIAN  
 COLOR: CARBON CONCRETE  
 LOCATION: REFER TO ELEVATIONS

#### PAINT

#### PT01

**09 91 23 PAINTING**  
 MANUFACTURER: SHERWIN WILLIAMS  
 COLOR: WHITE  
 FINISH: EGGSHELL  
 LOCATION: GENERAL WALLS

#### PT02

**09 92 23 PAINTING**  
 MANUFACTURER: GC TO CHOOSE, ARCHITECT TO APPROVE  
 COLOR: MATCH EXISTING CONDITIONS  
 FINISH: MATCH EXISTING CONDITIONS  
 LOCATION: REFER TO ELEVATIONS

#### PT03

**09 91 23 PAINTING**  
 MANUFACTURER: SHERWIN WILLIAMS  
 COLOR: TO MATCH WCU CHARCOAL; RGB 52 52 52  
 FINISH: FLAT  
 LOCATION: FILM ROOM CEILING, LOCKER ROOM CEILINGS, PLAYERS LOUNGE CEILINGS & ALL EXPOSED MEP SYSTEMS  
 NOTE: DRY FALL PAINT @ ALL EXPOSED MECHANICAL, ELECTRICAL AND PLUMBING EQUIPMENT

#### PT04

**09 91 23 PAINTING**  
 MANUFACTURER: SHERWIN WILLIAMS  
 COLOR: WHITE  
 FINISH: FLAT  
 LOCATION: GYPSUM BOARD CEILINGS

#### PT05

**09 91 23 PAINTING**  
 MANUFACTURER: SHERWIN WILLIAMS  
 COLOR: TO MATCH FW02  
 FINISH: EGGSHELL  
 LOCATION: REFER TO ELEVATIONS

#### PT06

**09 91 23 PAINTING**  
 MANUFACTURER: SHERWIN WILLIAMS  
 COLOR: NEUTRAL GRAY  
 FINISH: EPOXY  
 LOCATION: STORAGE FLOOR

#### TILE

#### TL01

**09 30 00 TILING**  
 NAME: BOND PALLADIUM  
 MANUFACTURER: TILE BAR  
 TYPE: PORCELAIN MOSAIC  
 SIZE: 2"x2"  
 COLOR: WHITE  
 FINISH: MATTE  
 LOCATION: BATHROOM AND SHOWER FLOOR TILE

#### TL02

**09 30 00 TILING**  
 NAME: STACY GARCIA MADDOX FRAME  
 MANUFACTURER: TILE BAR  
 TYPE: CERAMIC WALL TILE  
 SIZE: 4"x8"  
 COLOR: WHITE  
 FINISH: MATTE  
 LOCATION: BATHROOM WALL TILE

#### TL03

**09 30 00 TILING**  
 NAME: MATRIX TRAPEZOID  
 MANUFACTURER: TILE BAR  
 SIZE: 10.24" x 24.5"  
 COLOR: WHITE  
 LOCATION: PAINTRY BACKSPLASH @ WOMEN'S AND MEN'S LOUNGE  
 TILE THICKNESS: PORCELAIN

#### TILE CARPETING

#### CO1

**09 88 16 TILE CARPETING**  
 NAME: KINETEX  
 MANUFACTURER: J + J FLOORING GROUP  
 TYPE: TILE CARPETING  
 SIZE: 24" X 24"  
 COLOR: INDEX: 2918  
 LOCATION: REFER TO PLANS  
 PATTERN NAME: NETWORK MODULAR 1842

#### CO2

**09 88 16 TILE CARPETING**  
 MANUFACTURER: J + J FLOORING GROUP  
 TYPE: TILE CARPETING  
 SIZE: 24" X 24"  
 COLOR: MORADO 1714  
 LOCATION: REFER TO PLANS  
 PATTERN NAME: POP 1816

#### CO3

**09 88 16 TILE CARPETING**  
 MANUFACTURER: J + J FLOORING  
 TYPE: TILE CARPETING  
 SIZE: 24" X 24"  
 COLOR: BLACK (BACK)  
 LOCATION: MEN'S LOCKER  
 NOTE: OPTION 1 - CUSTOM CARPET; WATERJET LETTERING INTO CARPET TILE (FONT TYPE DIAMANTE SERIAL XBOLD)

#### CO4

**09 88 16 TILE CARPETING**  
 MANUFACTURER: J + J FLOORING GROUP  
 TYPE: TILE CARPETING  
 SIZE: 24" X 24"  
 COLOR: MORADO 1714 POP 1816 (BACKGROUND) GOLD (LETTERS)  
 LOCATION: WOMEN'S LOCKER  
 NOTE: OPTION 1 - MEN'S AND WOMEN'S LOCKER CUSTOM CARPET; WATERJET LETTERING INTO CARPET TILE (FONT TYPE DIAMANTE SERIAL XBOLD)

#### SHEET CARPETING

**CP01**  
**09 88 16 BROADLOOM SHEET CARPET**  
 MANUFACTURER: EGE HIGHLINE 1100  
 TYPE: BROADLOOM  
 SIZE: 21' 4" X 6' 5"  
 COLOR: BLACK BROADLOOM CARPET WITH CUSTOM INLAY; FONT TYPE DIAMANTE SERIAL XBOLD IN PURPLE LETTERING TO MATCH CO2  
 LOCATION: MEN'S LOCKER  
 NOTE: OPTION 2 MEN'S LOCKER CUSTOM CARPET

### FINISH MATERIALS LIST

- AE## ATHLETIC EQUIPMENT, PLAYFIELD
  - AF## ACCESS FLOORING
  - CC## CAST IN PLACE CONCRETE
  - CL## CEILINGS, ACOUSTICAL PANEL
  - CL# CEILINGS, ACOUSTICAL METAL PANEL
  - CL## CEILINGS, STRETCHED-FABRIC SYSTEM
  - CL## CEILINGS, DECORATIVE FORMED METAL
  - CC## COATINGS, HIGH-PERFORMANCE
  - CO## COATINGS, ELASTOMERIC WATERPROOF
  - CP## CARPETING, TILE
  - CP## CARPETING, SHEET
  - CW## CURTAIN WALL, GLAZED ALUMINUM
  - DF## DECORATIVE FINISHING
  - ES## ENTRANCES AND STOREFRONTS, ALUMINUM FRAMED
  - ES## ENTRANCES AND STOREFRONTS, ALUMINUM FRAMED FOLDING
  - ES## ENTRANCES AND STOREFRONTS, ALL-GLASS
  - F## FLUID APPLIED RESINOUS FLOORING
  - FV## FABRIC WRAPPED PANELS
  - GF## GLAZING FILMS - DECORATIVE
  - GL## GLAZING
  - GL## GLAZING, DECORATIVE GLASS
  - IN## INTERIOR SPECIALTIES - TOILET COMPARTMENTS
  - IN## INTERIOR SPECIALTIES - METAL LOCKERS
  - L## LOUVERS, FIXED
  - M## MIRRORS
  - MT## METAL, DECORATIVE
  - MT## METAL COUNTERTOPS
  - MT## METAL WEATHERED STEEL PANEL
  - MT## METAL WALL PANEL SYSTEM, INTERIOR
  - PF## PLASTIC FABRICATIONS
  - PL## PLASTIC LAMINATE
  - PP## PLASTIC PANELING
  - PR## PROTECTION, WALL AND DOOR
  - P## PAINTING
  - PP## PAVERS
  - RS## RESILIENT WALL BASE AND ACCESSORIES
  - RS## RESILIENT SHEET FLOORING
  - RT## RESILIENT TILE FLOORING
  - SC## STONE COUNTERTOPS
  - SC## SIMULATED STONE COUNTERTOPS
  - SC## CONCRETE COUNTERTOPS
  - SF## STRETCHED-FABRIC WALL SYSTEMS
  - SO## SOLID SURFACING
  - ST## STONE TILING
  - ST## STONE FLOORING
  - ST## STONE FACING
  - TC## TRAFFIC COATING
  - TL## TILING
  - TR## RESINOUS MATRIX TERRAZZO FLOORING
  - UM## UNIT MASONRY
  - UP## UPHOLSTERY
  - WP## WALL PANELS
  - WB## WOOD BASE
  - WC## WALL COVERINGS
  - WD## WOOD
- NOTES:  
 1. ALL ITEMS LISTED ABOVE MAY NOT BE USED.  
 2. LOCATIONS NOTED IN SCHEDULE DO NOT INDICATE ALL LOCATIONS. SEE DRAWINGS FOR EXTENT OF WORK.

### FINISH MATERIALS LEGEND

#### FELT CEILINGS

#### CL01

**09 54 23 LINEAR METAL CEILINGS**  
 NAME: HEARTFELT SYSTEM  
 MANUFACTURER: HUNTER DOUGLAS ARCHITECTURAL FROM CERTAINTED  
 TYPE: 3 1/8" MODULE  
 COLOR: WHITE 7595F  
 LOCATION: FILM ROOM CEILING & LOCKER ROOM CEILINGS  
 NOTE: PROVIDE FACTORY FINISH BLACK SUSPENSION, CARRIER, AND VERTICAL SUPPORTS

#### CL02

**09 54 23 LINEAR METAL CEILINGS**  
 NAME: HEARTFELT SYSTEM  
 MANUFACTURER: HUNTER DOUGLAS ARCHITECTURAL FROM CERTAINTED  
 TYPE: 3 1/8" MODULE  
 COLOR: LIGHT GREY 7596F  
 LOCATION: FILM ROOM CEILING & LOCKER ROOM CEILINGS  
 NOTE: PROVIDE FACTORY FINISH BLACK SUSPENSION, CARRIER, AND VERTICAL SUPPORTS

#### GLASS

#### GL01

**08 80 00 GLAZING**  
 DESCRIPTION: LOW IRON GLASS  
 MANUFACTURER: GC TO CHOOSE, ARCHITECT TO APPROVE  
 TYPE: TEMPERED  
 FINISH: CLEAR, ARCHITECT TO APPROVE  
 LOCATION: DISPLAY CASE @ WOMEN'S LOUNGE  
 THICKNESS: 1/2"

#### DECORATIVE GLASS

#### DG01

**08 81 13 DECORATIVE GLASS GLAZING**  
 NAME: WALL2WALL  
 MANUFACTURER: CLARUS  
 COLOR: WHITE CBC - 101  
 LOCATION: REFER TO ELEVATIONS  
 THICKNESS: 4 MM CLARUS TEMPERED SAFETY WRITING GLASS  
 TILE THICKNESS: PORCELAIN

#### DG02

**08 81 13 DECORATIVE GLASS GLAZING**  
 NAME: WALL2WALL  
 MANUFACTURER: CLARUS  
 COLOR: WHITE CBC - 101; CUSTOM APPLIED FULL COURT GRAPHIC REFER TO ELEVATIONS  
 LOCATION: REFER TO ELEVATIONS  
 THICKNESS: 4 MM CLARUS TEMPERED SAFETY WRITING GLASS  
 NOTE: USE Z-CLIP ATTACHMENTS

#### FABRIC STRETCHED PANELS

#### FW01

**09 77 13 STRETCHED - FABRIC WALL SYSTEMS**  
 MANUFACTURER: CAMIRA  
 MATERIAL: BLAZER LITE FELT  
 COLOR: BLISS LTH48  
 LOCATION: REFER TO ELEVATIONS

#### FW02

**09 77 13 STRETCHED - FABRIC WALL SYSTEMS**  
 MANUFACTURER: CAMIRA  
 MATERIAL: BLAZER LITE FELT  
 COLOR: FAITH LTH8  
 LOCATION: REFER TO ELEVATIONS

#### INTERIOR ARCHITECTURAL WOODWORK

#### PL01

**06 40 23 INTERIOR ARCHITECTURAL WOODWORK**  
 NAME: PREMIUM PLASTIC LAMINATE  
 MANUFACTURER: FENIX  
 NUMBER: J0752  
 COLOR: GRIGIO ANTRIM  
 LOCATION: REFER TO ELEVATIONS

#### INTERIOR ARCHITECTURAL WOODWORK

#### MB01

**06 40 23 INTERIOR ARCHITECTURAL WOODWORK**  
 NAME: RECESSED METAL BASE  
 MATERIAL: STAINLESS STEEL  
 SIZE: 2-1/2" (REF TO DRAWINGS)  
 COLOR: WHITE  
 DETAIL #: 07 / IS.300  
 FLTCH: BRUSHED #4 SATIN

#### RESILIENT BASE

#### RB01

**09 85 13 RESILIENT WALL BASE & ACCESSORIES**  
 MANUFACTURER: ALL STATE  
 TYPE: STRAIGHT BASE  
 SIZE: 2-1/2" (REF TO DRAWINGS)  
 COLOR: COLOR TO MATCH PL01  
 THICKNESS: 1/8"



92 Catamount Road  
 Cullowhee, NC 28723

**Gensler**

2020 K St NW Washington, DC 20006 United States  
 Tel (202) 721-5200 Fax +1 202.872.8587



**MEP ENGINEERS**  
 1927 South Tryon Street Suite 300 Charlotte, NC 28203 Tel 704.338.1292

SCO ID: 21-22998-01  
 CIP: 42029

Date	Description
1 03/26/2021	DESIGN DEVELOPMENT - ISSUE FOR PRICING
2 04/19/2021	ISSUE FOR PERMIT
3 06/11/2021	ISSUE FOR PERMIT - RESUBMIT
4 10/18/2021	ISSUE FOR BID
6 11/30/2021	ADDENDUM 02

Seal / Signature

Project Name  
**RAMSEY - BASKETBALL LOCKER ROOM RENOVATION**


Project Number  
**009.9478.000**

Description  
**FINISH & EQUIPMENT SCHEDULE**

Scale

**G6.02**



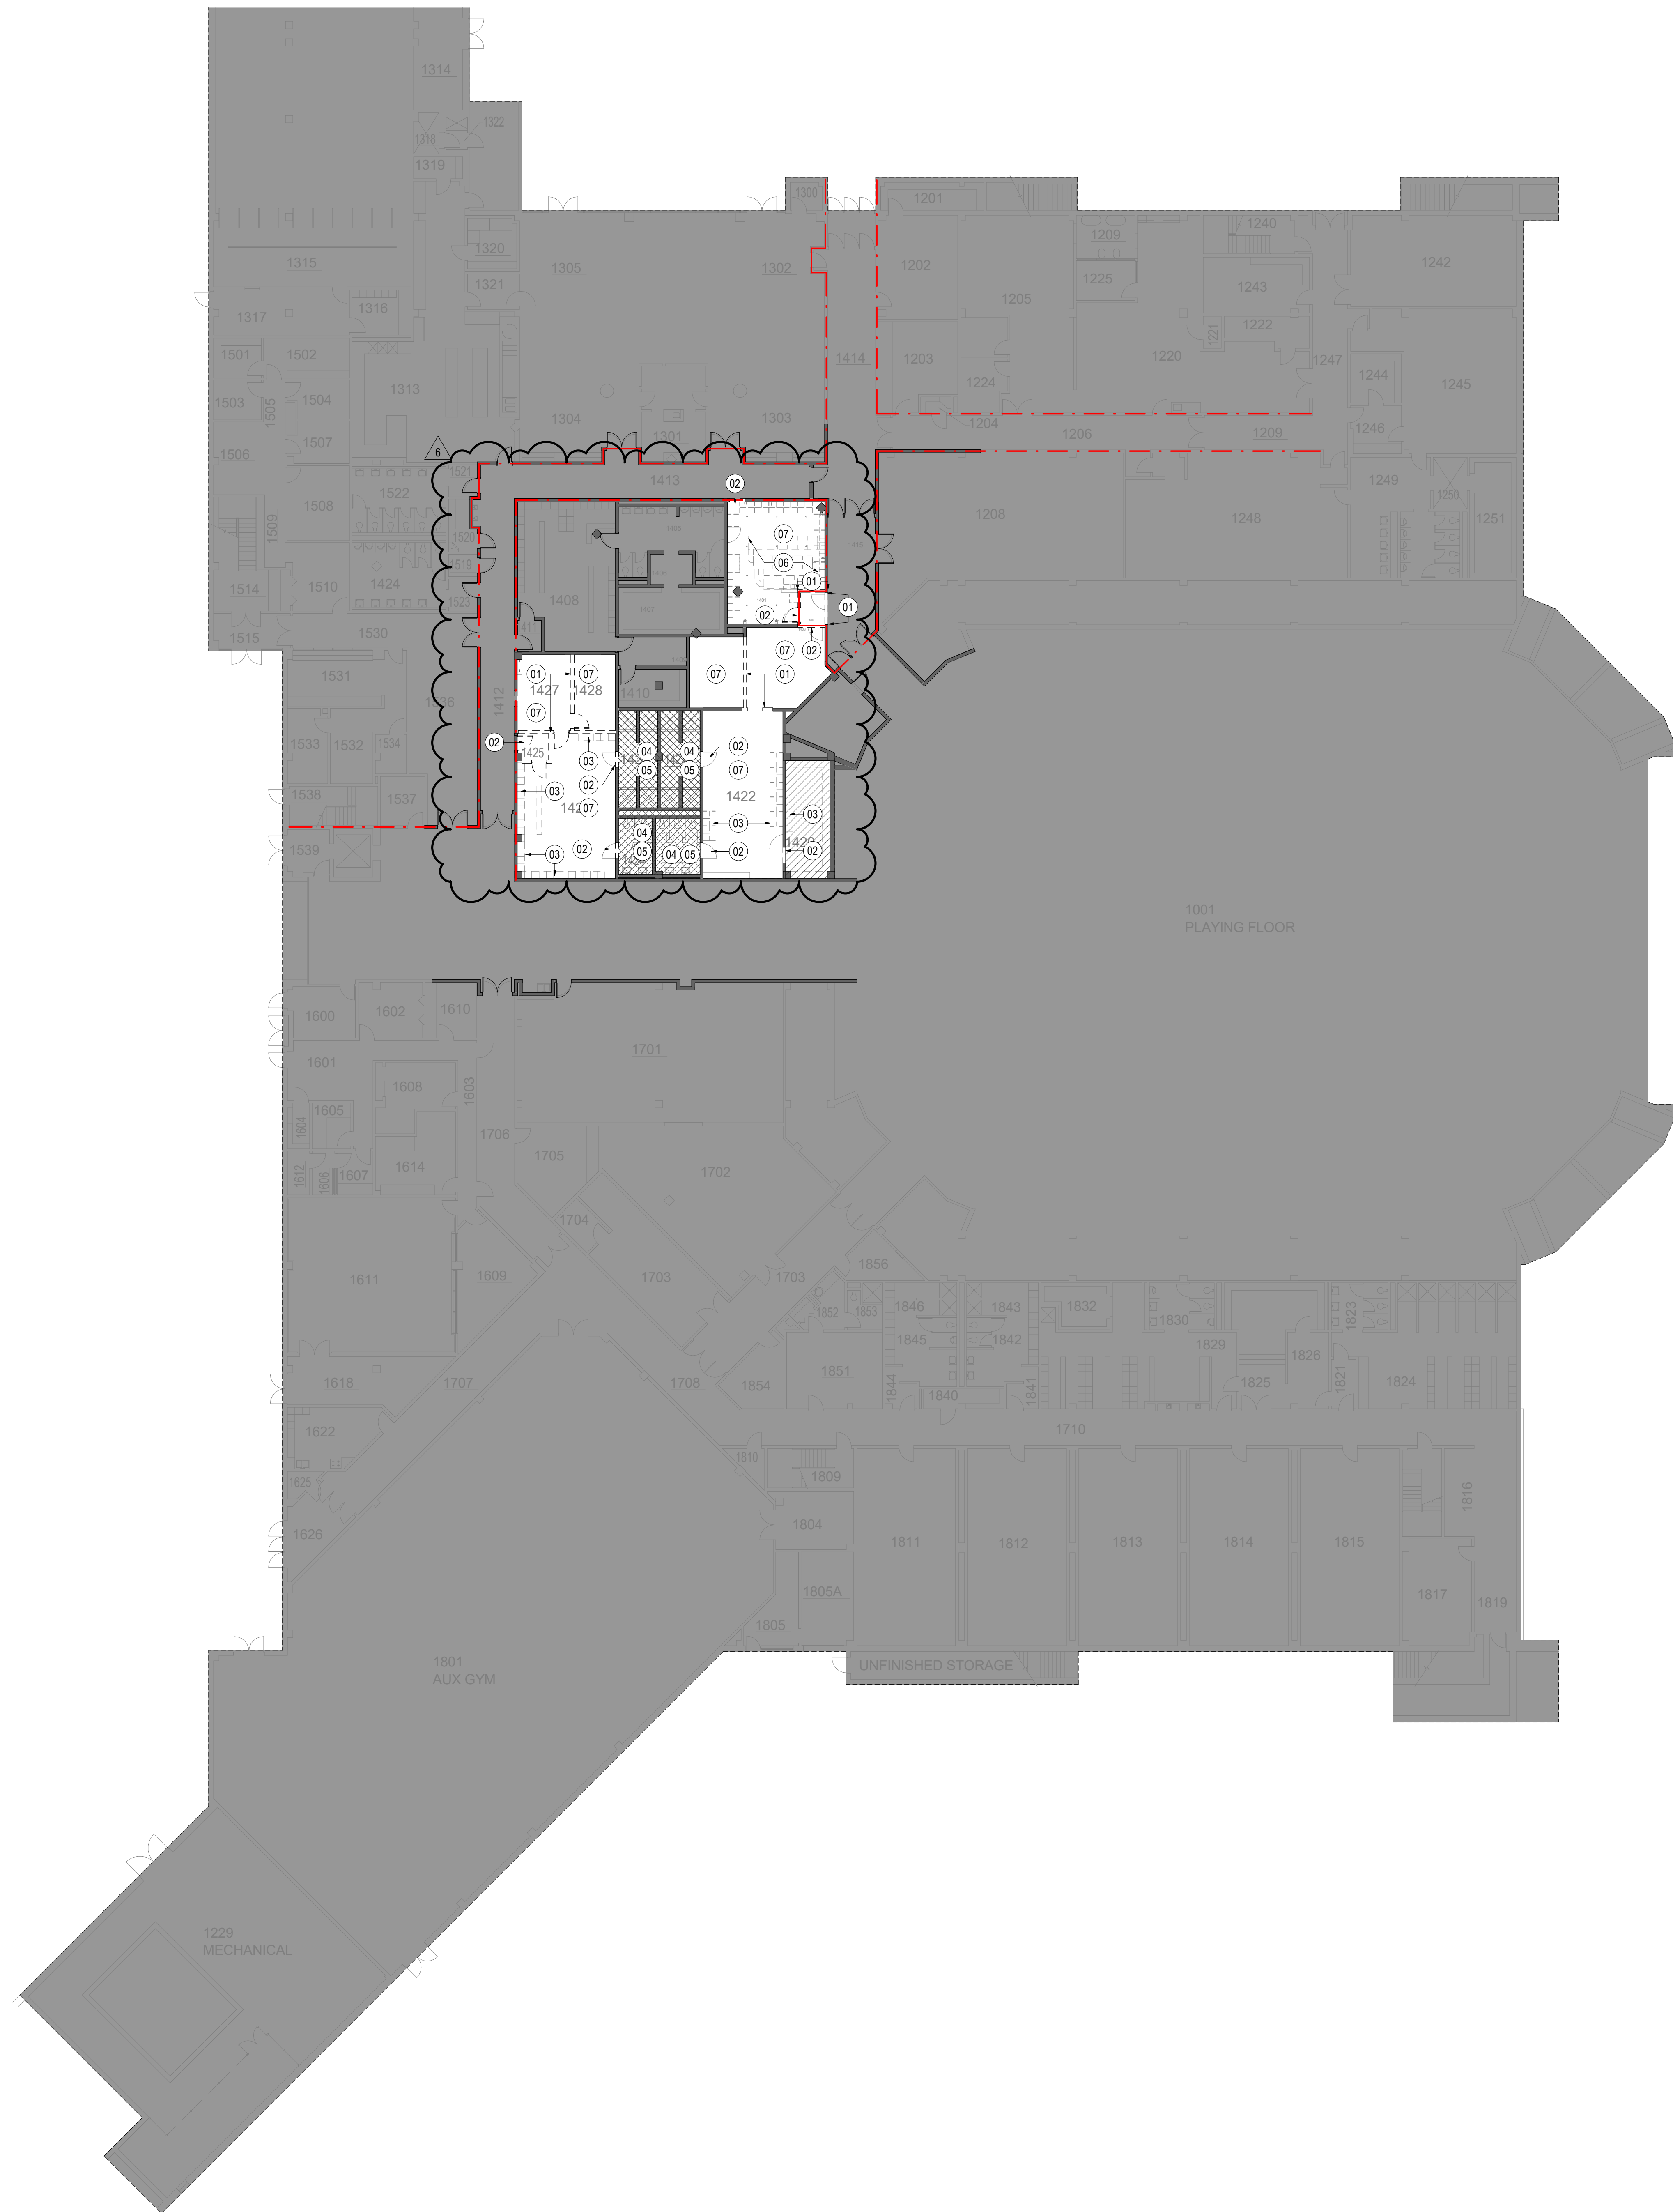

**SHEET NOTES**

- 01 DEMOLISH EXISTING PARTITION AS REQUIRED; PATCH AND REPAIR REMAINING PARTITION AS REQUIRED TO RECEIVE NEW FINISH.
- 02 DEMOLISH EXISTING PARTITION AS REQUIRED TO ACCOMMODATE SCHEDULED DOOR; PATCH AND REPAIR REMAINING PARTITION AS REQUIRED TO RECEIVE NEW FINISH.
- 03 EXISTING LOCKERS TO BE REMOVED; CONTRACTOR TO REMOVE FOR OWNER 16 LOCKERS OUT OF WOMEN'S PLAYER LOUNGE AND TO REMOVE 6 OF THE HIGH LOCKERS IN THE MEN'S PLAYER LOUNGE FOR SALVAGED AND STORAGE. ALL THE REMAINING LOCKERS TO BE DEMOLISHED.
- 04 EXISTING PARTITION TO BE DEMOLISHED; PATCH AND REPAIR REMAINING PARTITION AS REQUIRED TO RECEIVE NEW FINISH.
- 05 GYP CEILING TO REMAIN AND BE PREPARED TO RECEIVE NEW FINISH.
- 06 DEMOLISH EXISTING SEATING PLATFORM CONSTRUCTION AND PATCH AND REPAIR EXISTING FLOOR AND PARTITION.
- 07 DEMOLISH EXISTING CEILING AND PATCH AND REPAIR AS REQUIRED TO RECEIVE NEW FINISH.

**GENERAL NOTES**

- A. AREAS TONED IN GRAY ARE NOT IN CONTRACT.
- B. REFER TO SHEET G1.01 FOR GRAPHIC SYMBOLS AND ABBREVIATIONS.
- C. REMOVE PARTITIONS, BUILDING EQUIPMENT, FIXTURES, DOORS, FRAMES, AND ASSOCIATED HARDWARE WHERE INDICATED WITH DASHED LINES. REMOVE ALL MILLWORK, SHELVING, EQUIPMENT, AND PLUMBING WHERE INDICATED WITH DASHED LINES.
- D. REMOVE EXISTING AS REQUIRED TO ACCOMMODATE NEW WORK, EVEN WHERE NOT EXPRESSLY INDICATED ON DEMOLITION PLANS. REFER TO ALL OTHER CONSTRUCTION DOCUMENTS TO CONFIRM SCOPE.
- E. U.N.O. REMOVE ALL CEILINGS, SUSPENSION SYSTEMS, LIGHTING, AND ALL ASSOCIATED ACCESSORIES.
- F. REMOVE ABANDONED ELECTRICAL, TELEPHONE, DATA, SECURITY AND SIMILAR OTHER CABLING, CONDUIT, EQUIPMENT AND DEVICES, UNLESS OTHERWISE NOTED.
- G. REMOVE ABANDONED PLUMBING EQUIPMENT, VALVES, PIPING AND ALL ASSOCIATED HARDWARE & ACCESSORIES.
- H. REFER TO MEP ENGINEERING DRAWINGS FOR FURTHER DEMOLITION SCOPE.
- I. REMOVE FLOOR FINISHES AND ADHESIVE. REMOVE UNDERLAYMENT AND PATCHING COMPOUND TO STRUCTURAL SLAB.
- J. IN THE EVENT THAT HAZARDOUS MATERIALS ARE DISCOVERED, THE GENERAL CONTRACTOR SHALL NOTIFY OWNER IMMEDIATELY AND WORK SHALL STOP UNTIL THE OWNER VERIFIES THE CONDITION IS NOT HAZARDOUS.
- K. CORE DOORS AND FRAMES TO REMAIN, U.N.O. COORDINATE ANY DEMOLITION WITH PROPOSED SECURITY SCOPE.
- L. ALL FURNITURE TO BE REMOVED. PRIOR TO REMOVING FURNITURE, VERIFY WITH CLIENT IF ANY FURNITURE IS TO BE SALVAGED.
- M. IF DEMOLITION IS PERFORMED IN EXCESS OF THAT REQUIRED, RESTORE EFFECTED AREAS AT NO COST TO THE PROJECT.
- N. COLUMN ENCLOSURES AND DRYWALL FURR OUTS AROUND THE PERIMETER TO REMAIN, U.N.O. INTERIOR COLUMN FURR OUTS TO REMAIN, U.N.O.
- O. SALVAGE ALL AED DEVICES FOR REINSTALLATION. PROTECT AND STORE DURING CONSTRUCTION.
- P. WHERE BASE BUILDING CORE WALLS, COLUMN ENCLOSURES, FLOOR AND CEILING STRUCTURES ARE AFFECTED BY NEW WORK OR MADE INCOMPLETE DUE TO DEMOLITION/REMOVAL WORK, PATCH WITH MATCHING MATERIAL AND CONSTRUCTION. PROVIDE MASONRY, SHAFTWALL AND FIRE-RATED CONSTRUCTION TO MATCH. PROVIDE FIRE STOPPING AS REQUIRED.
- Q. WCU ATHLETICS WOULD LIKE TO REUSE THE MAJORITY OF THE LOCKERS FOR OTHER SPORTS PROGRAMS. THEY WOULD LIKE TO REUSE ALL OF THE LOCKERS IN THE WOMEN'S BASKETBALL SIDE AND APPROXIMATELY SIX (6) OF THE LOCKERS IN THE MEN'S BASKETBALL SIDE FOR THE TRACK & FIELD AND SOCCER PROGRAMS. THE CONTRACTOR SHALL BE RESPONSIBLE FOR COORDINATING WITH THE OWNER FOR THE REMOVAL OF THE LOCKERS AND WCU WILL BE RESPONSIBLE FOR RELOCATING THE LOCKERS. ANY REMAINING LOCKERS NOT REUSED BY THE WCU ATHLETIC DEPARTMENT SHALL REMAIN AS PART OF THE CONTRACTOR'S DEMOLITION PORTION OF THE SCOPE OF WORK.

- EXISTING PARTITIONS, FIXTURES, ACCESSORIES, & LIGHTING TO REMAIN. ENSURE PROTECTION DURING CONSTRUCTION. REPLACE WALL & FLOOR FINISHES ONLY.
- EXISTING PARTITIONS & FLOORING TO REMAIN. FLOOR TO RECEIVE NEW CONCRETE SEAL. ENSURE PROTECTION DURING CONSTRUCTION. REMOVE ALL BUILT IN FURNITURE FROM ROOM.



92 Catamount Road  
Cullowhee, NC 28723

**Gensler**

2020 K St NW  
Washington, DC 20006  
United States

Tel (202) 721-5200  
Fax +1 202 872 8587



MEP ENGINEERS  
1927 South Tryon Street  
Suite 300  
Charlotte, NC 28203  
Tel 704.338.1292

SCO ID: 21-22998-01  
CIP: 42029

Date	Description
1 03/26/2021	DESIGN DEVELOPMENT - ISSUE FOR PRICING
2 04/19/2021	ISSUE FOR PERMIT
3 06/11/2021	ISSUE FOR PERMIT - RESUBMIT
4 10/18/2021	ISSUE FOR BID
6 11/30/2021	ADDENDUM 02

Seal / Signature

Project Name  
**RAMSEY - BASKETBALL LOCKER ROOM RENOVATION**




Project Number  
**009.9478.000**

Description  
**DEMOLITION PLAN**

Scale  
1/16" = 1'-0"

**D1.001**




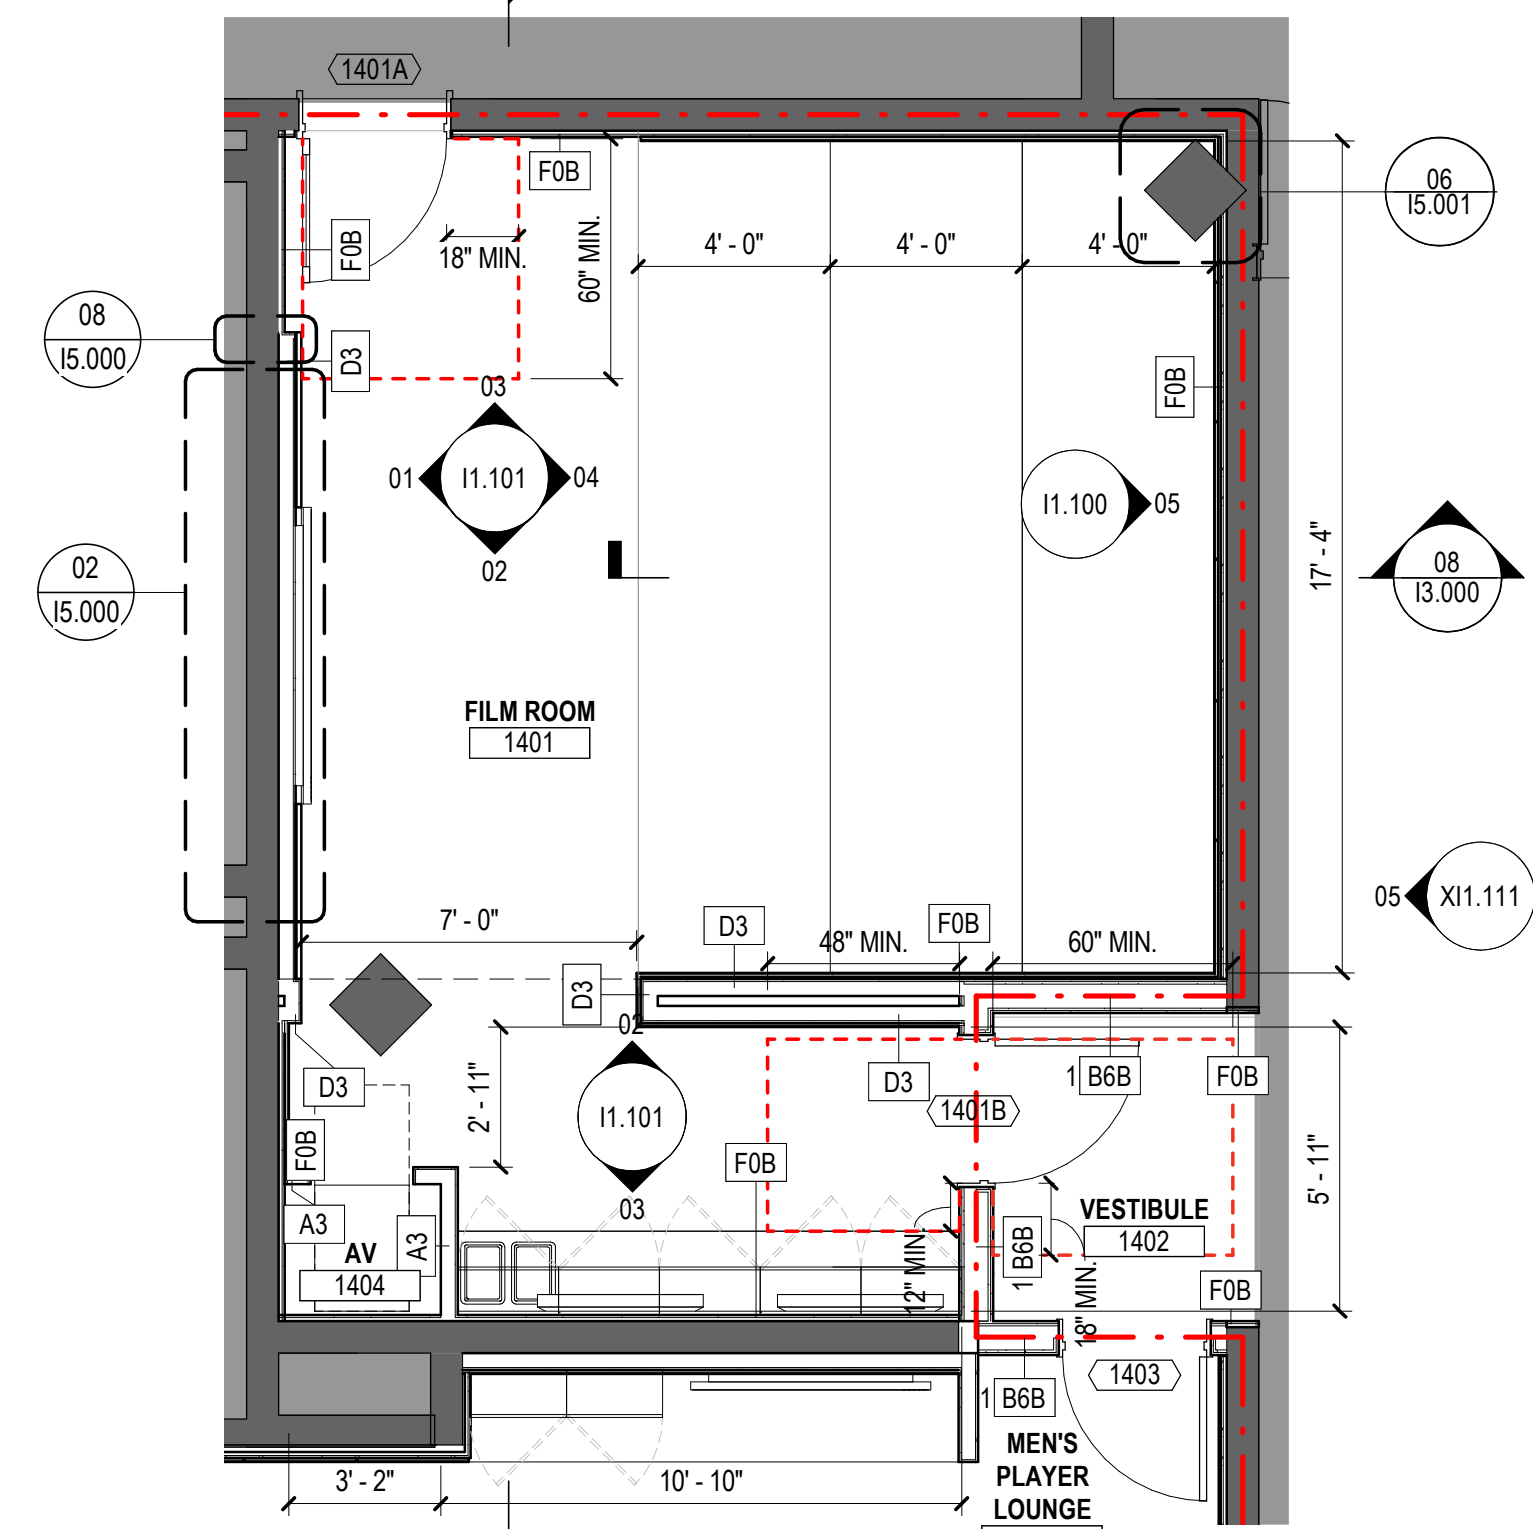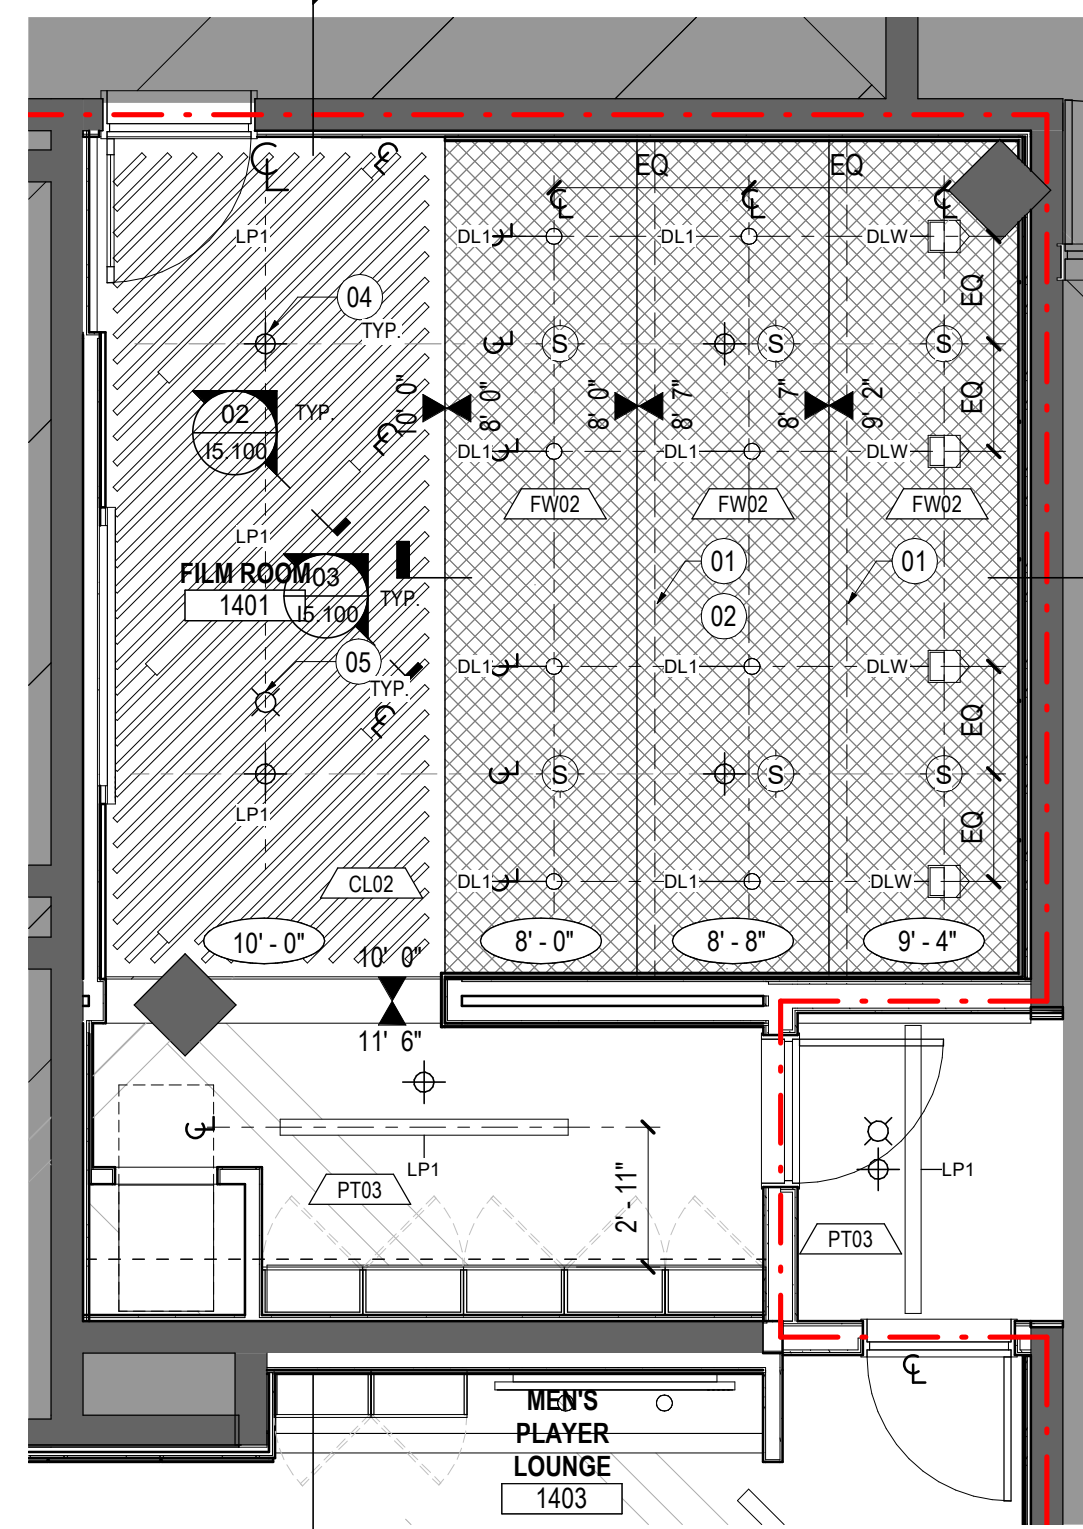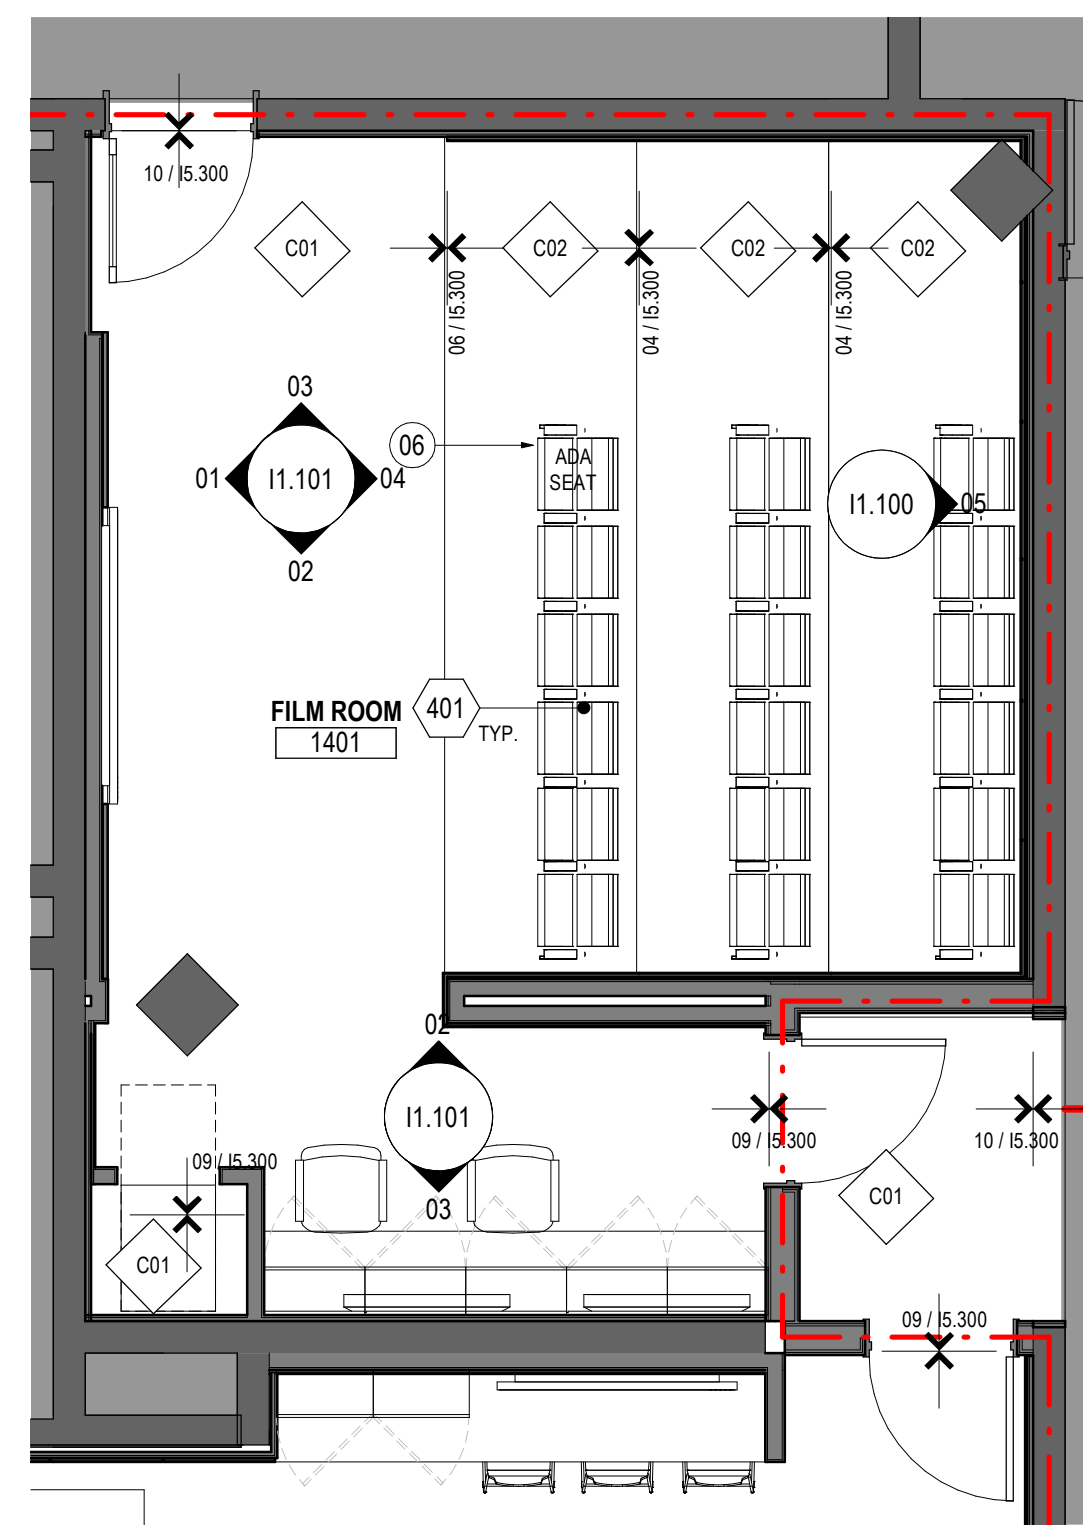


**07 ENLARGED FINISH & FURNITURE PLAN @ FILM ROOM**  
SCALE: 1/4" = 1'-0"

**04 ENLARGED REFLECTED CEILING PLAN @ FILM ROOM**  
SCALE: 1/4" = 1'-0"


**01 ENLARGED PLAN @ FILM ROOM**  
SCALE: 1/4" = 1'-0"

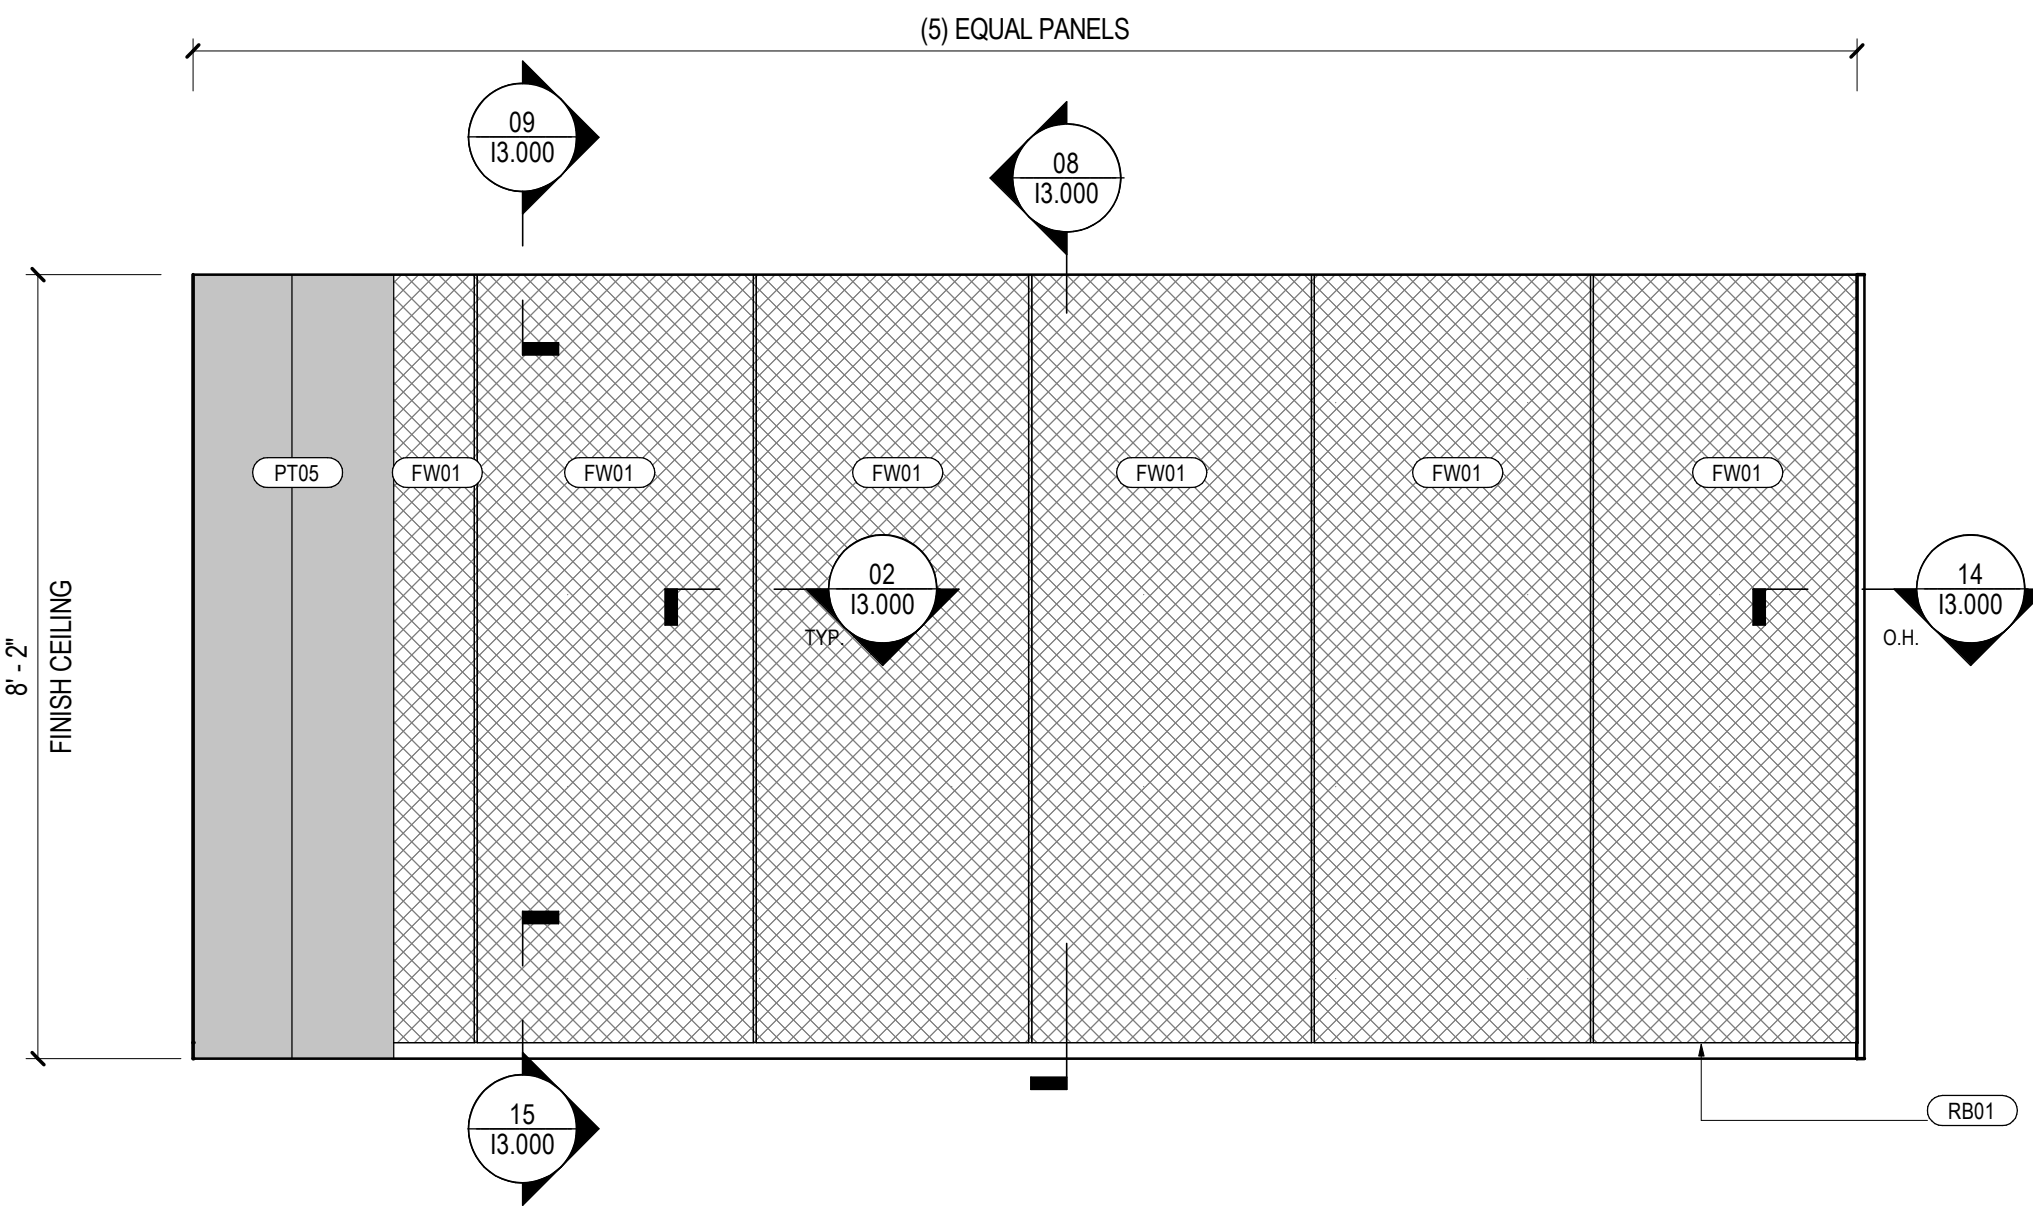

**05 ENLARGED PLAN @ FILM ROOM (REAR WALL)**  
SCALE: 1/2" = 1'-0"

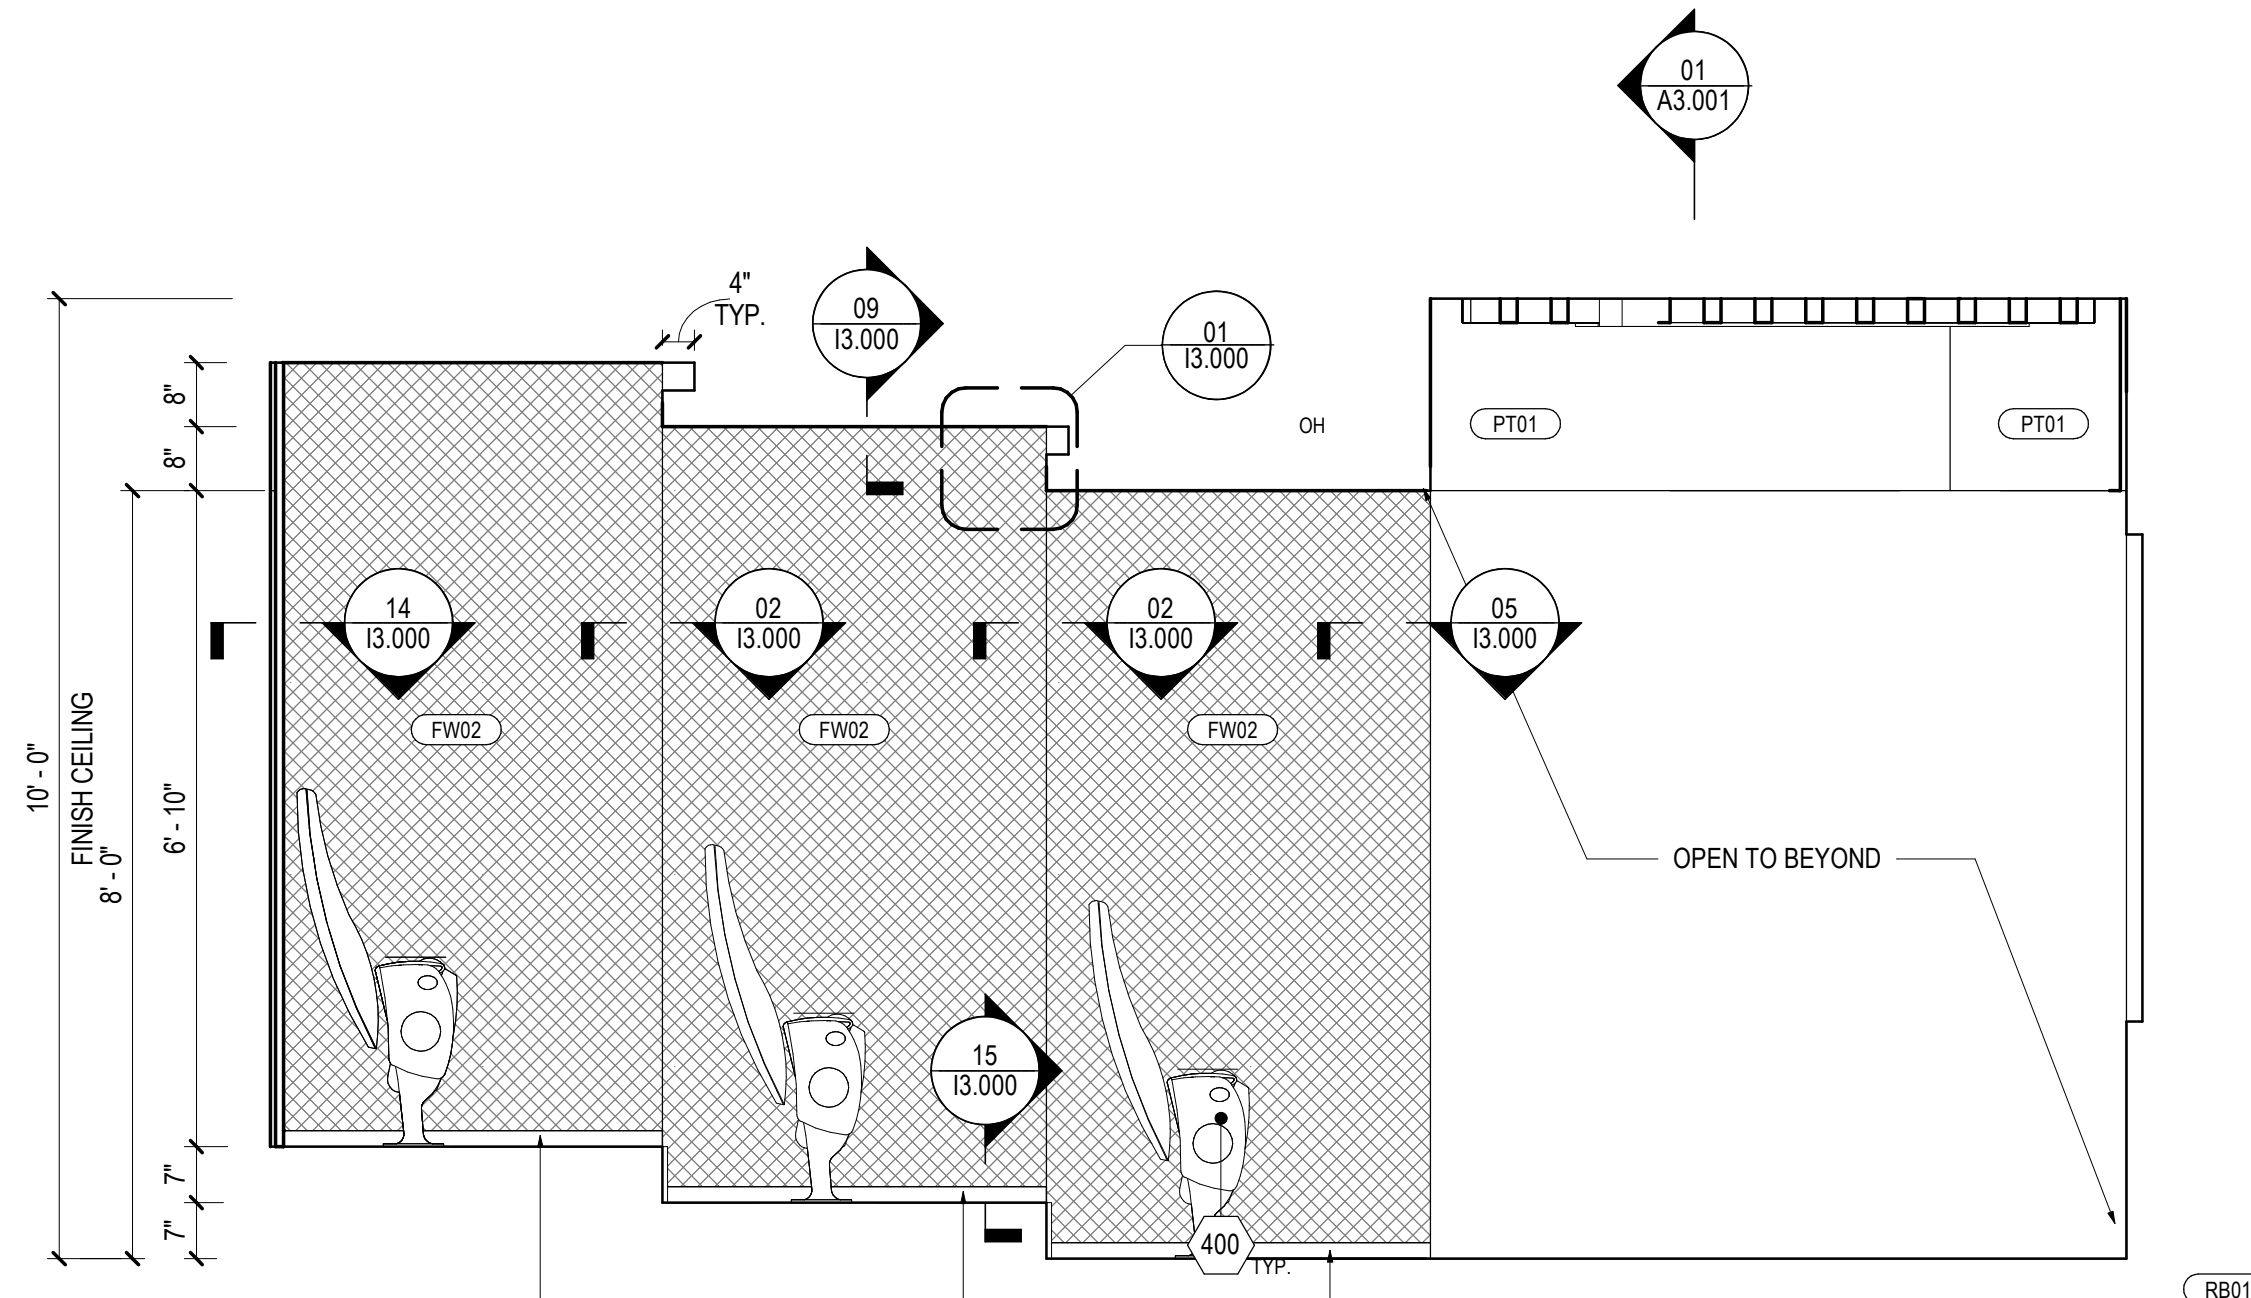

**02 ELEVATION @ FILM ROOM SOUTH**  
SCALE: 1/2" = 1'-0"

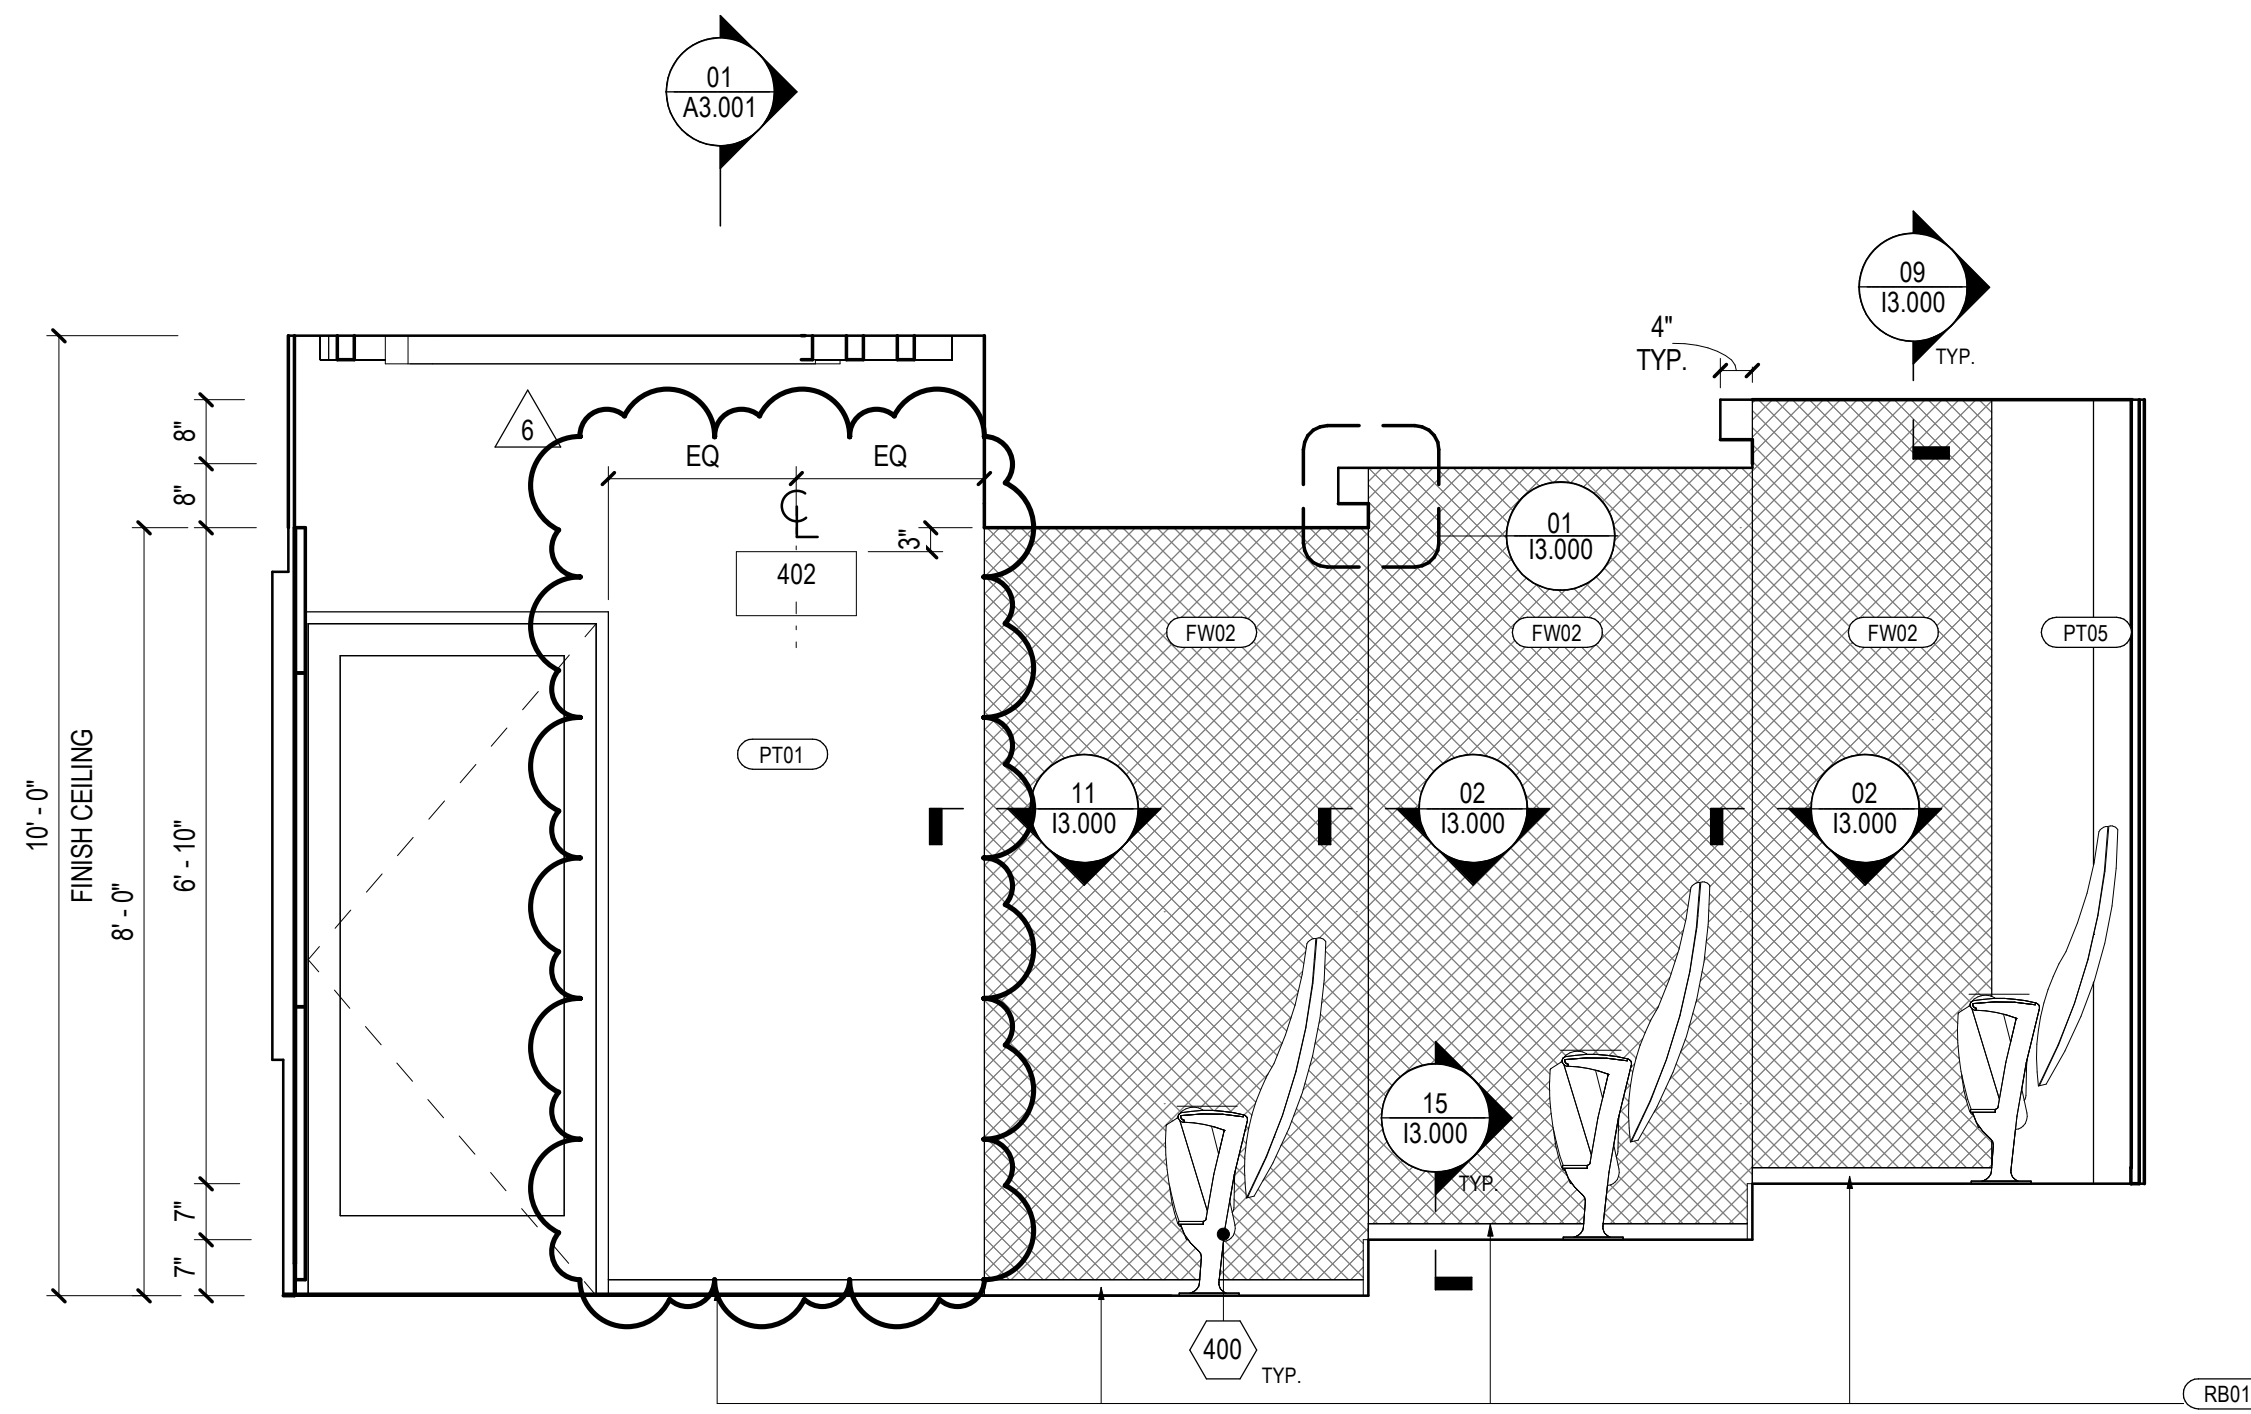

**03 ELEVATION @ FILM ROOM NORTH**  
SCALE: 1/2" = 1'-0"

**SHEET NOTES**

- 01 CONCEALED LED COVE FIXTURE WITH DIMMING CONTROLS.
  - 02 REFER TO ENLARGED PLANS AND ELEVATIONS FOR SPEAKER LOCATIONS AND MOUNTING HEIGHT.
  - 03 REFER TO FIRE PROTECTION DRAWINGS FOR LOCATION OF SPRINKLER HEADS.
  - 04 REFER TO ELECTRICAL DRAWINGS FOR LOCATION OF CEILING MOUNTED FIRE ALARM DEVICES.
- FINISH PLAN**
- 06 OPERATIONAL MODIFICATIONS TO BE MADE TO THE ADA SEAT POSITION. SEAT TO BE REMOVABLE.

**GENERAL NOTES**

- A. AREAS TONED IN GRAY ARE NOT IN CONTRACT.
- B. REFER TO SHEET G1.01 FOR GRAPHIC SYMBOLS AND ABBREVIATIONS.
- C. REFER TO SHEET G1.10 FOR TYPICAL MOUNTING HEIGHTS, AND LOCATION DIAGRAMS.
- D. ON TYPICAL FLOORS PATCH AND EXTEND RESILIENT BASE AS NECESSARY WITH NEW TO MATCH EXISTING.
- E. REFER TO SHEET IS.300. FOR TRANSITION AND BASE DETAILS.
- F. UNLESS NOTED OTHERWISE FINISHES TO BE:  
a. WALL: PT01  
b. WALL BASE: RB01  
c. FLOOR: C01  
d. GYP. BD: PT04  
e. EXPOSED OPEN CEILING: PT03
- G. SEALANT AND CAULKING COLORS TO MATCH ADJACENT SURFACE.
- H. ALL ITEMS VISIBLE IN SPACE TO BE FINISHED. MISCELLANEOUS UNFINISHED ITEMS AND DEVICES TO BE REFINISHED WITH ARCHITECT AND OWNER FOR FINAL FINISH.
- I. UNLESS NOTED OTHERWISE ALIGN FLOORING TRANSITION WITH CENTERLINE OF DOOR. IF NO DOOR, ALIGN WITH FINISHED BASE.
- J. ALL COLOR FINISHES FOR TRANSITION STRIPS TO BE SELECTED BY ARCHITECT PRIOR TO MANUFACTURE AND INSTALLATION.
- K. UNLESS NOTED OTHERWISE CONTINUE SCHEDULED FLOORING UNDER MILLWORK.
- L. COVER PLATES TO BE STAINLESS STEEL. UNLESS NOTED OTHERWISE, REPLACE ANY EXISTING OUTLETS AND COVER PLATES THAT DO NOT MATCH NEW.
- M. FURNITURE PLANS ARE SHOWN FOR INFORMATION ONLY.
- N. GENERAL CONTRACTOR, FURNITURE VENDOR, ARCHITECT, AND OWNER TO REVIEW SCOPE RESPONSIBILITY PRIOR TO PROCUREMENT.
- O. REFER TO ENGINEERING AND CONSULTANT DRAWINGS FOR ADDITIONAL POWER AND COMMUNICATION REQUIREMENTS.
- P. INDICATED DIMENSIONS ARE TO THE CENTER LINE OF OUTLET OR SWITCH, OR GLUSTER OF OUTLETS OR SWITCHES, UNLESS OTHERWISE NOTED.
- Q. INSTALL OUTLETS ON OPPOSITE SIDES OF PARTITIONS IN SEPARATE STUD CAVITIES. DO NOT INSTALL BACK-TO-BACK.
- R. COVER PLATES TO BE STAINLESS STEEL. UNLESS NOTED OTHERWISE, REPLACE ANY EXISTING OUTLETS AND COVERPLATES THAT DO NOT MATCH NEW.
- S. ALL THROUGH PENETRATIONS TO MAINTAIN FIRE RESISTANCE RATING OR HORIZONTAL ASSEMBLY IN ACCORDANCE WITH CODE. PROVIDE UL NUMBER OF DEVICES WHERE APPROPRIATE.
- T. COORDINATE LOCATION OF ALL POWER AND COMMUNICATION DEVICES AND STUB UPS IN FIELD WITH FINAL FURNITURE PACKAGE AND FURNITURE VENDOR. THIS INCLUDES THE LOCATION COORDINATION OF THE FURNITURE IN-FEED WITH TABLE TOP BOX TERMINATION WITH FURNITURE AND AV VENDOR. ALL GROMMET LOCATIONS AT FURNITURE AND/OR MILLWORK WITH FURNITURE/MILLWORK VENDORS.
- U. ALL PENETRATION IN STRUCTURAL SLAB TO BE GPR OR X-RAY SCANNED AND APPROVED BY OWNER TO INSURE STRUCTURAL INTEGRITY OF SLAB.
- V. REFER TO ENLARGED PLANS AND ELEVATIONS FOR FURTHER OUTLET DIMENSIONS.



92 Catamount Road  
Cullowhee, NC 28723

**Gensler**

2020 K St NW Washington, DC 20006 United States  
Tel (202) 721-5200 Fax +1 202.872.8587



MEP ENGINEERS  
1927 South Tryon Street  
Suite 300  
Charlotte, NC 28203  
Tel 704.338.1292

SCO ID: 21-22998-01  
CIP: 42029

Date	Description
1 03/26/2021	DESIGN DEVELOPMENT - ISSUE FOR PRICING
2 04/19/2021	ISSUE FOR PERMIT
3 06/11/2021	ISSUE FOR PERMIT - RESUBMIT
4 10/18/2021	ISSUE FOR BID
6 11/30/2021	ADDENDUM 02

Seal / Signature

Project Name  
**RAMSEY - BASKETBALL LOCKER ROOM RENOVATION**

Project Number  
**009.9478.000**

Description  
ENLARGED PLAN, RCP & INTERIOR ELEVATIONS OF FILM ROOM

Scale  
As indicated

**11.100**





92 Catamount Road  
Cullowhee, NC 28723

**Gensler**

2020 K St NW Washington, DC 20006 United States  
Tel (202) 721-5200 Fax +1 202 872 8587




MEP ENGINEERS  
1927 South Tryon Street  
Suite 300  
Charlotte, NC 28203  
Tel 704.338.1292


SCO ID: 21-22998-01  
CIP: 42029

**SHEET NOTES**

06 DG02 APPLIED FULL COURT GRAPHIC.

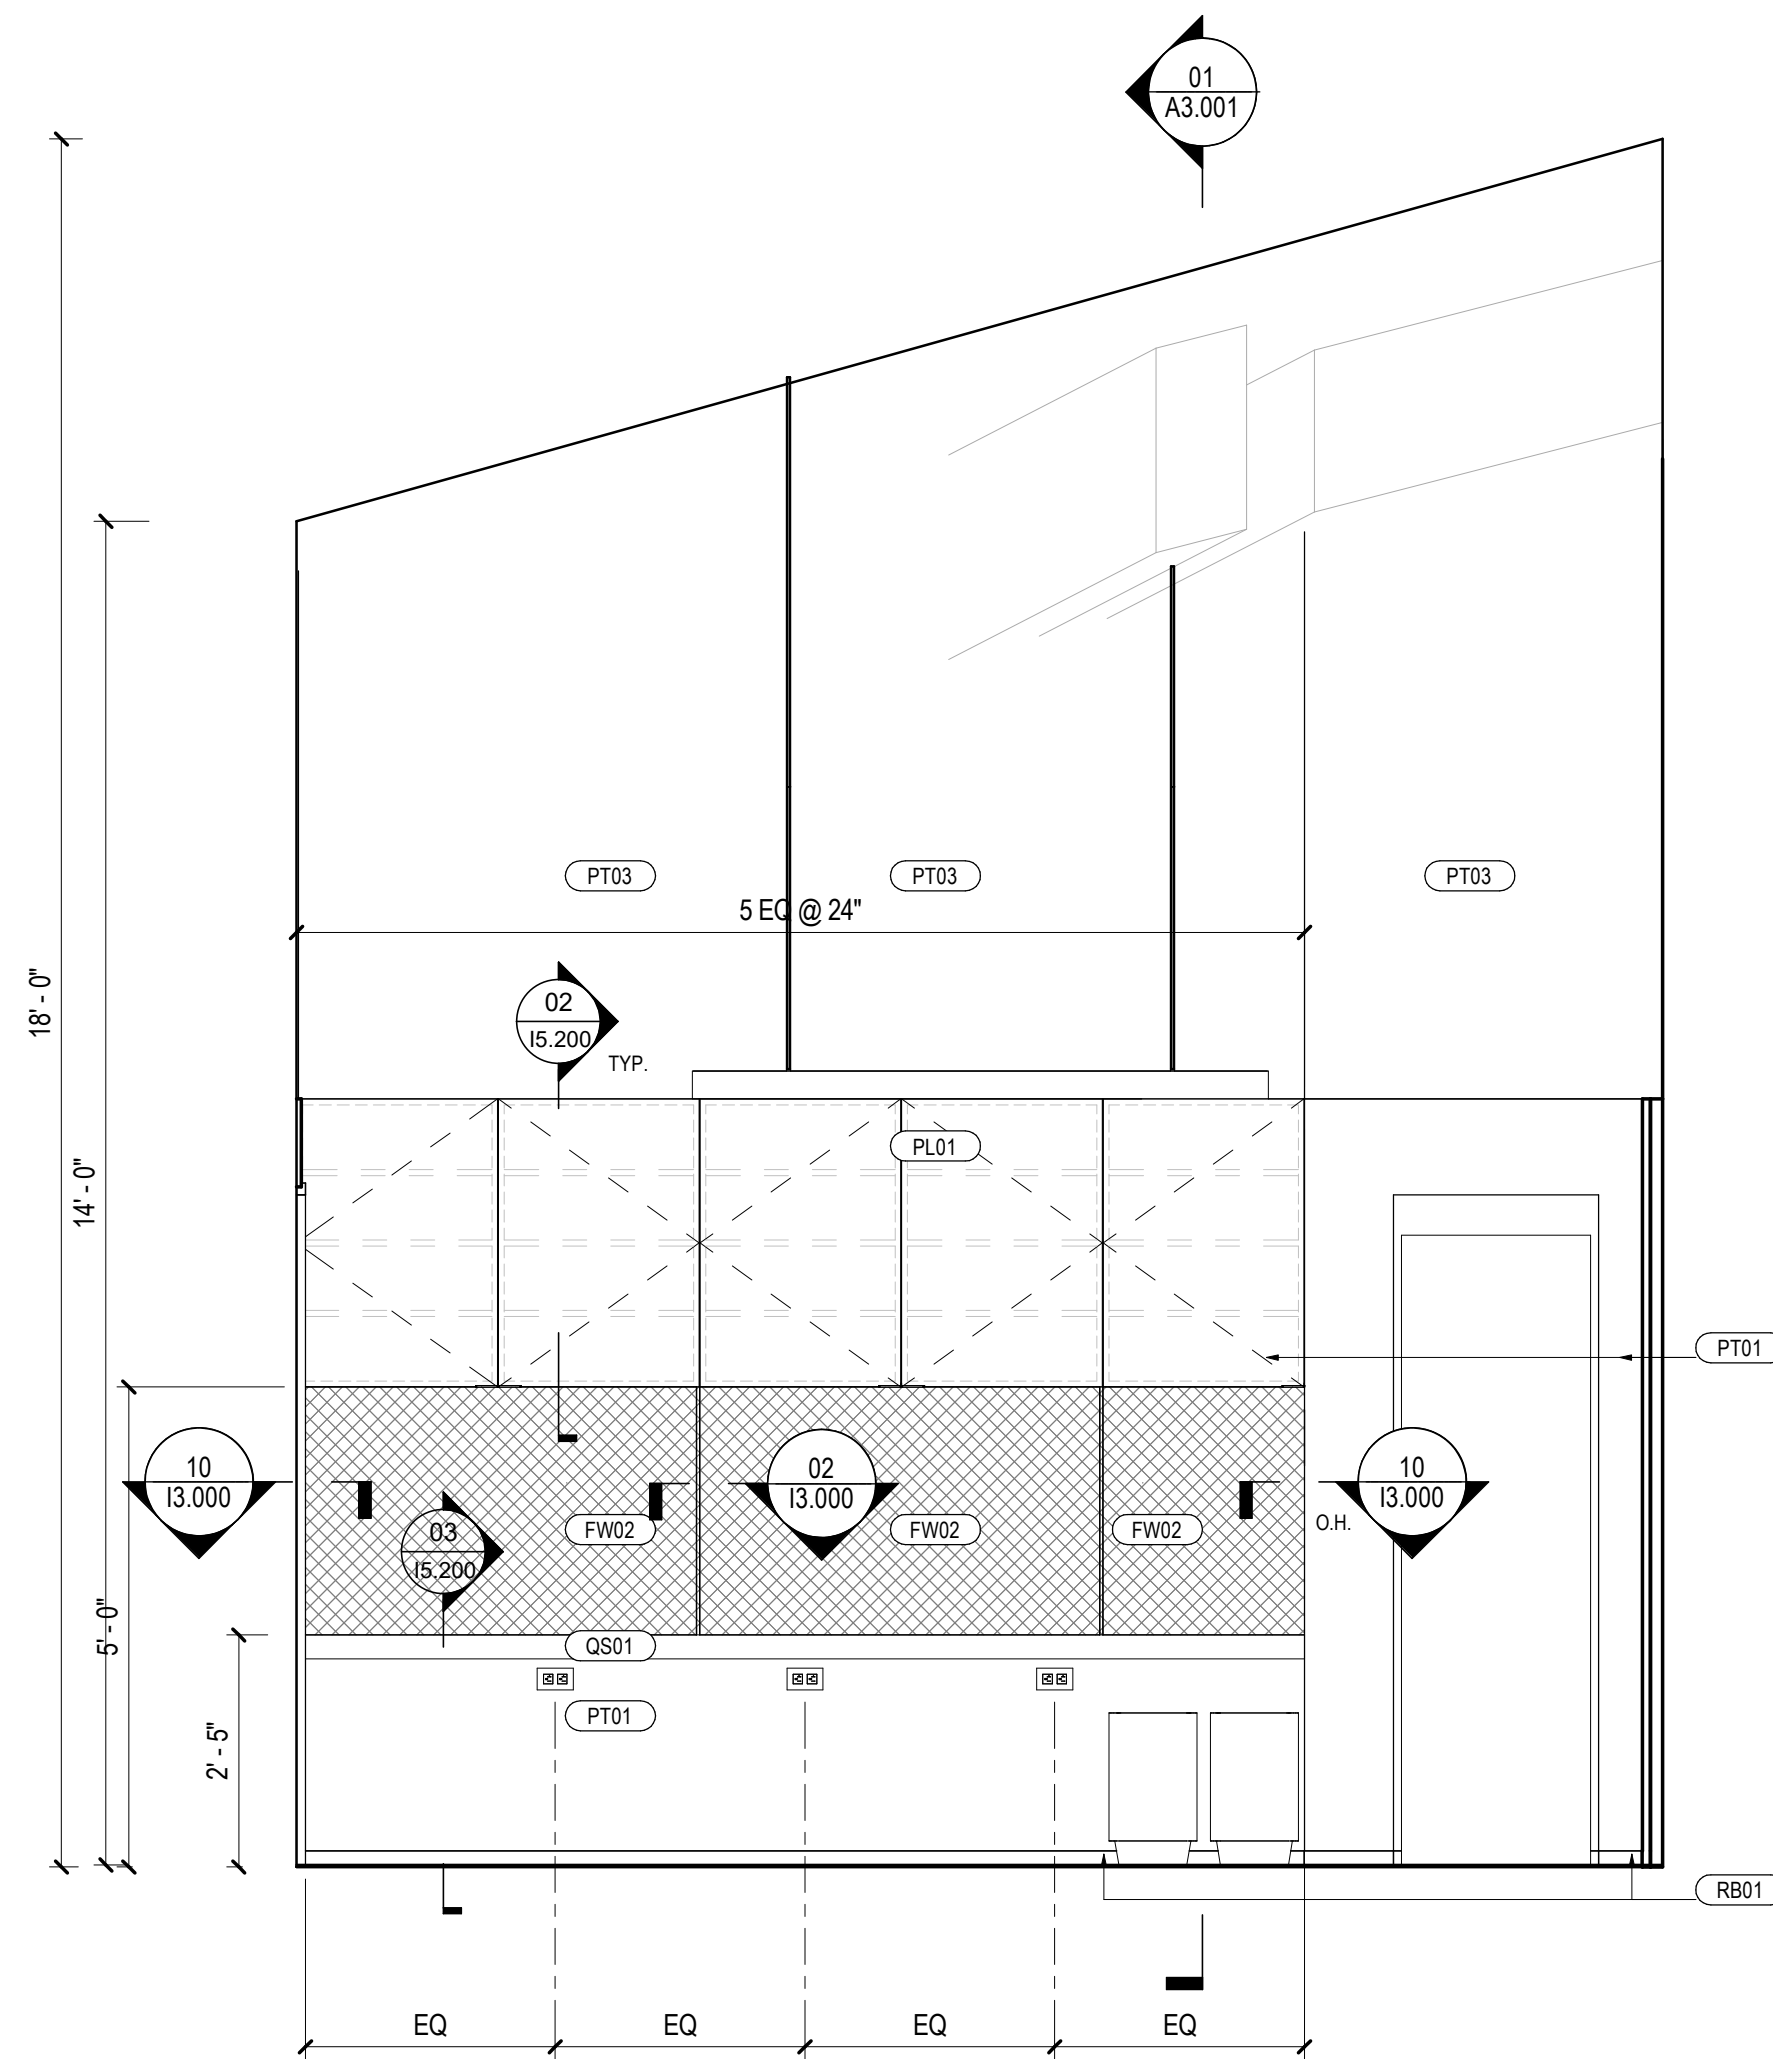

**03 ELEVATION @ FILM ROOM ENTRY NORTH**  
SCALE: 1/2" = 1'-0"

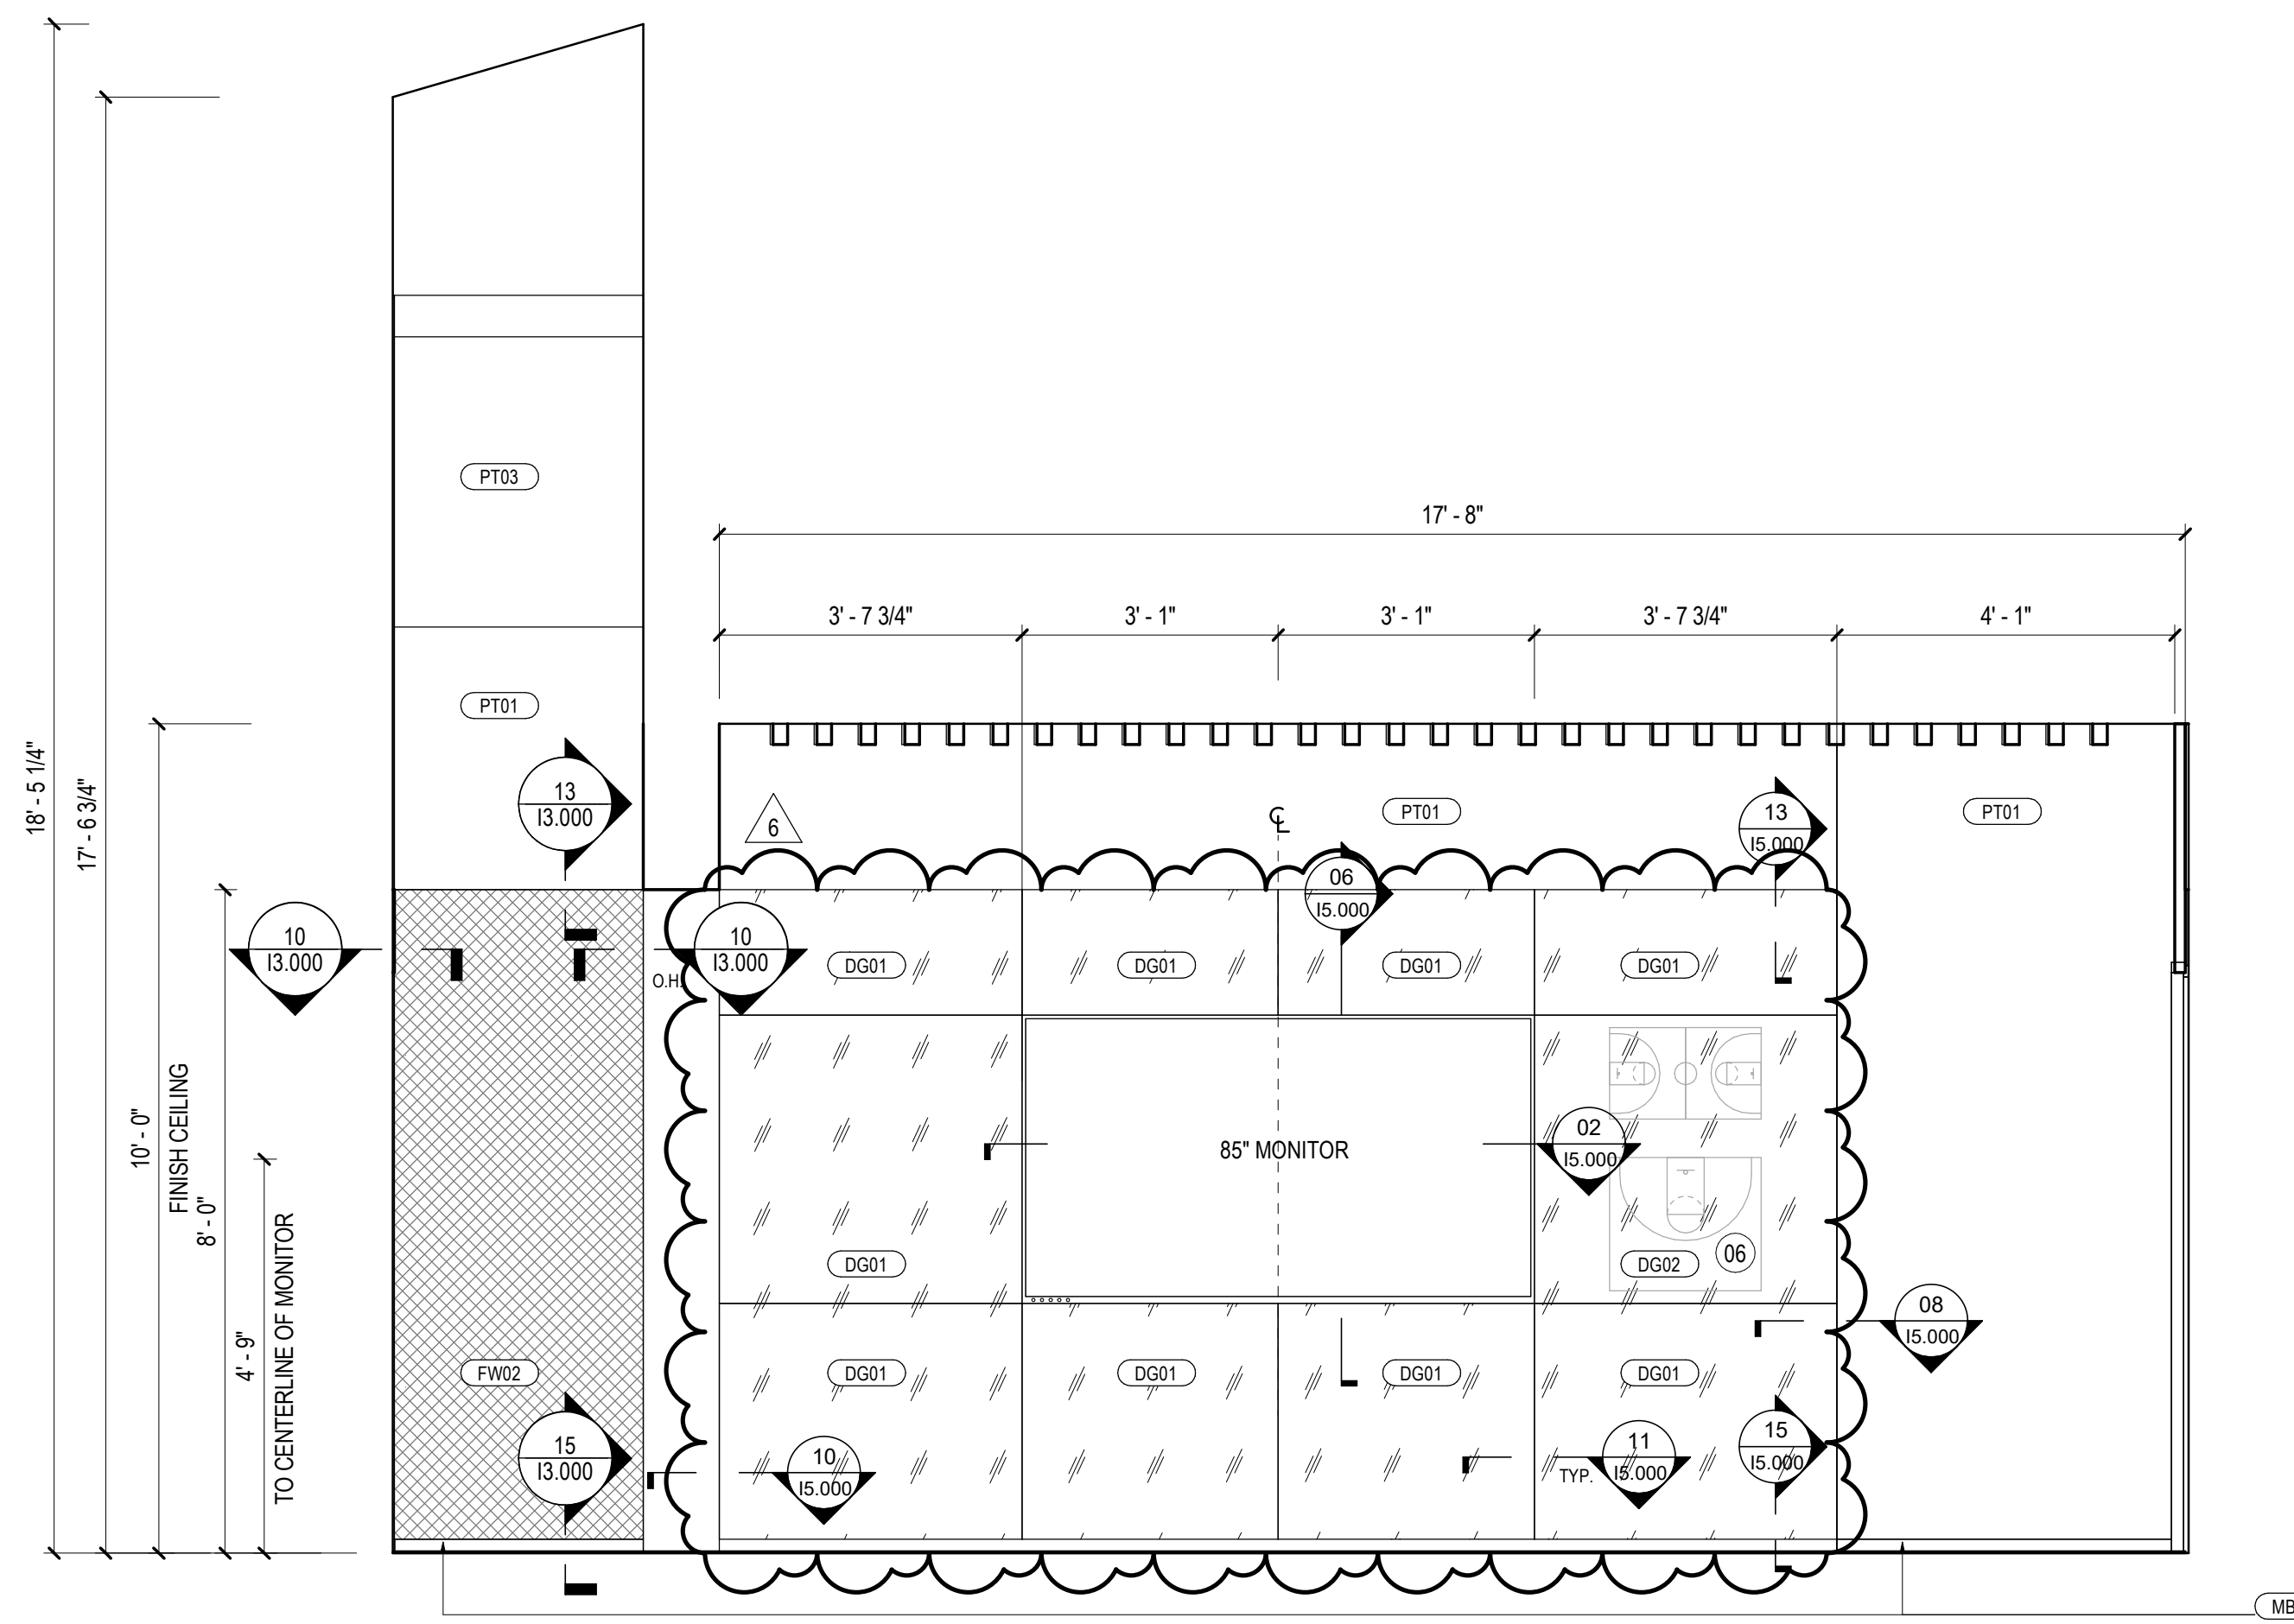


**01 ELEVATION @ FILM ROOM WEST**  
SCALE: 1/2" = 1'-0"


**GENERAL NOTES**

- A. AREAS TONED IN GRAY ARE NOT IN CONTRACT.
- B. REFER TO SHEET G1.01 FOR GRAPHIC SYMBOLS AND ABBREVIATIONS.
- C. ON TYPICAL FLOORS PATCH AND EXTEND WALL BASE AS NECESSARY WITH NEW TO MATCH EXISTING.
- D. REFER TO SHEET 15.300 FOR TRANSITION AND BASE DETAILS.
- E. UNLESS NOTED OTHERWISE FINISHES TO BE:  
a. WALL - PT01  
b. WALL BASE - RB01  
c. FLOOR - C01  
d. GYP. BD. - PT04  
e. EXPOSED OPEN CEILING; PT03
- F. SEALANT AND CAULKING COLORS TO MATCH ADJACENT SURFACE.
- G. ALL ITEMS VISIBLE IN SPACE TO BE FINISHED. MISCELLANEOUS UNFINISHED ITEMS AND DEVICES TO BE REVIEWED WITH ARCHITECT AND OWNER FOR FINAL FINISH.
- H. UNLESS NOTED OTHERWISE ALIGN FLOORING TRANSITION WITH CENTERLINE OF DOOR. IF NO DOOR, ALIGN WITH FINISHED BASE.
- I. ALL COLOR FINISHES FOR TRANSITION STRIPS TO BE SELECTED BY ARCHITECT PRIOR TO INSTALLATION.
- J. UNLESS NOTED OTHERWISE CONTINUE SCHEDULED FLOORING UNDER MILLWORK.
- K. COVER PLATES TO BE STAINLESS STEEL. UNLESS NOTED OTHERWISE, REPLACE ANY EXISTING OUTLETS AND COVER PLATES THAT DO NOT MATCH NEW.

Date	Description
2 04/19/2021	ISSUE FOR PERMIT
3 06/11/2021	ISSUE FOR PERMIT - RESUBMIT
4 10/18/2021	ISSUE FOR BID
6 11/30/2021	ADDENDUM 02

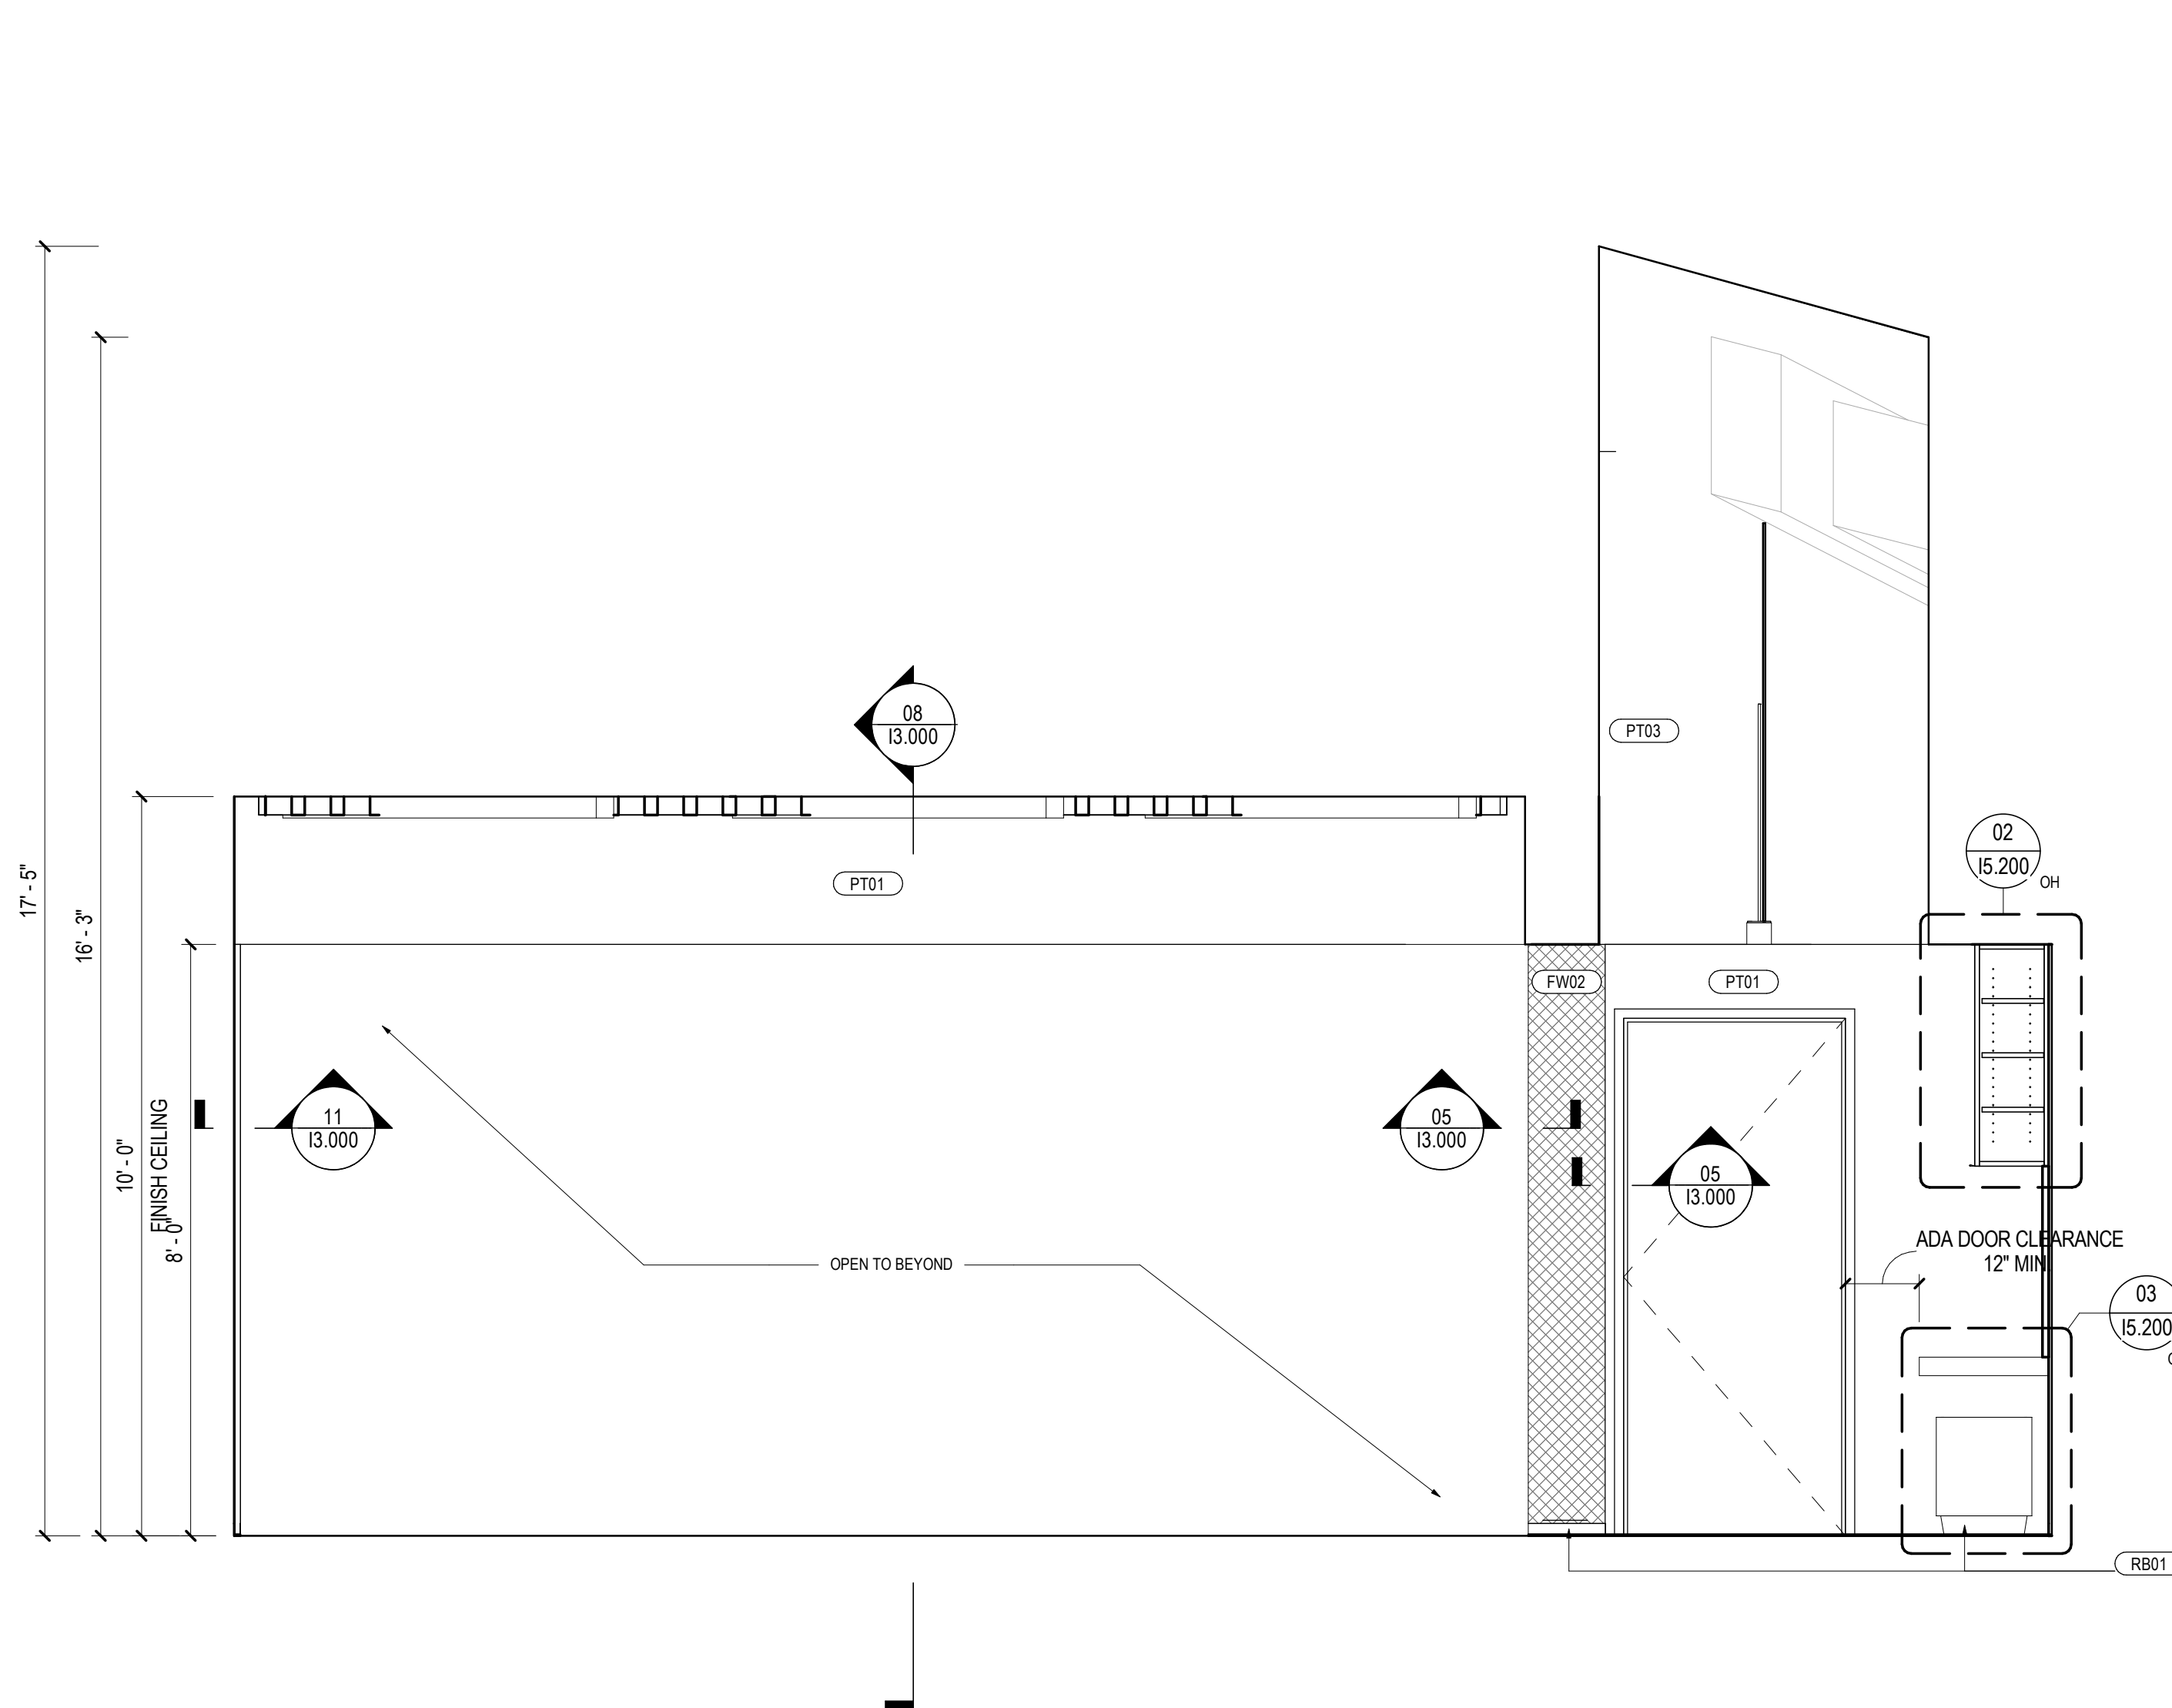

**04 ELEVATION @ FILM ROOM EAST**  
SCALE: 1/2" = 1'-0"

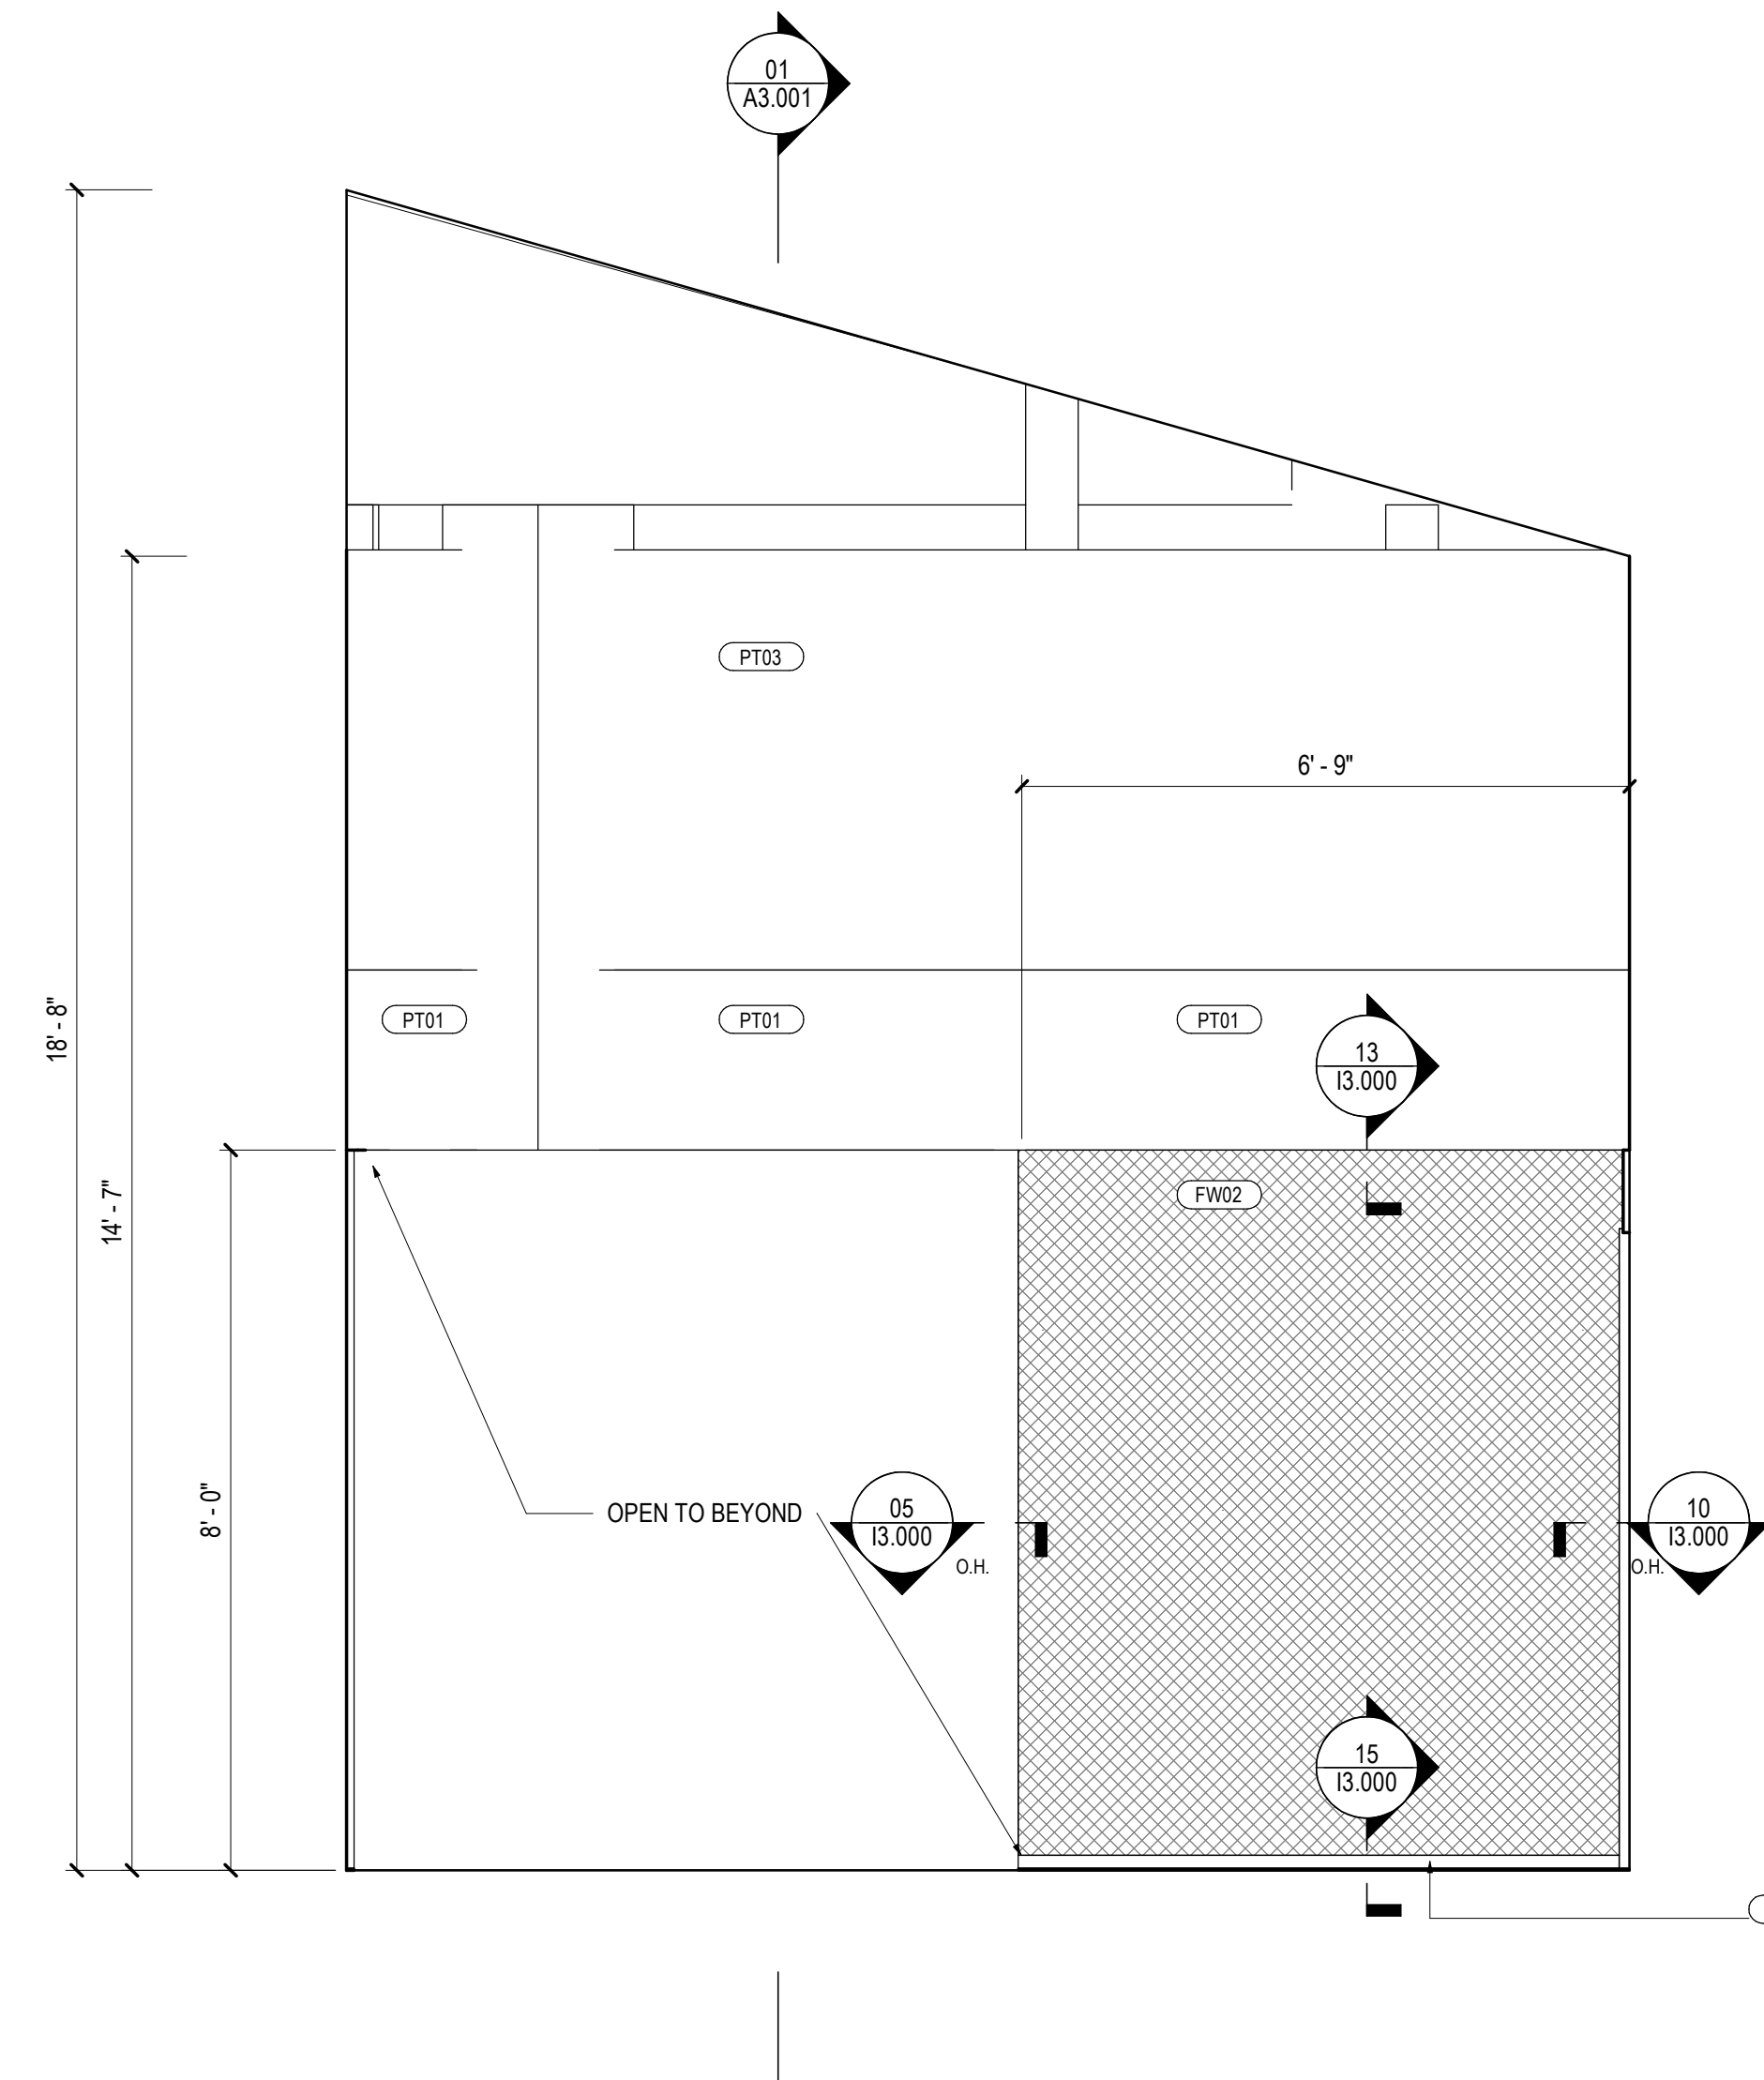

**02 ELEVATION @ FILM ROOM ENTRY SOUTH**  
SCALE: 1/2" = 1'-0"

Seal / Signature

Project Name  
**RAMSEY - BASKETBALL LOCKER ROOM RENOVATION**


Project Number  
**009.9478.000**

Description  
INTERIOR ELEVATIONS OF FILM ROOM


Scale  
1/2" = 1'-0"

**11.101**




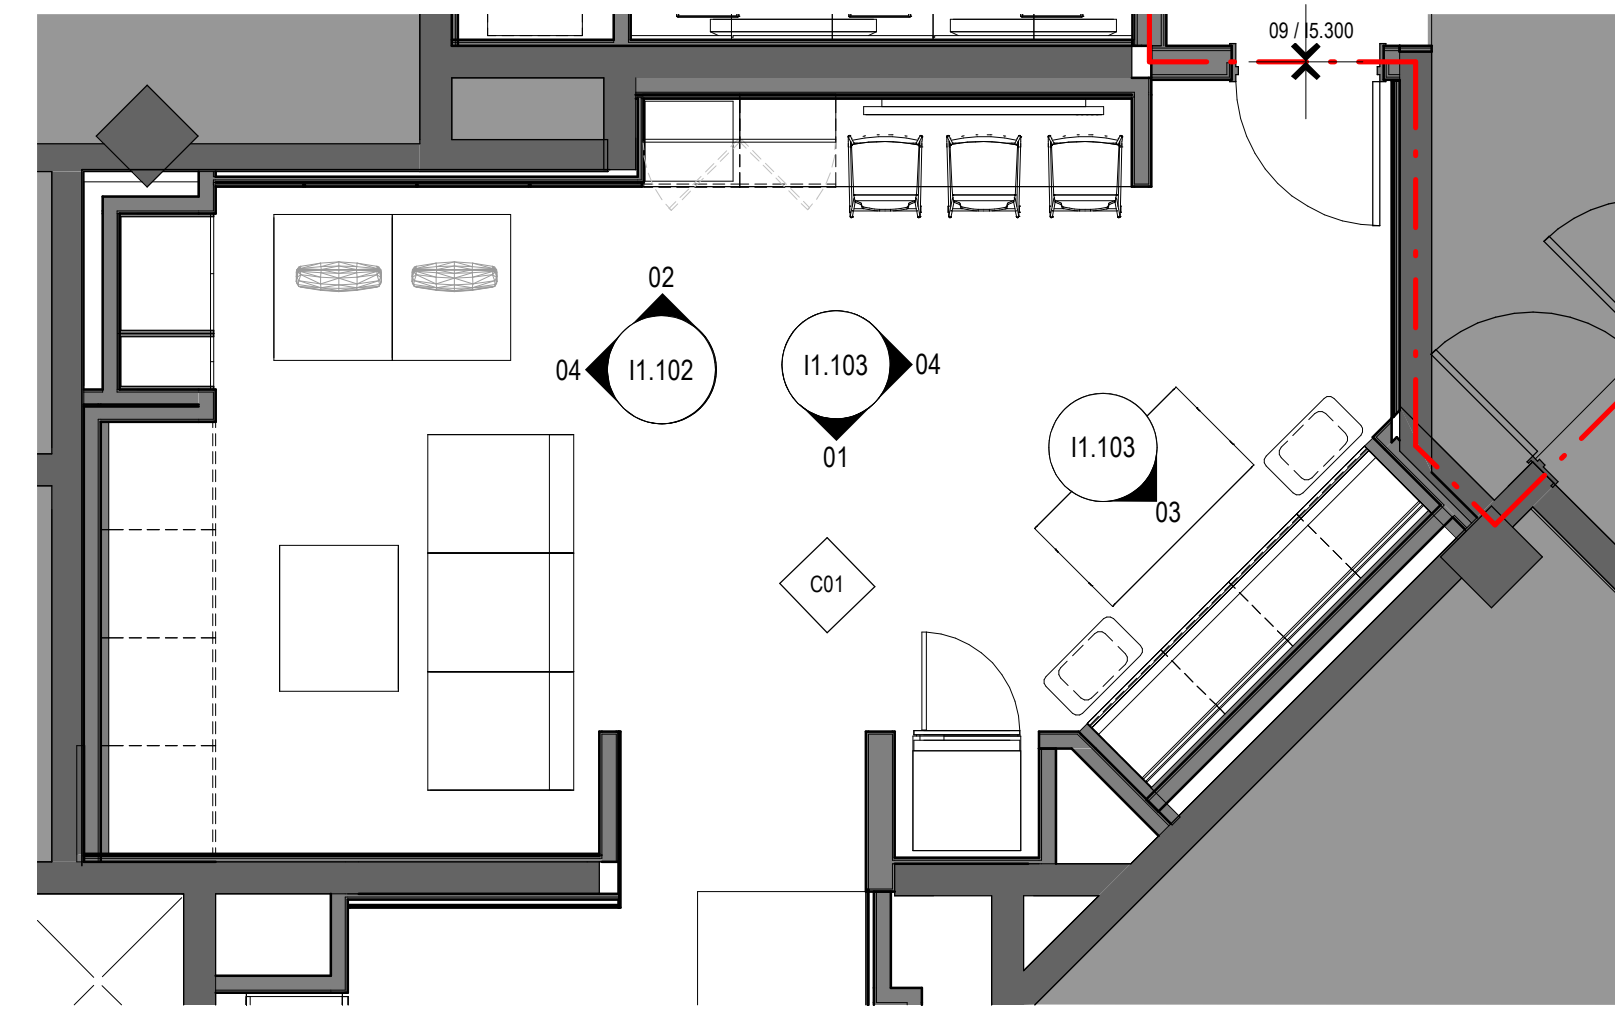

**05 ENLARGED FINISH & FURNITURE PLAN @ MEN'S LOUNGE**  
SCALE: 1/4" = 1'-0"

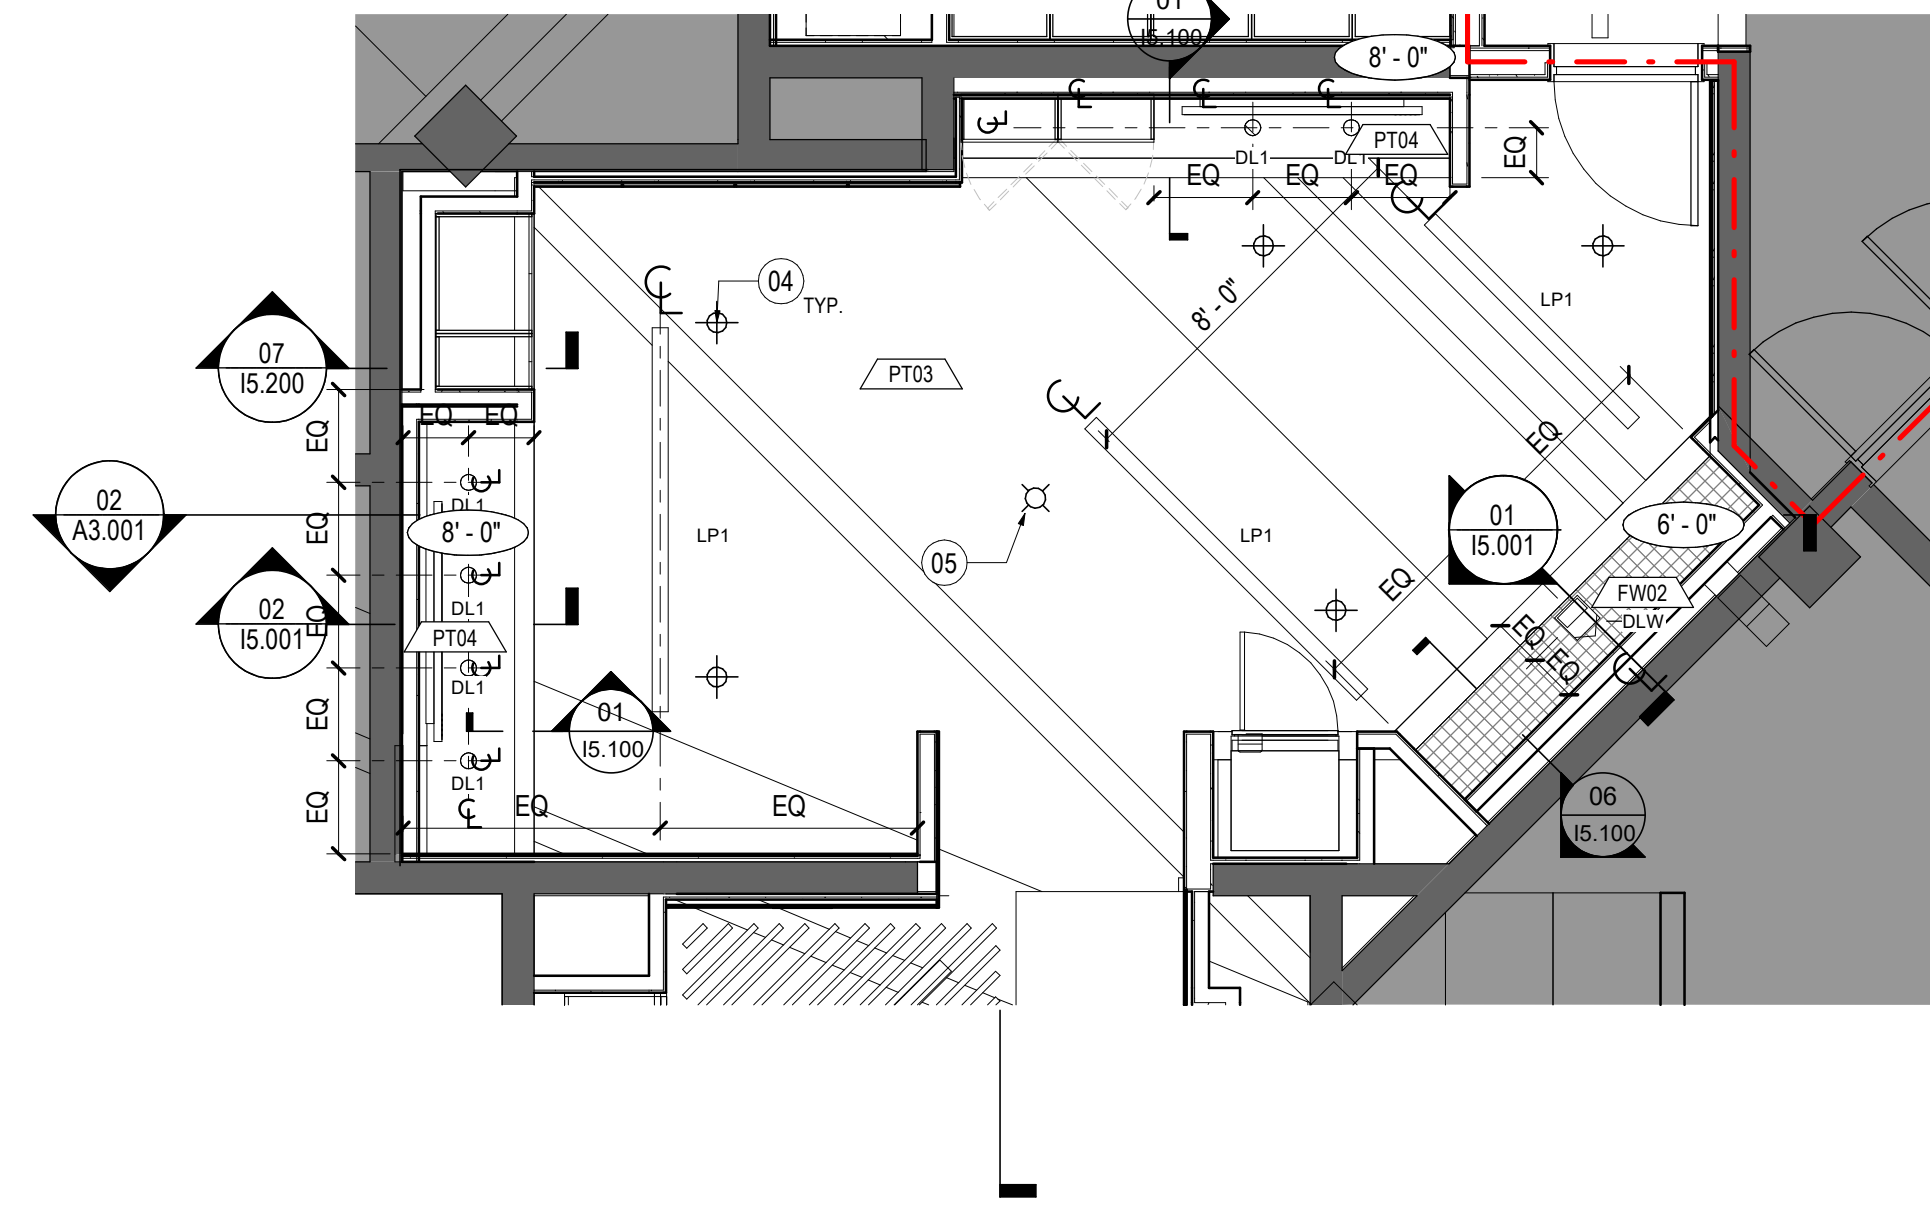

**03 ENLARGED RCP @ MEN'S LOUNGE**  
SCALE: 1/4" = 1'-0"

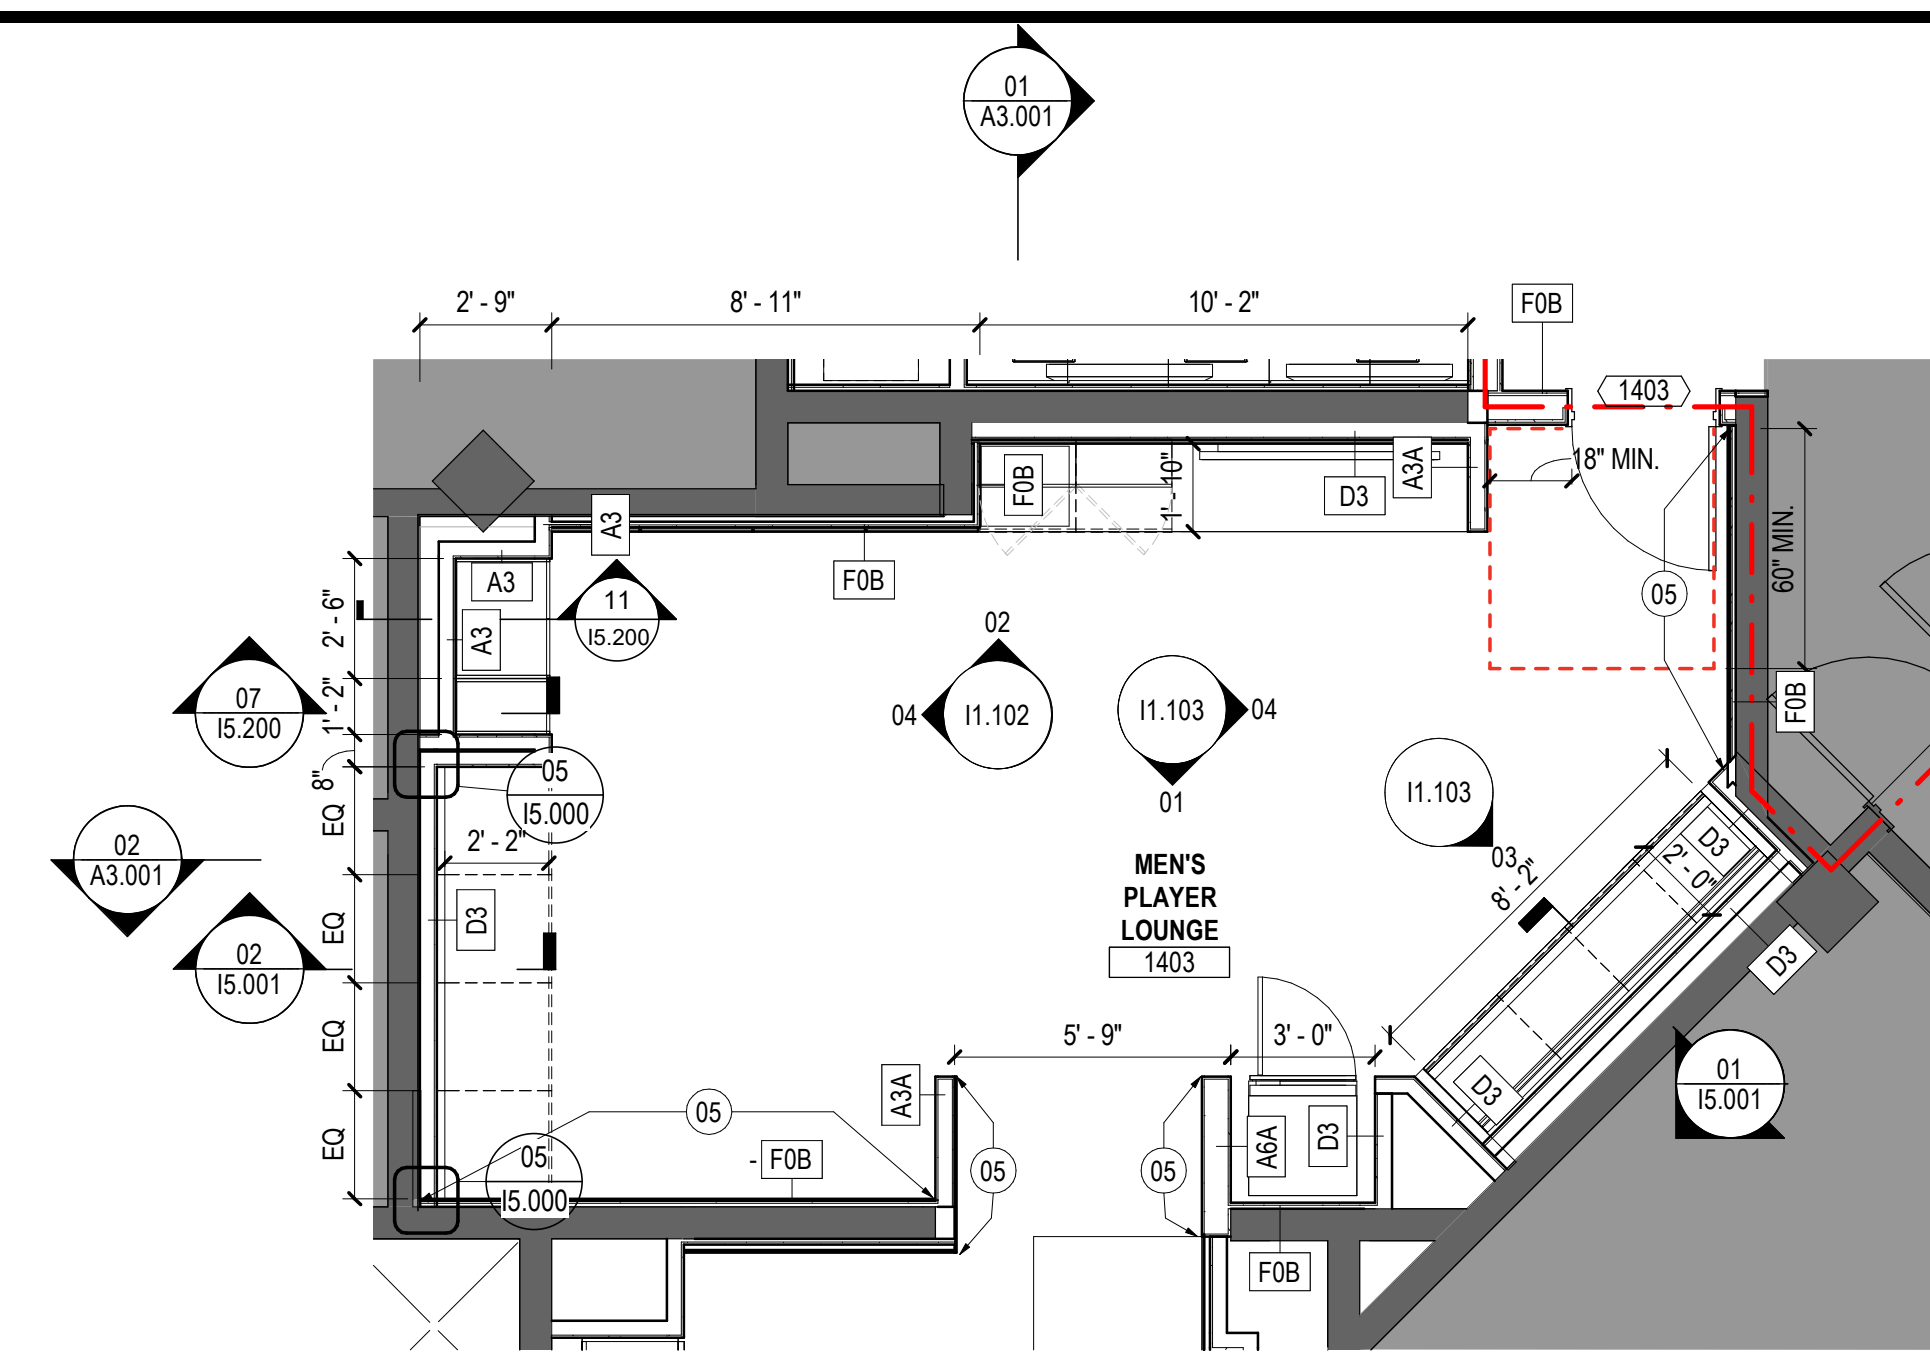

**01 ENLARGED PLAN @ MEN'S LOUNGE**  
SCALE: 1/4" = 1'-0"

**SHEET NOTES**

- ENLARGED PLAN**
- 01 EXISTING RESTROOM AND SHOWER CEILING TO REMAIN. CONTRACTOR TO VERIFY NEW DOOR HEIGHT WITH EXISTING CEILINGS IN FIELD.
  - 03 PROVIDE ONE ADA LOCKER PER LOCKER ROOM. OPERATIONAL MODIFICATIONS TO BE MADE TO ADA LOCKER. PERSONAL ITEMS CABINET WITH DIGILOCK AND USB/OUTLET CHARGING TO BE LOCATED AT ADA REACH HEIGHT; HANGING ROD TO BE LOCATED AT ADA REACH HEIGHT. PERSONAL HANGING CLOSER DOOR AT ADA REACH HEIGHT AND VANITY WITHIN TO BE LOCATED AT ADA REACH HEIGHT; ALL HANDLES ON ADA LOCKER DRAWERS TO BE LOCATED AT ADA REACH HEIGHT.
  - 04 CARPET WITH CURTAIN LINEN AT FRONT TYPE DIAMANTE SERIAL XBOVD.
  - 05 POTENTIAL FUTURE GRAPHIC WALL; CONTRACTOR TO PREPARE WALL WITH LEVEL 05 FINISH.
- REFLECTED CEILING PLAN**
- 01 CONCEALED LED COVE FIXTURE WITH DIMMING CONTROLS.
  - 02 REFER TO ENLARGED PLANS AND ELEVATIONS FOR SPEAKER LOCATIONS AND MOUNTING HEIGHT.
  - 04 REFER TO FIRE PROTECTION DRAWINGS FOR LOCATION OF SPRINKLER HEADS.
  - 05 REFER TO ELECTRICAL DRAWINGS FOR LOCATION OF CEILING MOUNTED FIRE ALARM DEVICES.

**GENERAL NOTES**

- A. AREAS TONED IN GRAY ARE NOT IN CONTRACT.
- B. REFER TO SHEET G1.01 FOR GRAPHIC SYMBOLS AND ABBREVIATIONS.
- C. REFER TO SHEET G1.10 FOR TYPICAL MOUNTING HEIGHTS, AND LOCATION DIAGRAMS.
- D. ON TYPICAL FLOORS PATCH AND EXTEND RESILIENT BASE AS NECESSARY WITH NEW TO MATCH EXISTING.
- E. REFER TO SHEET 15.300. FOR TRANSITION AND BASE DETAILS.
- F. UNLESS NOTED OTHERWISE FINISHES TO BE:
  - a. WALL: PT01
  - b. WALL BASE: RB01
  - c. FLOOR: C01
  - d. GYP. BD: PT04
  - e. EXPOSED OPEN CEILING: PT03
- G. SEALANT AND CAULKING COLORS TO MATCH ADJACENT SURFACE.
- H. ALL ITEMS VISIBLE IN SPACE TO BE FINISHED. MISCELLANEOUS UNFINISHED ITEMS AND DEVICES TO BE REVISED WITH ARCHITECT AND OWNER FOR FINAL FINISH.
- I. UNLESS NOTED OTHERWISE ALIGN FLOORING TRANSITION WITH CENTERLINE OF DOOR. IF NO DOOR, ALIGN WITH FINISHED BASE.
- J. ALL COLOR FINISHES FOR TRANSITION STRIPS TO BE SELECTED BY ARCHITECT PRIOR TO MANUFACTURE AND INSTALLATION.
- K. UNLESS NOTED OTHERWISE CONTINUE SCHEDULED FLOORING UNDER MILLWORK.
- L. COVER PLATES TO BE STAINLESS STEEL. UNLESS NOTED OTHERWISE, REPLACE ANY EXISTING OUTLETS AND COVER PLATES THAT DO NOT MATCH NEW.
- M. FURNITURE PLANS ARE SHOWN FOR INFORMATION ONLY.
- N. GENERAL CONTRACTOR, FURNITURE VENDOR, ARCHITECT, AND OWNER TO REVIEW SCOPE RESPONSIBILITY PRIOR TO PROCUREMENT.
- O. REFER TO ENGINEERING AND CONSULTANT DRAWINGS FOR ADDITIONAL POWER AND COMMUNICATION REQUIREMENTS.
- P. INDICATED DIMENSIONS ARE TO THE CENTER LINE OF OUTLET OR SWITCH, OR CLUSTER OF OUTLETS OR SWITCHES, UNLESS OTHERWISE NOTED.
- Q. INSTALL OUTLETS ON OPPOSITE SIDES OF PARTITIONS IN SEPARATE STUD CAVITIES. DO NOT INSTALL BACK-TO-BACK.
- R. COVER PLATES TO BE STAINLESS STEEL. UNLESS NOTED OTHERWISE, REPLACE ANY EXISTING OUTLETS AND COVERPLATES THAT DO NOT MATCH NEW.
- S. ALL THROUGH PENETRATIONS TO MAINTAIN FIRE RESISTANCE RATING OR HORIZONTAL FIRE ASSEMBLY IN ACCORDANCE WITH CODE. PROVIDE UL NUMBER OF DEVICES WHERE APPROPRIATE.
- T. COORDINATE LOCATION OF ALL POWER AND COMMUNICATION DEVICES AND STUB UPS IN FIELD WITH FINAL FURNITURE PACKAGE AND FURNITURE VENDOR. THIS INCLUDES THE LOCATION COORDINATION OF THE FURNITURE IN-FEED WITH TABLE TOP BOX TERMINATION WITH FURNITURE AND AV VENDOR. ALL GROMMET LOCATIONS AT FURNITURE AND/OR MILLWORK WITH FURNITURE/MILLWORK VENDORS.
- U. ALL PENETRATION IN STRUCTURAL SLAB TO BE GFR OR X-RAY SCANNED AND APPROVED BY OWNER TO INSURE STRUCTURAL INTEGRITY OF SLAB.
- V. REFER TO ENLARGED PLANS AND ELEVATIONS FOR FURTHER OUTLET DIMENSIONS.



92 Catamount Road  
Cullowhee, NC 28723

**Gensler**  
2020 K St NW  
Washington, DC 20006  
United States  
Tel (202) 721-5200  
Fax +1 202.872.8587

**optima**  
engineering  
**MEP ENGINEERS**  
1927 South Tryon Street  
Suite 300  
Charlotte, NC 28203  
Tel 704.338.1292

SCO ID: 21-22998-01  
CIP: 42029

Date	Description
1 03/26/2021	DESIGN DEVELOPMENT - ISSUE FOR PRICING
2 04/19/2021	ISSUE FOR PERMIT
3 06/11/2021	ISSUE FOR PERMIT - RESUBMIT
4 10/18/2021	ISSUE FOR BID
6 11/30/2021	ADDENDUM 02

Seal / Signature


Project Name  
**RAMSEY - BASKETBALL LOCKER ROOM RENOVATION**

Project Number  
**009.9478.000**


Description  
ENLARGED PLAN, RCP & INTERIOR ELEVATIONS OF MEN'S LOUNGE

Scale  
As indicated

**11.102**

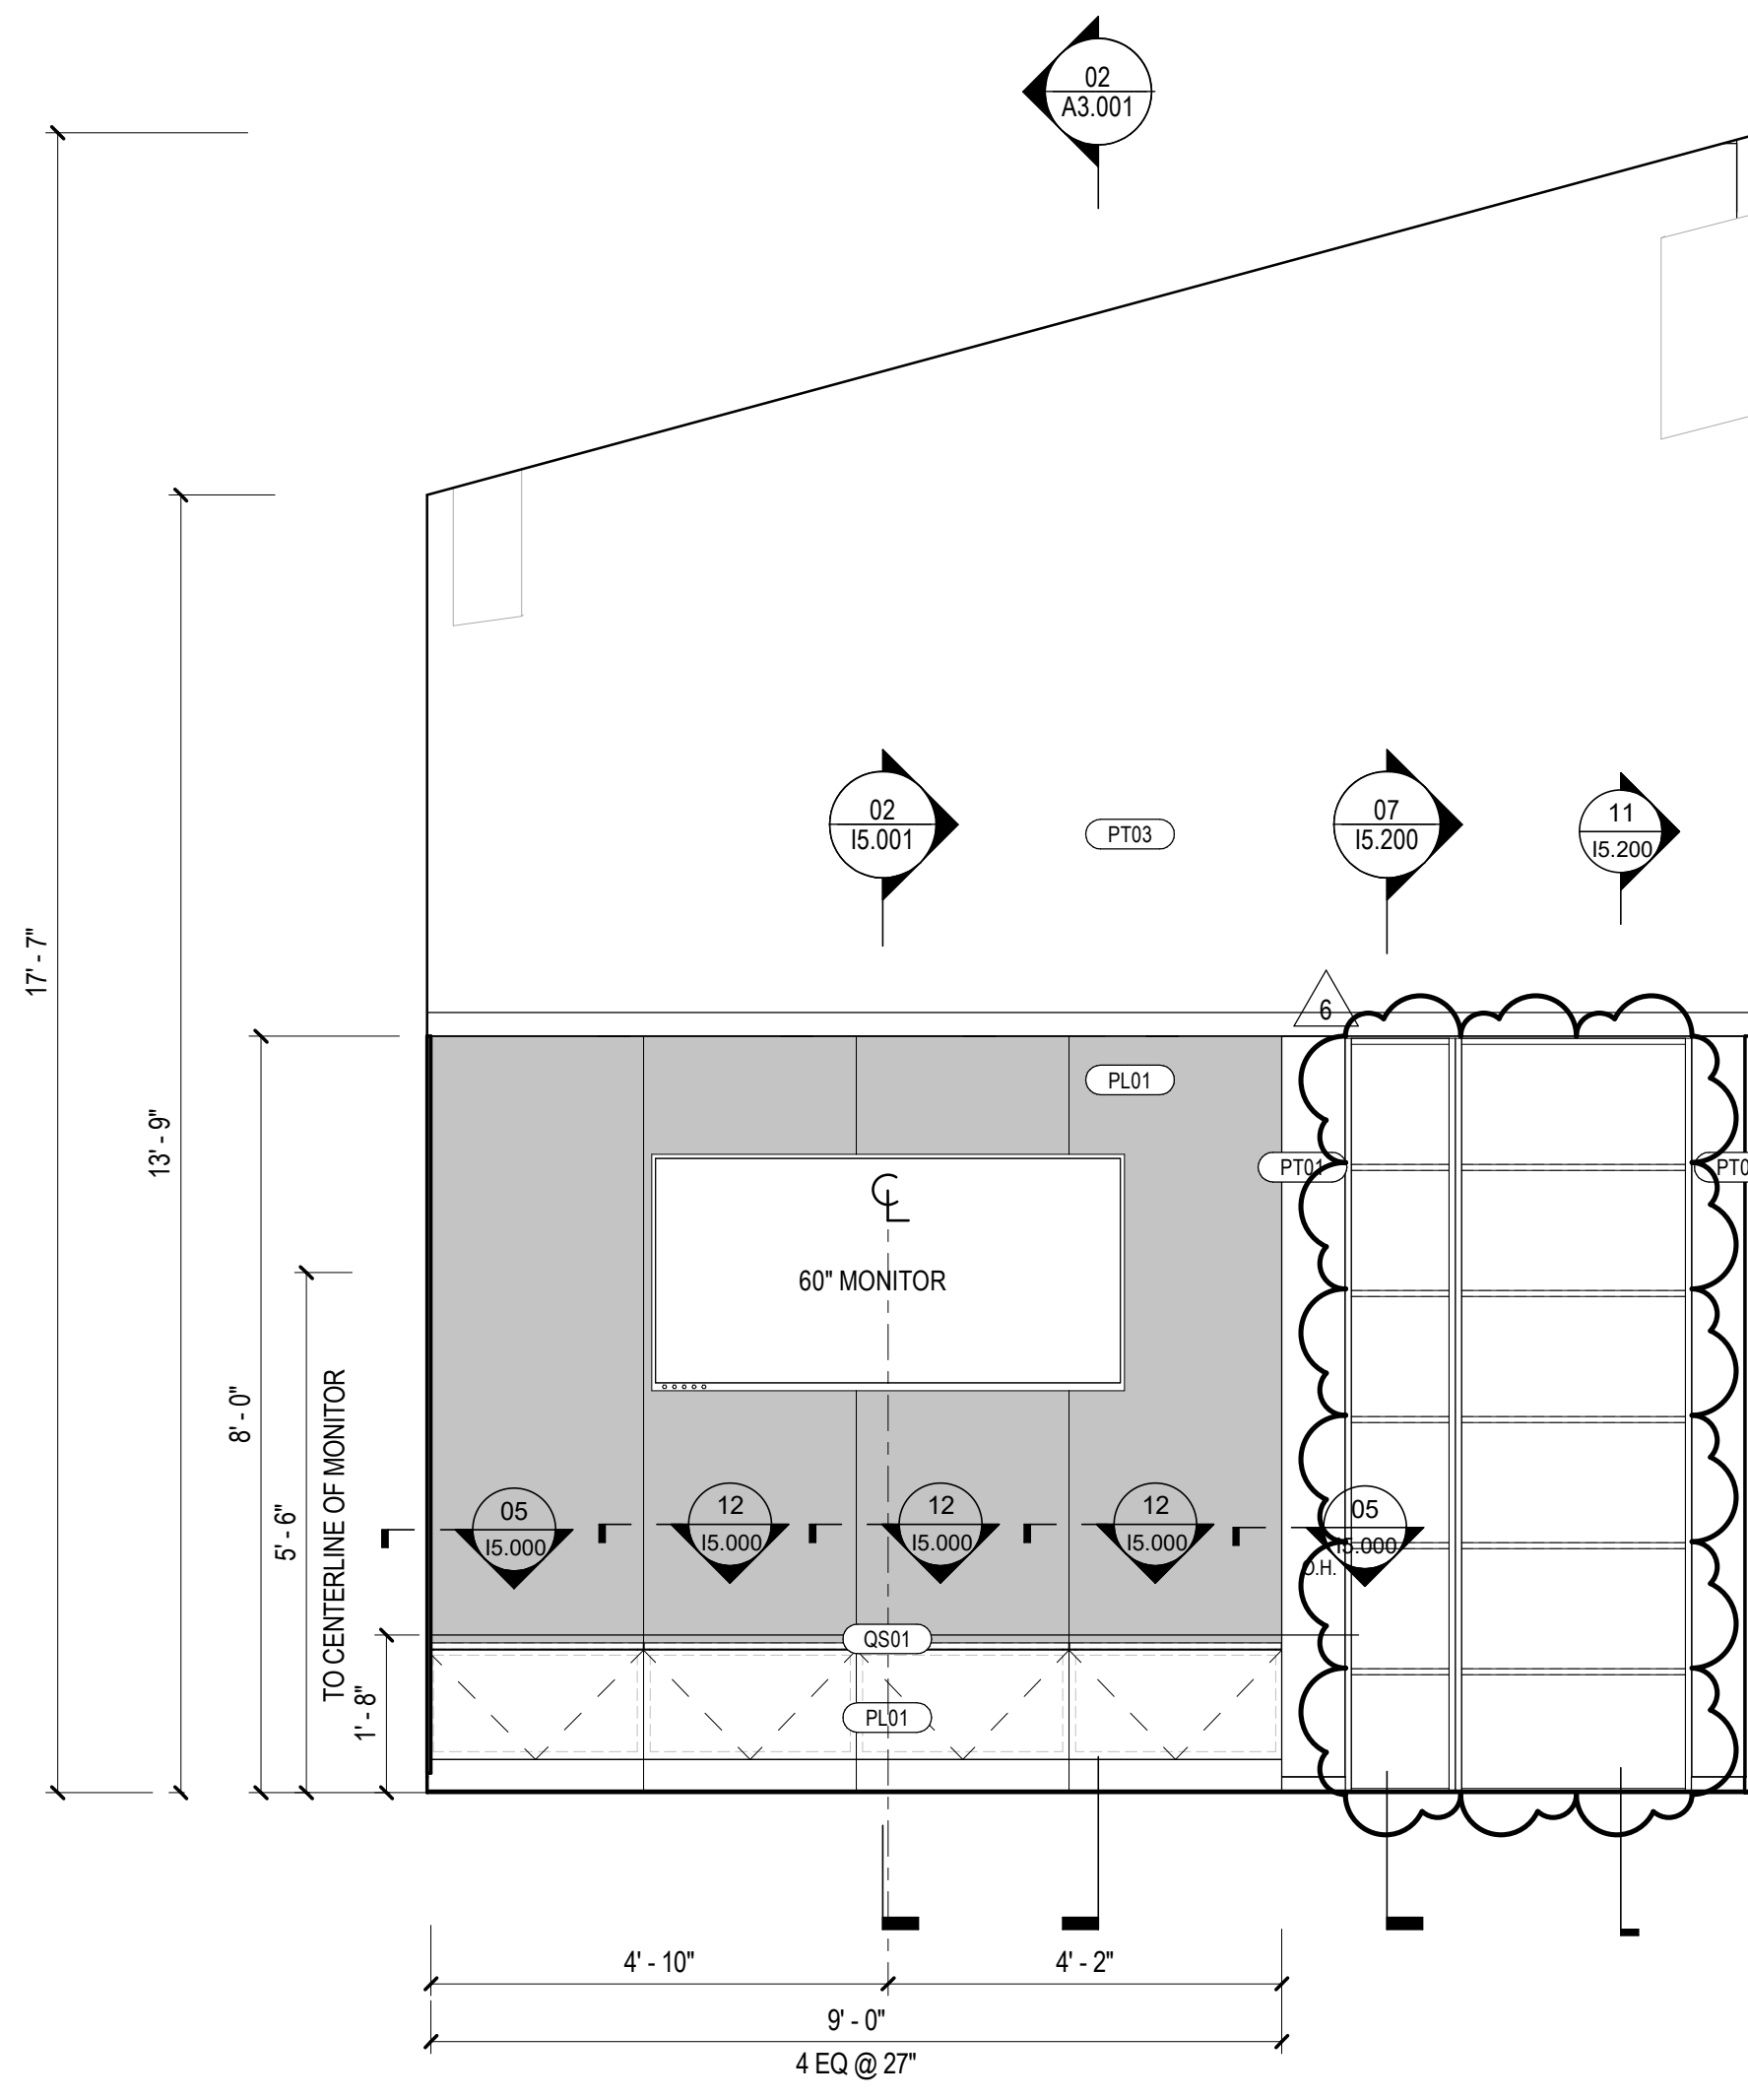


**04 ELEVATION @ MEN'S PLAYER LOUNGE WEST**  
SCALE: 1/2" = 1'-0"

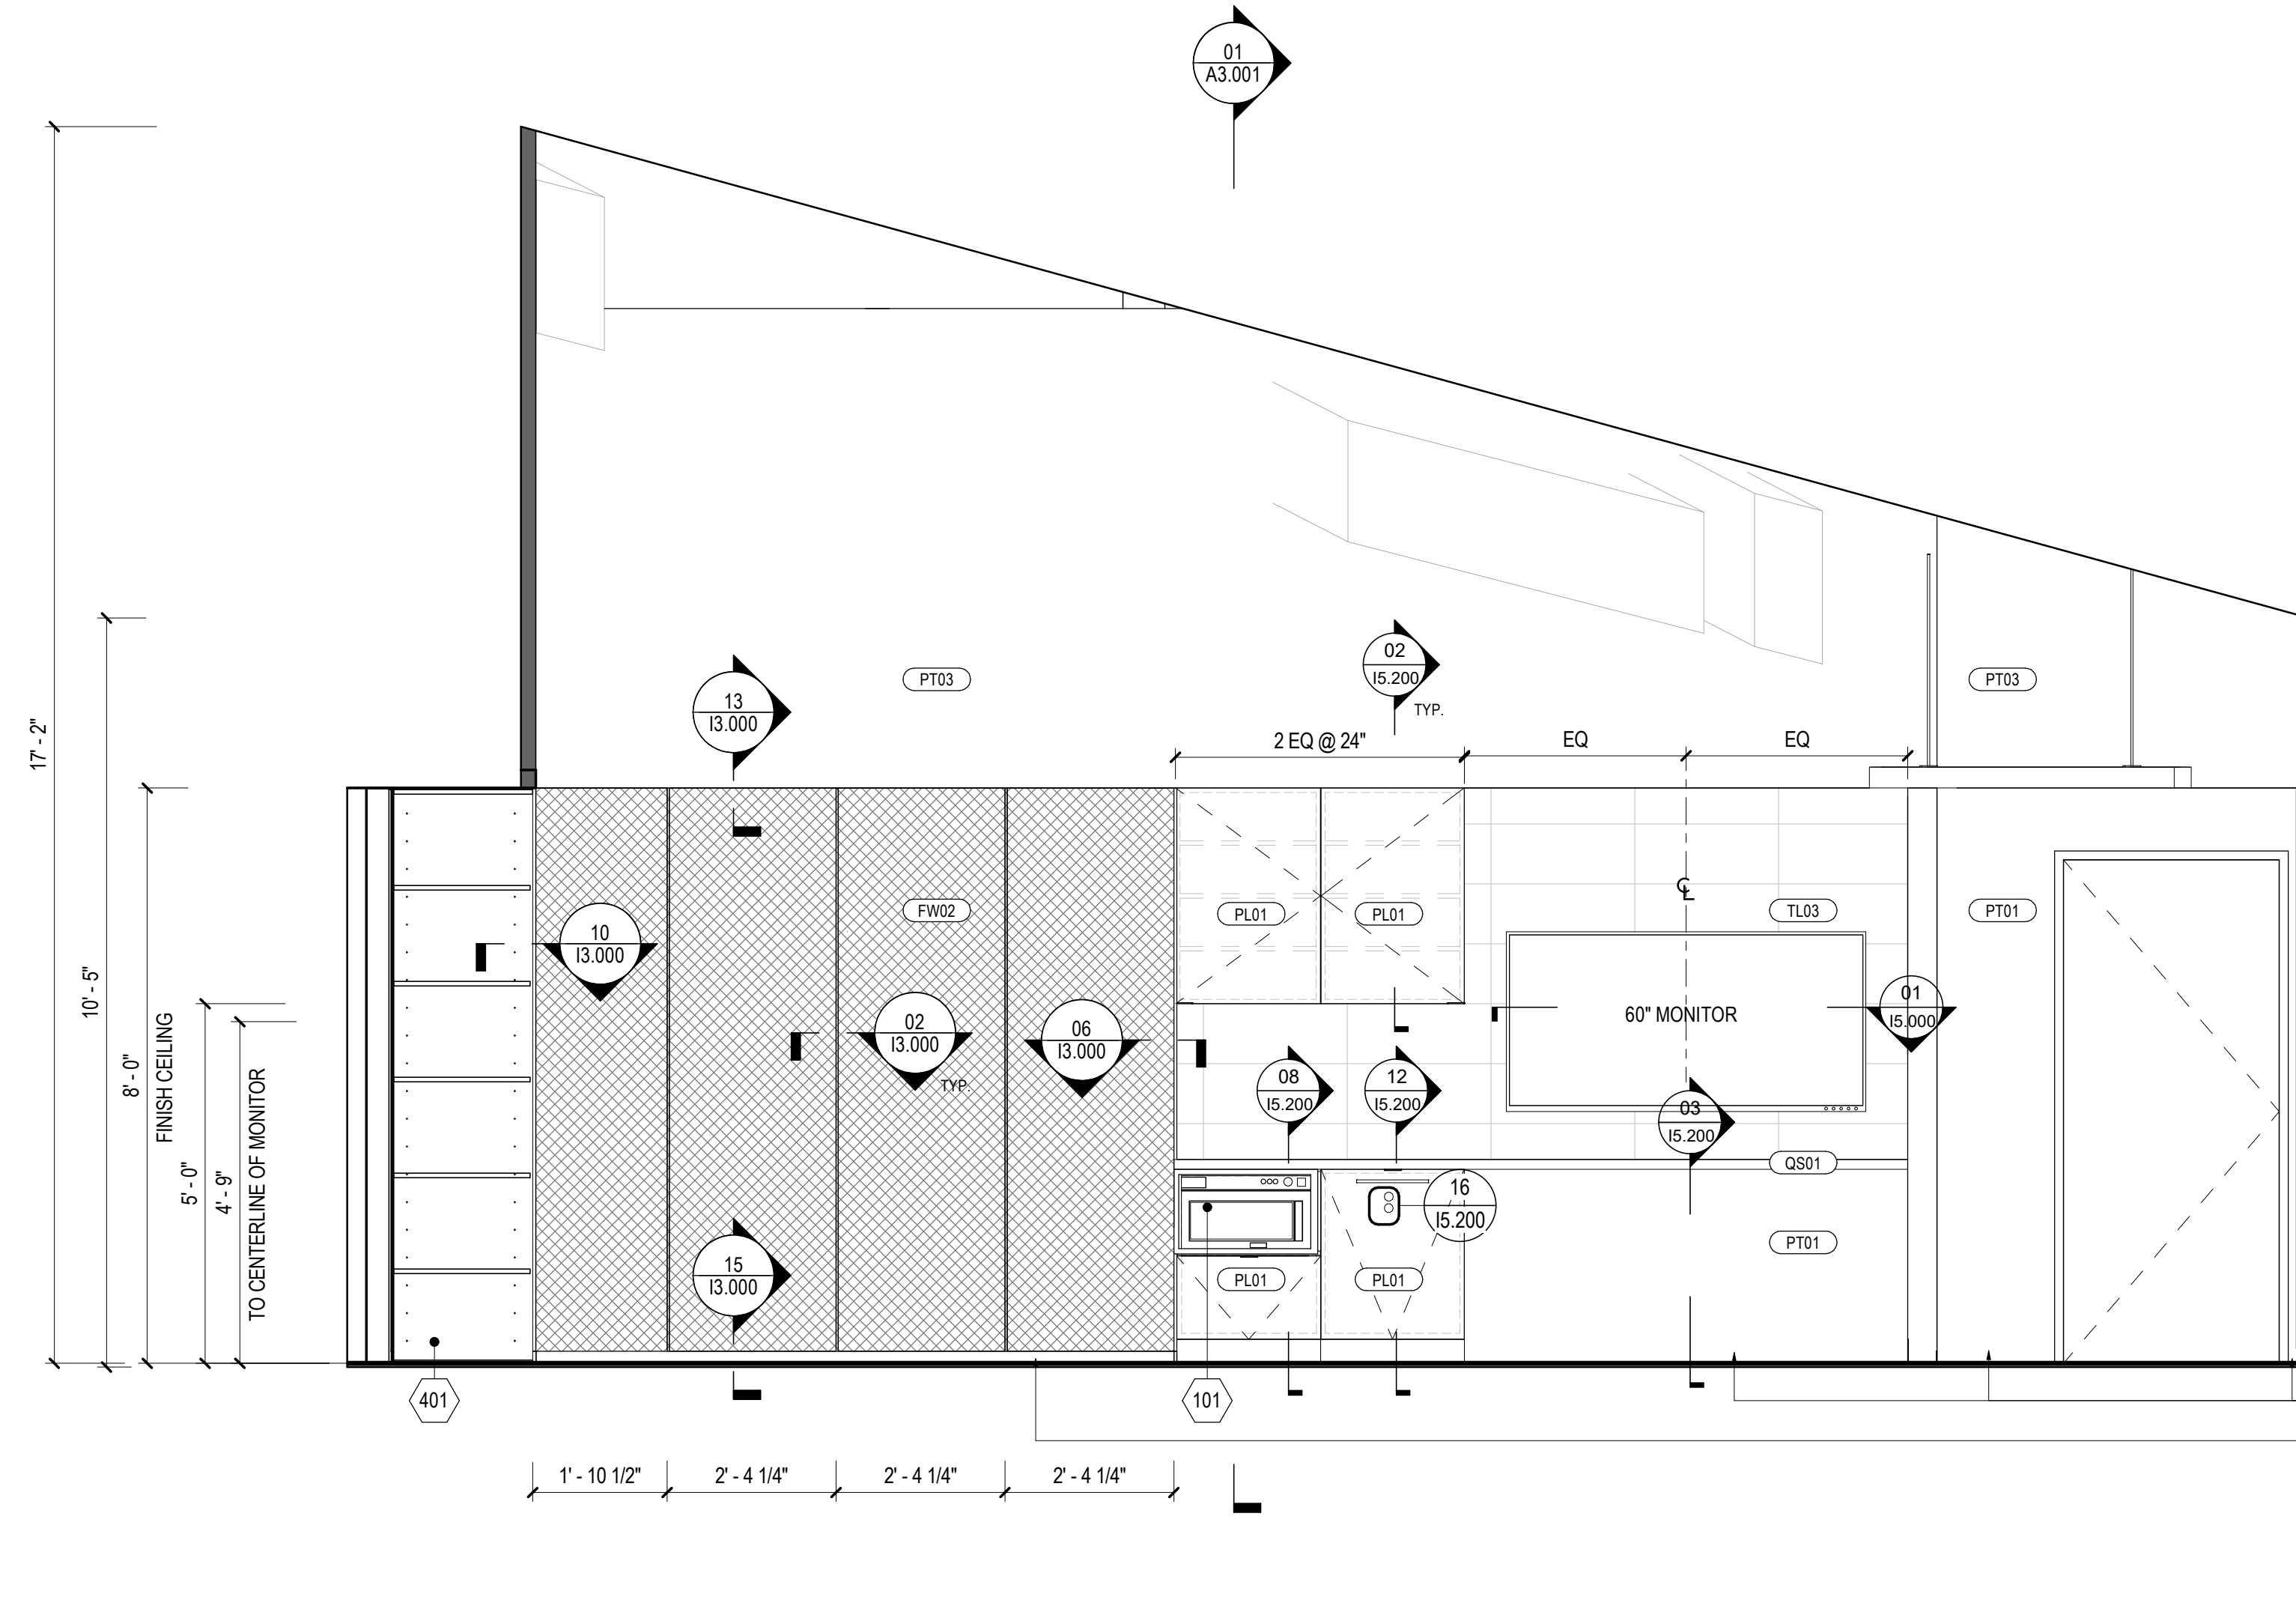


**02 ELEVATION @ MEN'S PLAYER LOUNGE NORTH**  
SCALE: 1/2" = 1'-0"




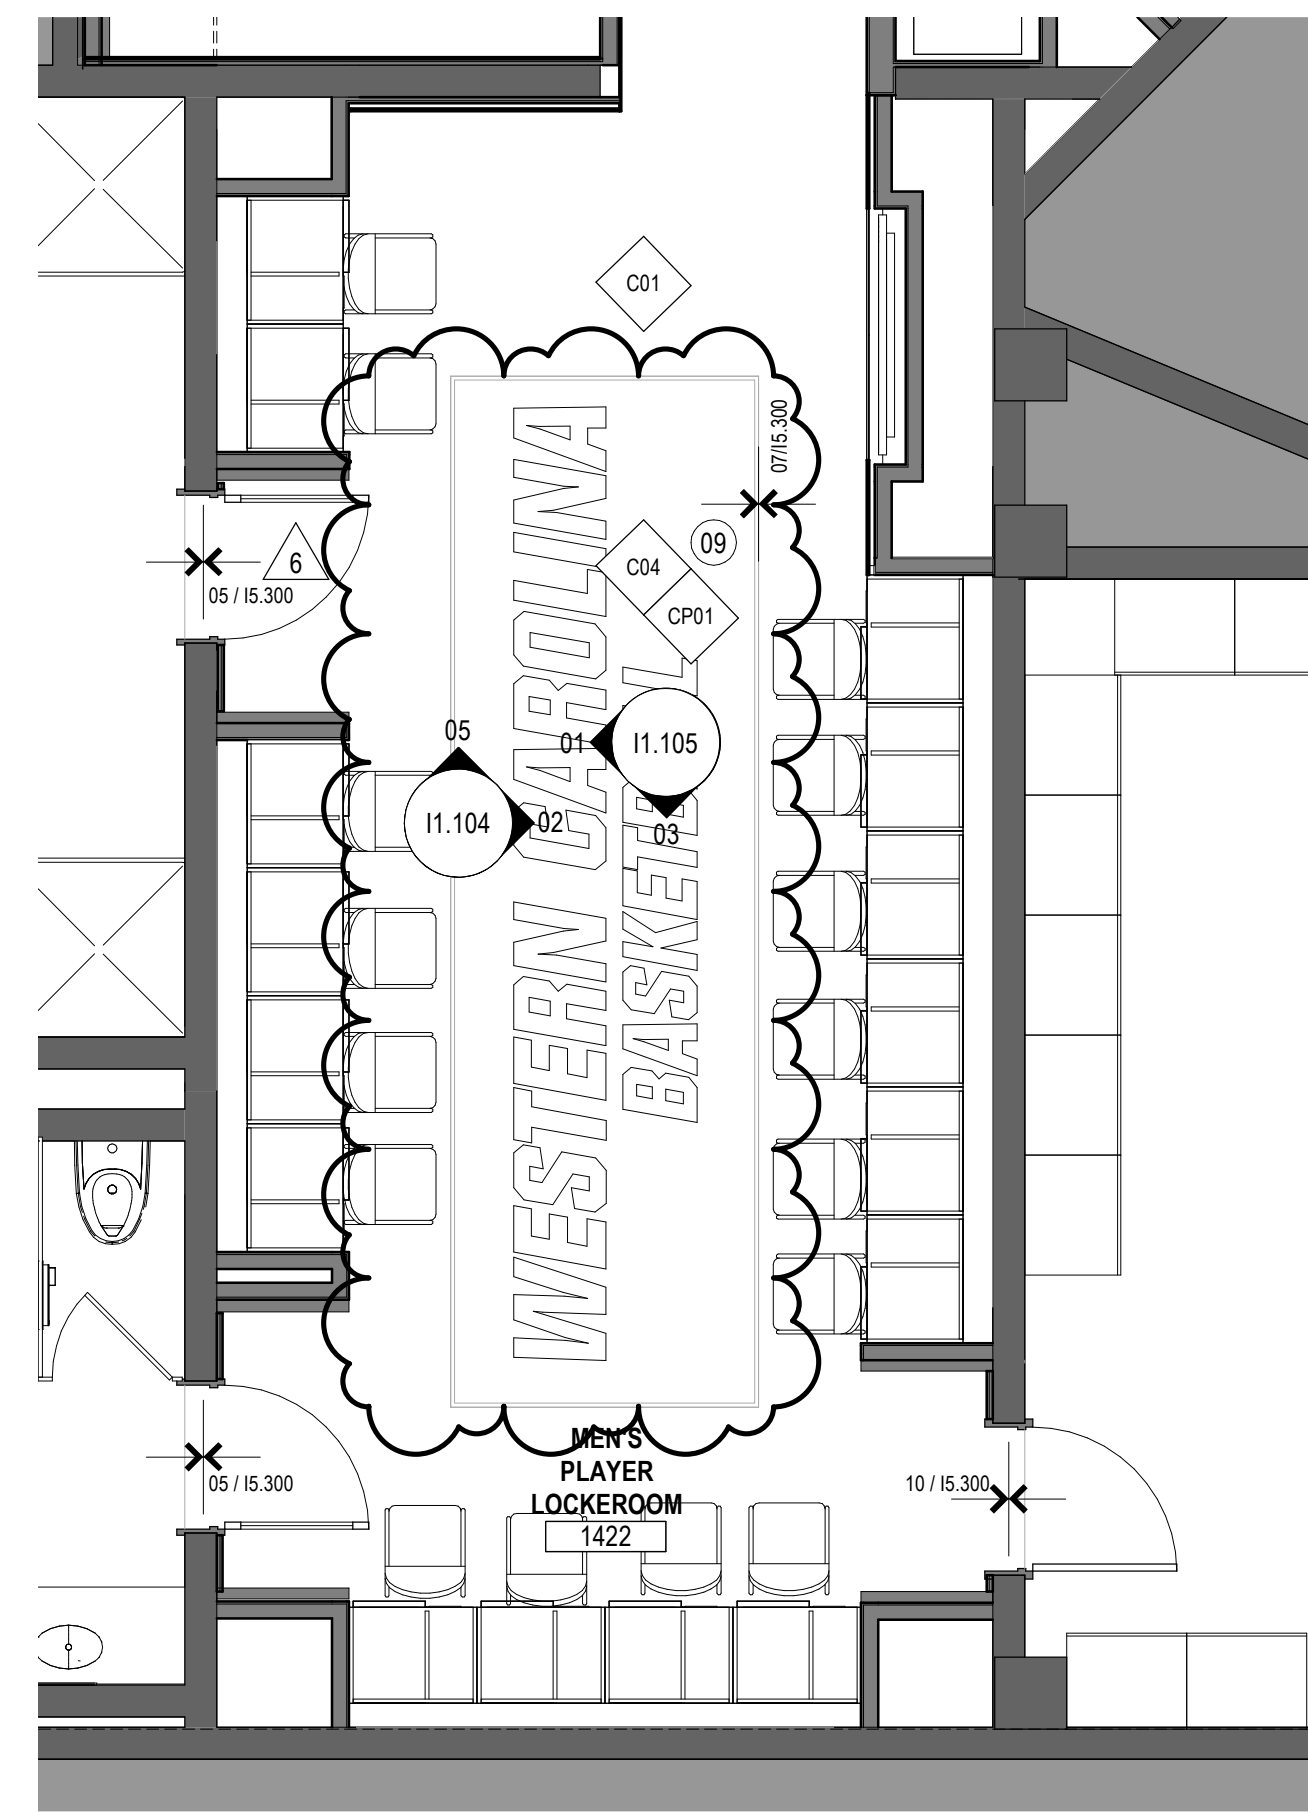


**07 ENLARGED FINISH & FURNITURE PLAN @ MEN'S LOCKER**  
SCALE: 1/4" = 1'-0"

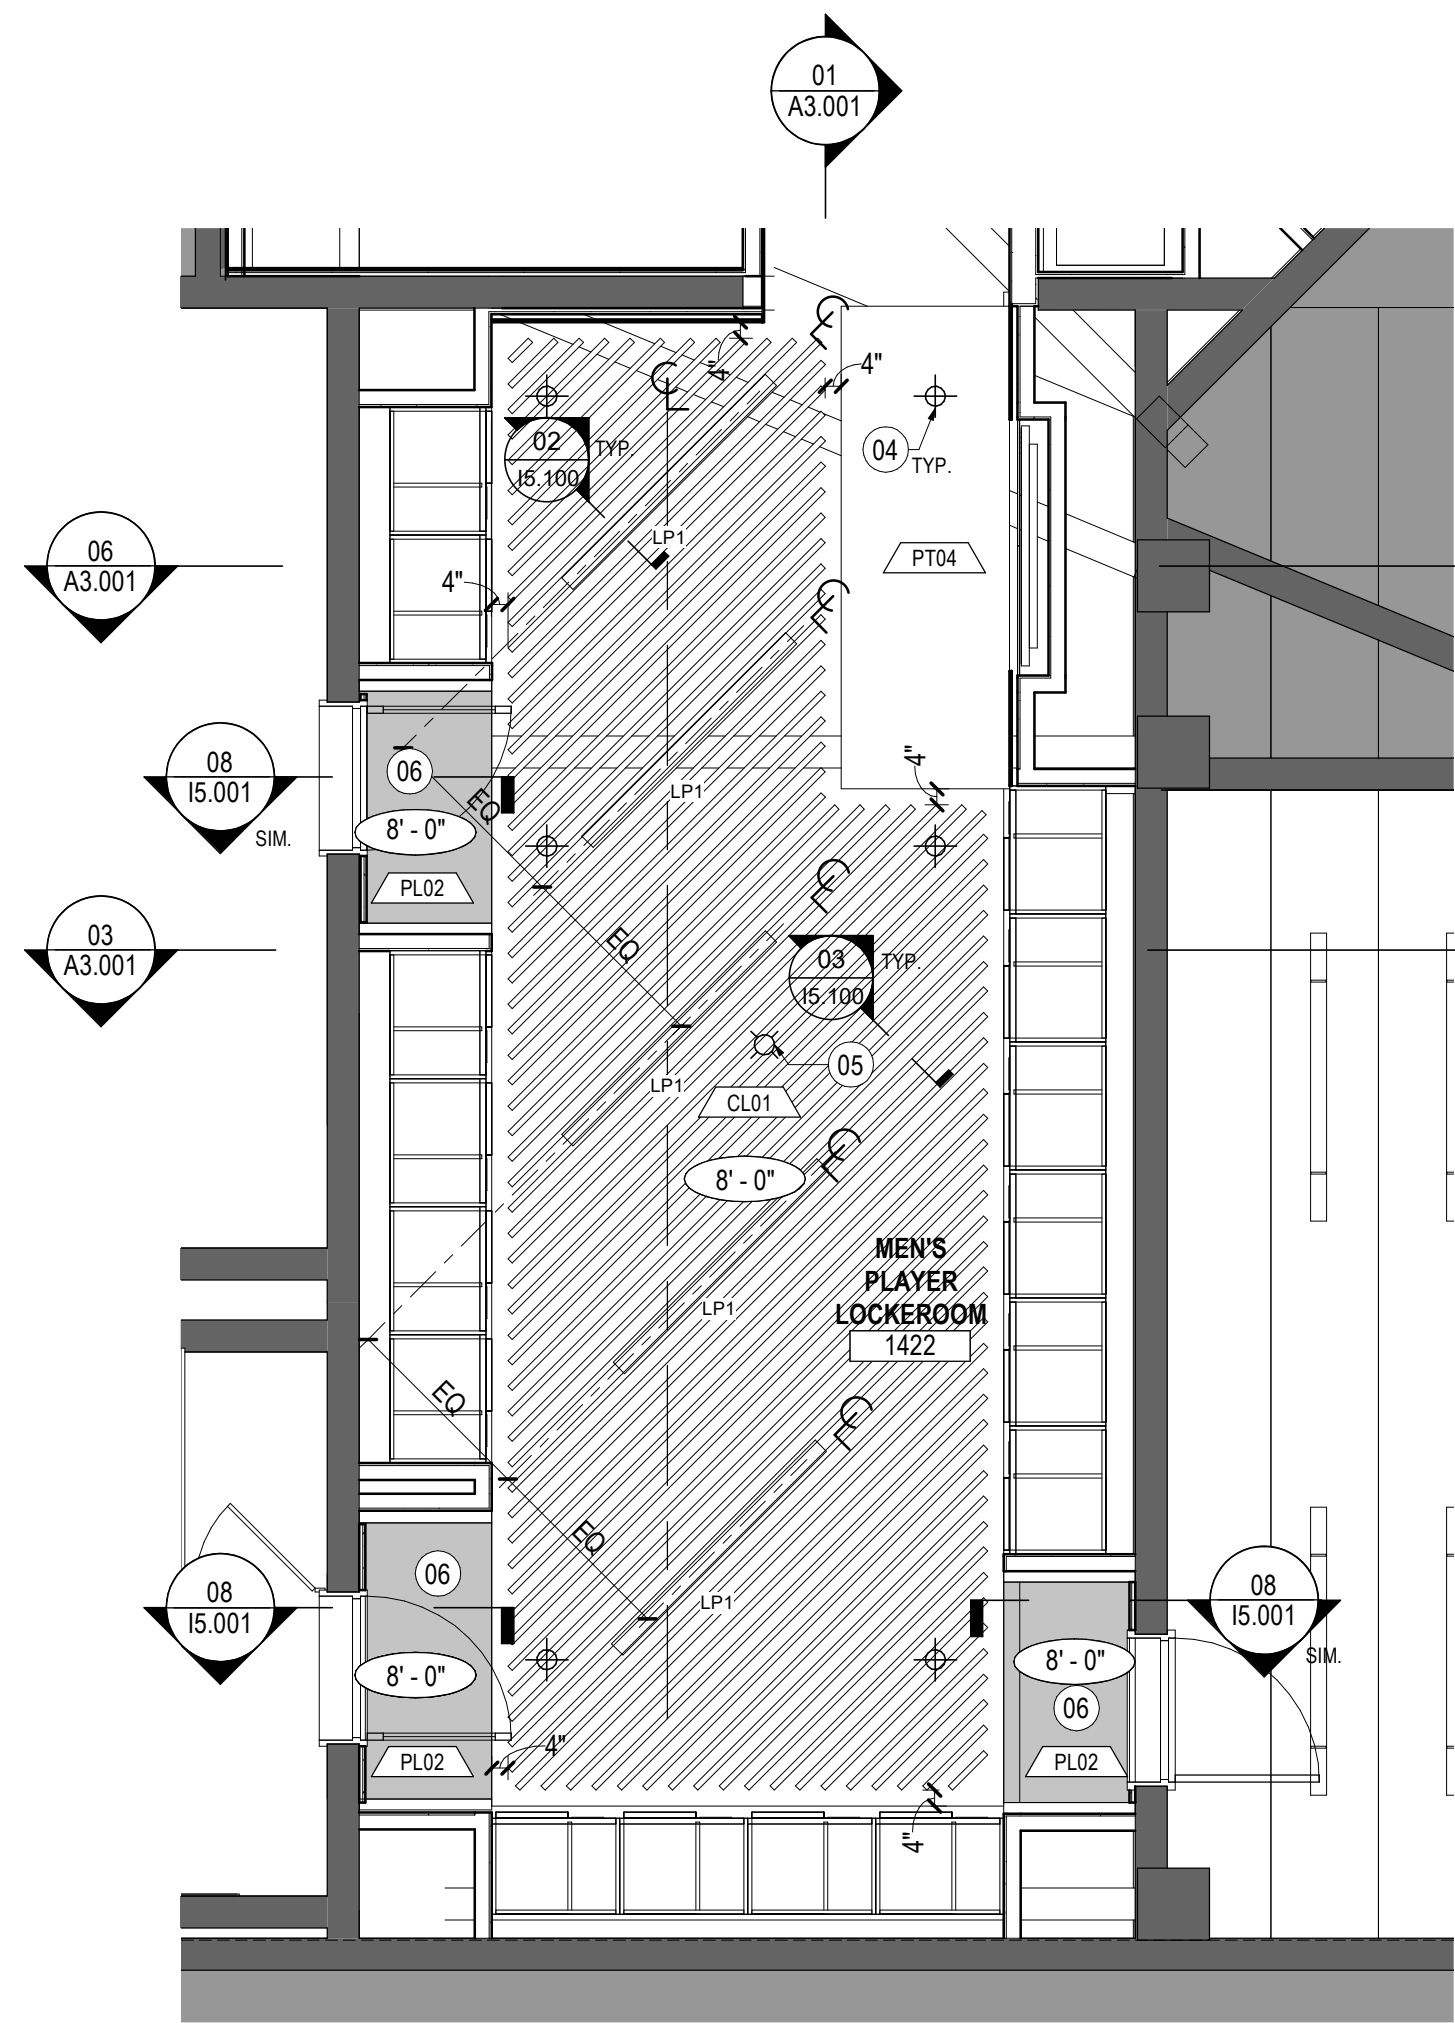


**04 ENLARGED RCP @ MEN'S LOCKER**  
SCALE: 1/4" = 1'-0"

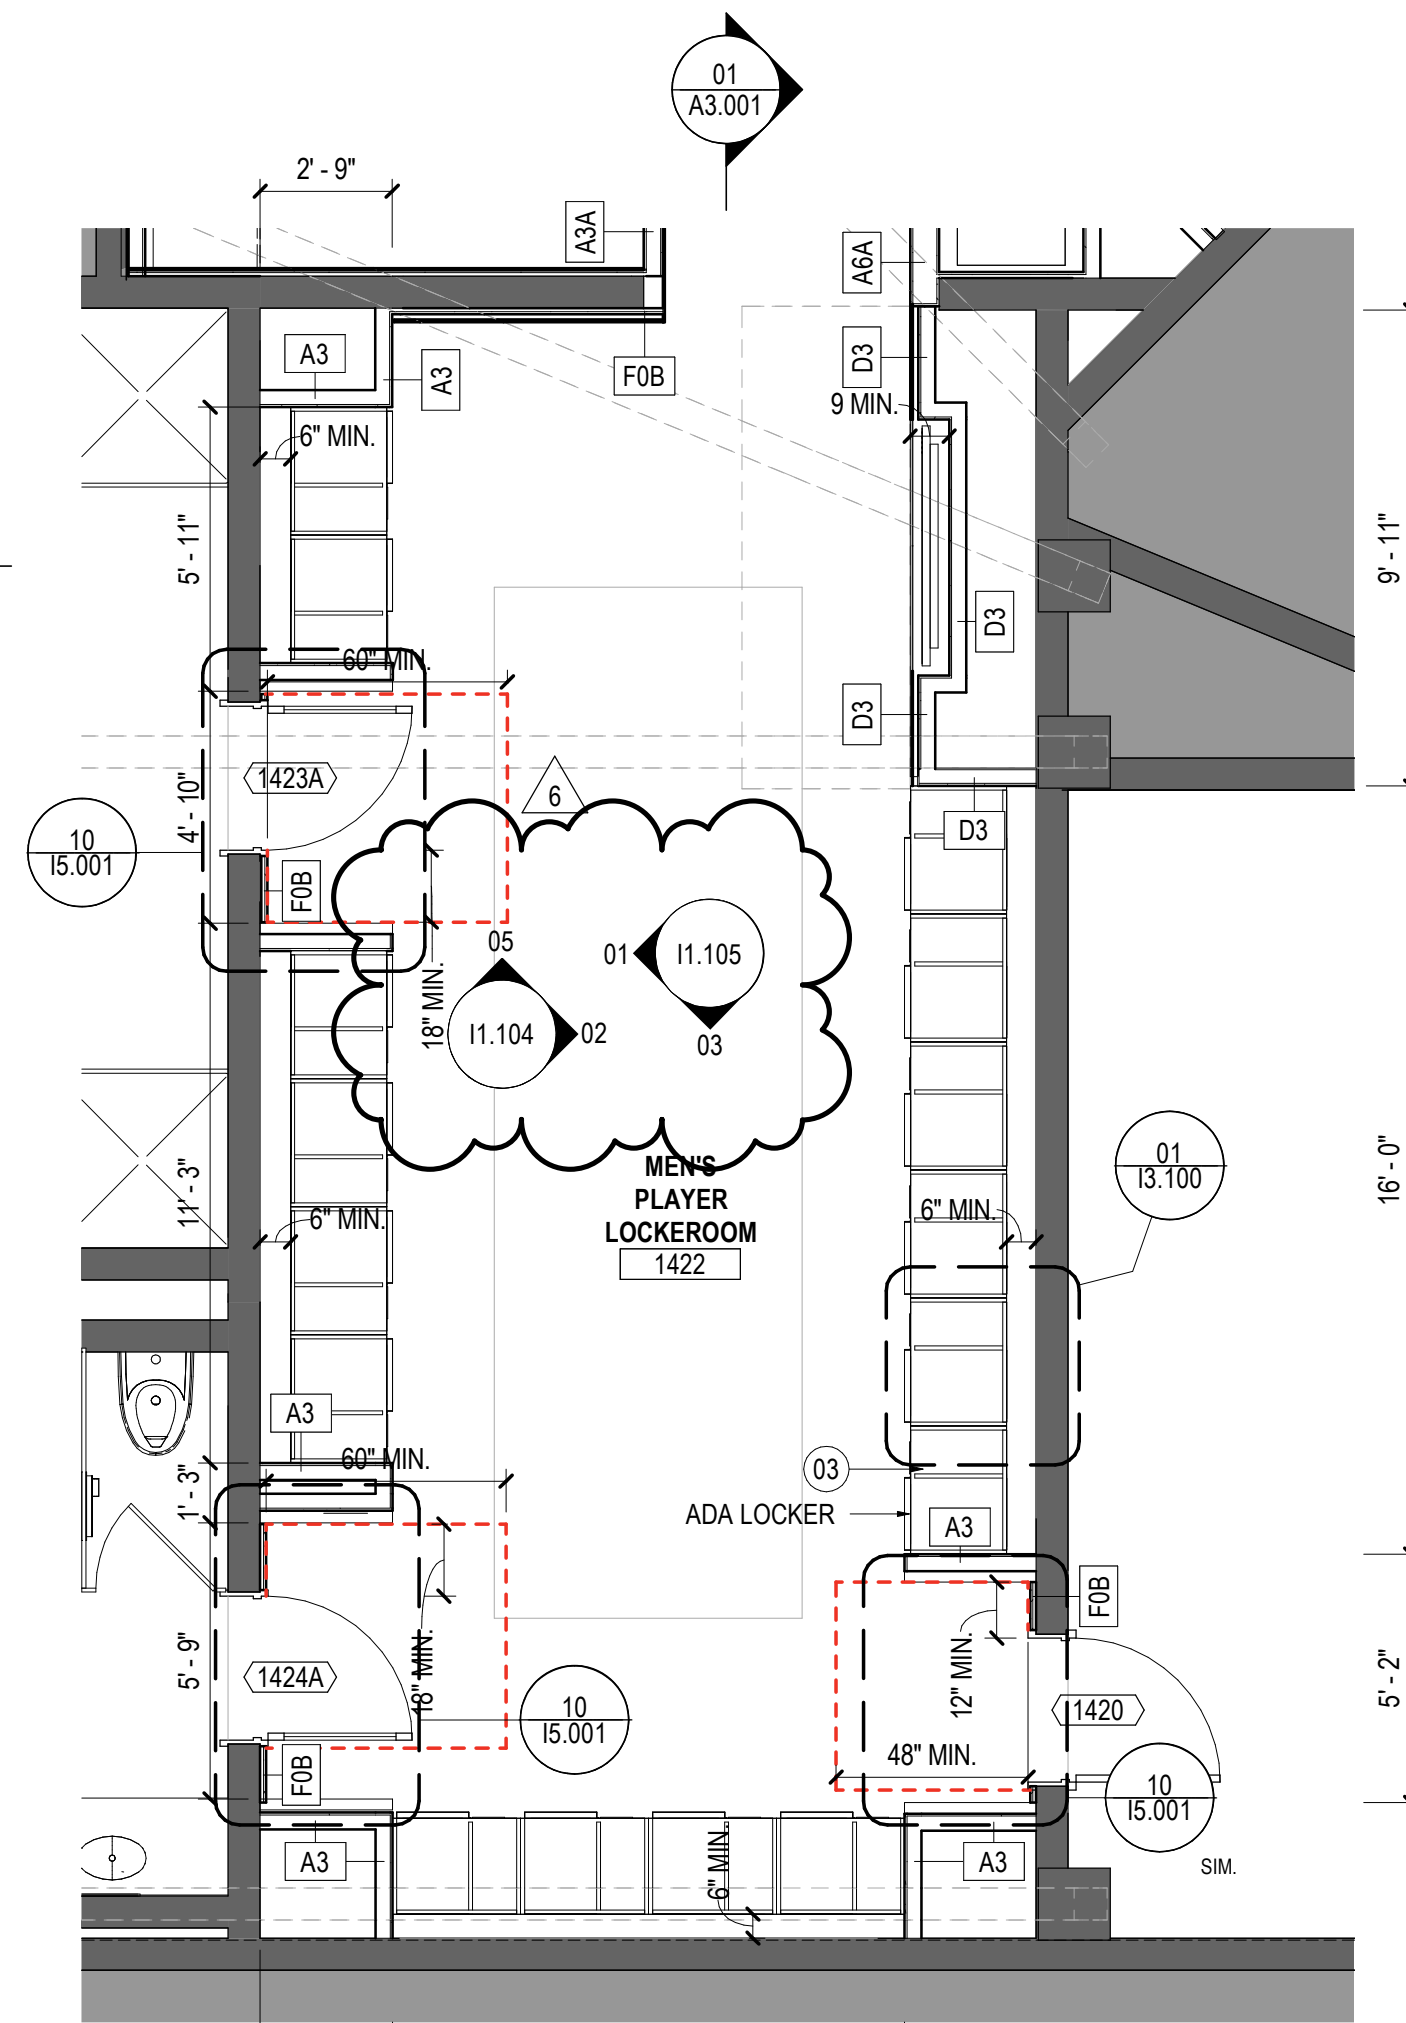

**01 ENLARGED PLAN @ MEN'S LOCKER**  
SCALE: 1/4" = 1'-0"

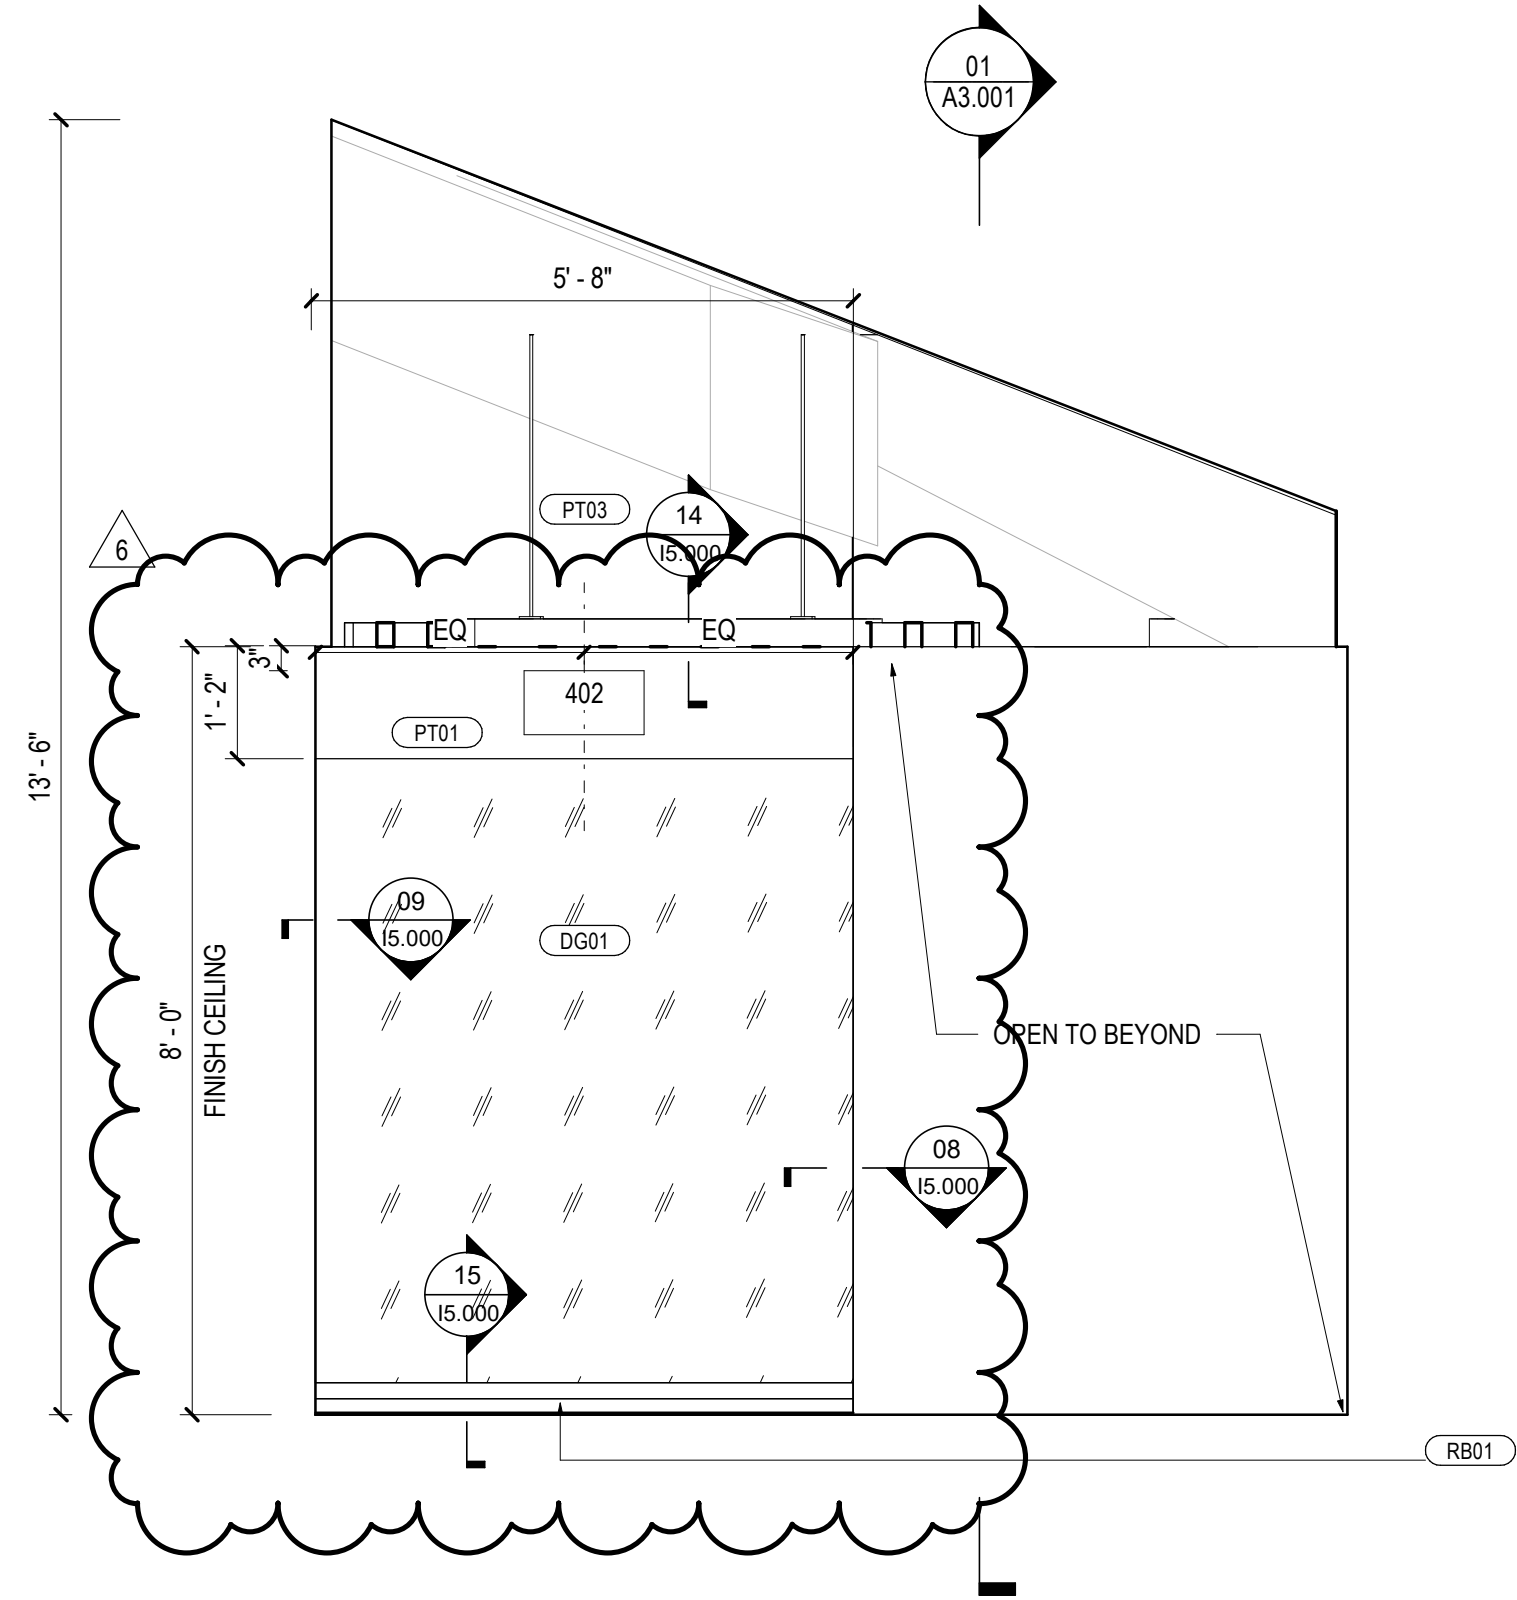

**05 ELEVATION @ MEN'S LOCKER ROOM NORTH**  
SCALE: 1/2" = 1'-0"

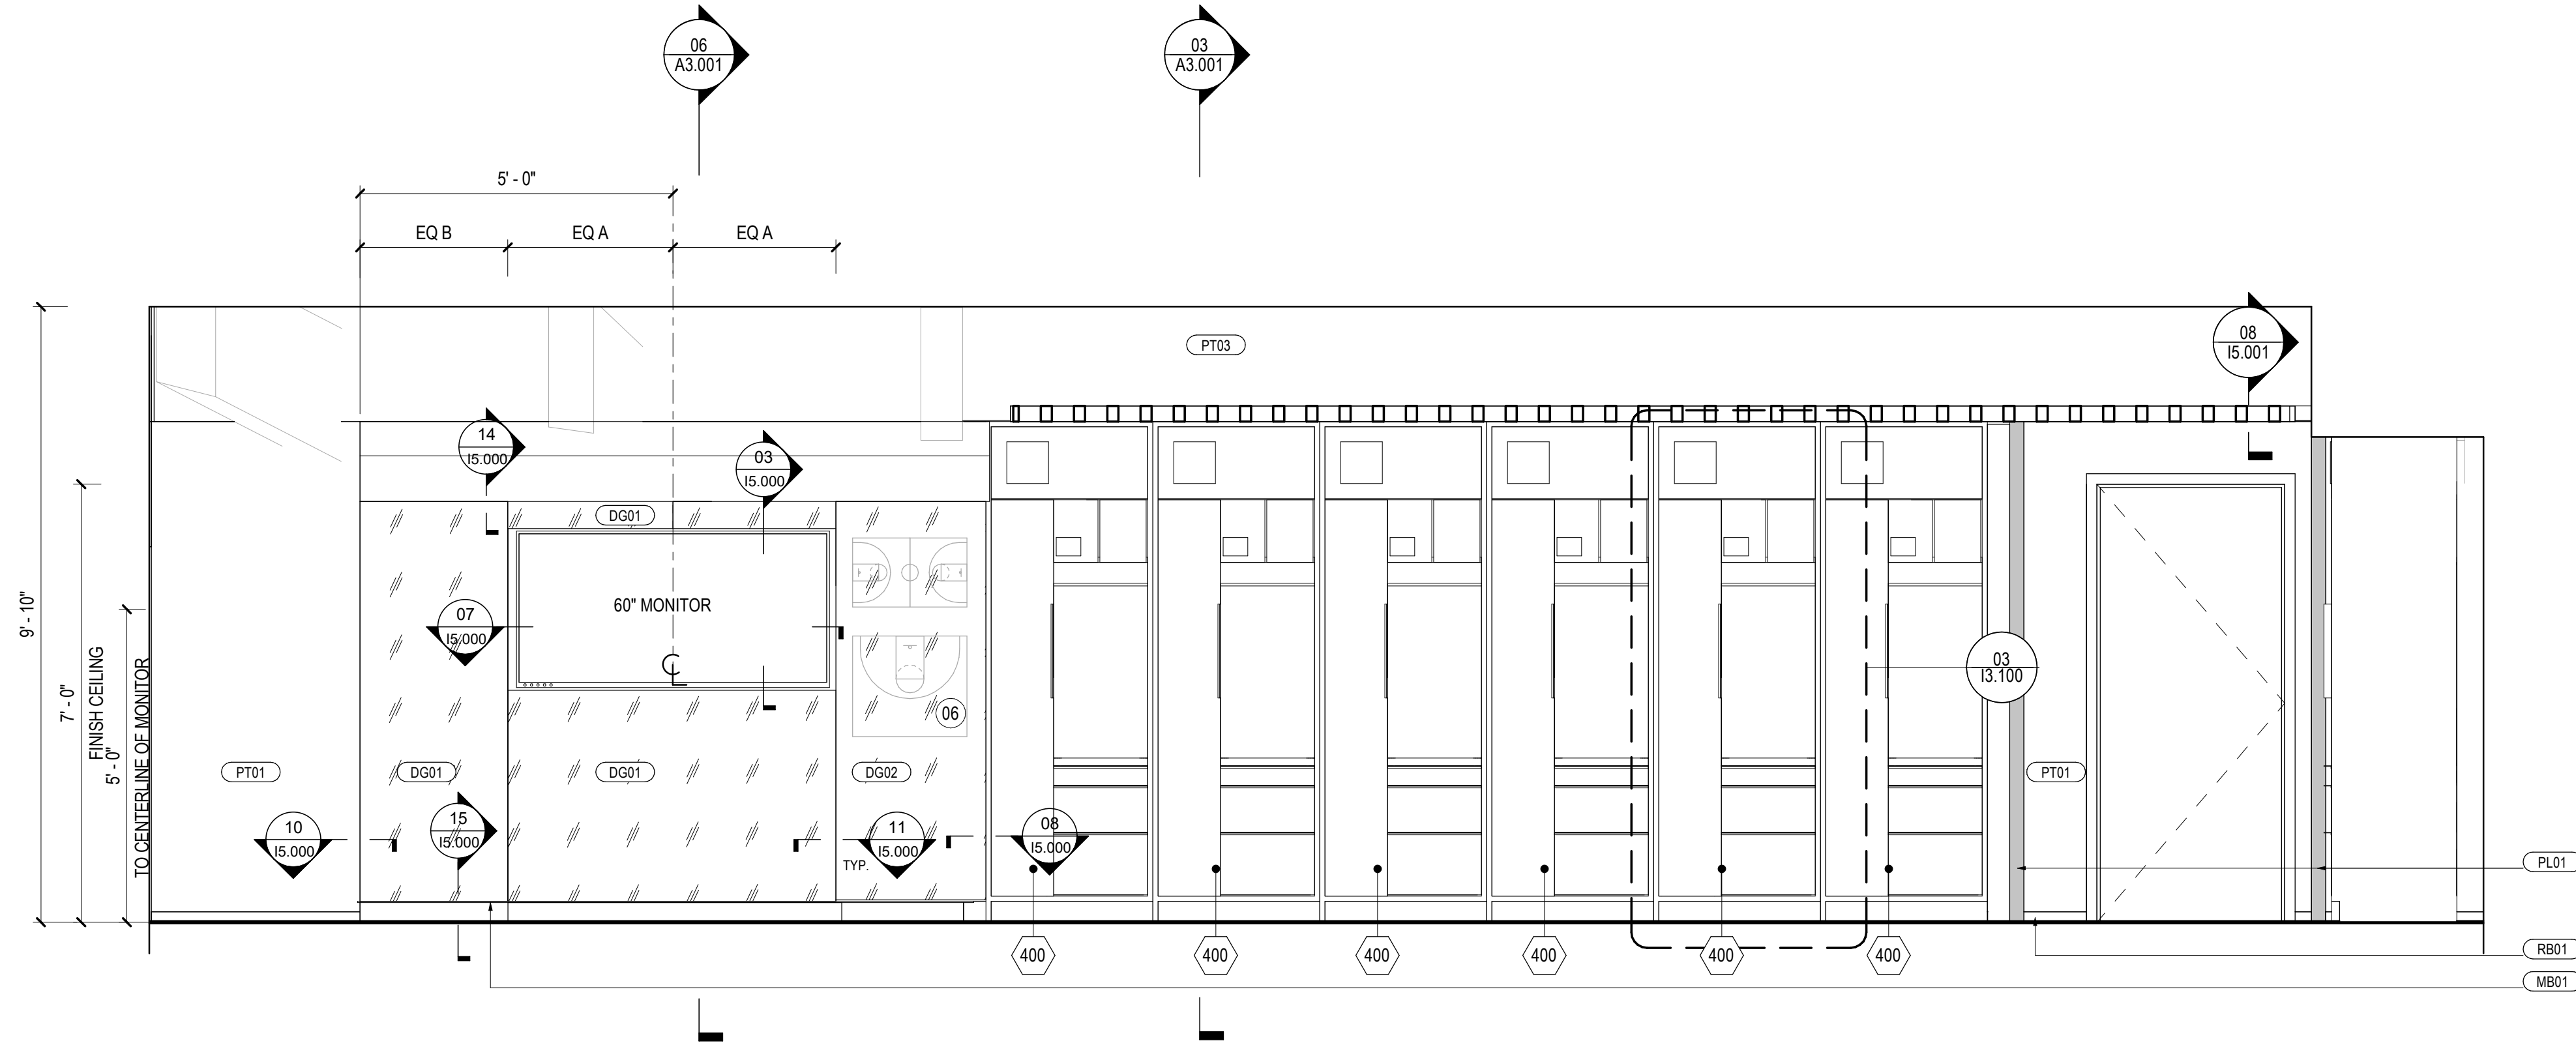

**02 ELEVATION @ MEN'S LOCKER ROOM EAST**  
SCALE: 1/2" = 1'-0"

**SHEET NOTES**

- ENLARGED PLAN**
- 02 EXISTING FIXTURES, ACCESSORIES, & LIGHTING & TO REMAIN. ENSURE PROTECTION DURING CONSTRUCTION. REPLACE WALL, FLOOR FINISHES, & TOILETS ONLY.
  - 03 EXISTING PARTITIONS, FIXTURES, ACCESSORIES, & LIGHTING & TO REMAIN. ENSURE PROTECTION DURING CONSTRUCTION. REPLACE WALL & FLOOR FINISHES.
  - 04 - OPTION 1 MEN'S LOCKER CUSTOM CARPET (BROADLOOM INLAY CARPET)
  - 05 - OPTION 2 MEN'S LOCKER CUSTOM CARPET (WATERJET LETTERING IN CARPET TILE)
- REFLECTED CEILING PLAN**
- 01 CONCEALED LED COVE FIXTURE WITH DIMMING CONTROLS.
  - 02 REFER TO ENLARGED PLANS AND ELEVATIONS FOR SPEAKER LOCATIONS AND MOUNTING HEIGHT.
  - 03 REFER TO FIRE PROTECTION DRAWINGS FOR LOCATION OF SPRINKLER HEADS.
  - 04 REFER TO ELECTRICAL DRAWINGS FOR LOCATION OF CEILING MOUNTED FIRE ALARM DEVICES.

**GENERAL NOTES**

- A. AREAS TONED IN GRAY ARE NOT IN CONTRACT.
- B. REFER TO SHEET G1.01 FOR GRAPHIC SYMBOLS AND ABBREVIATIONS.
- C. REFER TO SHEET G1.10 FOR TYPICAL MOUNTING HEIGHTS, AND LOCATION DIAGRAMS.
- D. ON TYPICAL FLOORS PATCH AND EXTEND RESILIENT BASE AS NECESSARY WITH NEW TO MATCH EXISTING.
- E. REFER TO SHEET IS.300, FOR TRANSITION AND BASE DETAILS.
- F. UNLESS NOTED OTHERWISE FINISHES TO BE:
  - a. WALL: PT01
  - b. WALL BASE: RB01
  - c. FLOOR: C01
  - d. GYP. BD: PT04
  - e. EXPOSED OPEN CEILING: PT03
- G. SEALANT AND CAULKING COLORS TO MATCH ADJACENT SURFACE.
- H. ALL ITEMS VISIBLE IN SPACE TO BE FINISHED. MISCELLANEOUS UNFINISHED ITEMS AND DEVICES TO BE REVIEWED WITH ARCHITECT AND OWNER FOR FINAL FINISH.
- I. UNLESS NOTED OTHERWISE ALIGN FLOORING TRANSITION WITH CENTERLINE OF DOOR. IF NO DOOR, ALIGN WITH FINISHED BASE.
- J. ALL COLOR FINISHES FOR TRANSITION STRIPS TO BE SELECTED BY ARCHITECT PRIOR TO MANUFACTURE AND INSTALLATION.
- K. UNLESS NOTED OTHERWISE CONTINUE SCHEDULED FLOORING UNDER MILLWORK.
- L. COVER PLATES TO BE STAINLESS STEEL. UNLESS NOTED OTHERWISE, REPLACE ANY EXISTING OUTLETS AND COVER PLATES THAT DO NOT MATCH NEW.
- M. FURNITURE PLANS ARE SHOWN FOR INFORMATION ONLY.
- N. GENERAL CONTRACTOR, FURNITURE VENDOR, ARCHITECT, AND OWNER TO REVIEW SCOPE RESPONSIBILITY PRIOR TO PROCUREMENT.
- O. REFER TO ENGINEERING AND CONSULTANT DRAWINGS FOR ADDITIONAL POWER AND COMMUNICATION REQUIREMENTS.
- P. INDICATED DIMENSIONS ARE TO THE CENTER LINE OF OUTLET OR SWITCH, OR GLUSTER OF OUTLETS OR SWITCHES, UNLESS OTHERWISE NOTED.
- Q. INSTALL OUTLETS ON OPPOSITE SIDES OF PARTITIONS IN SEPARATE STUD CAVITIES. DO NOT INSTALL BACK-TO-BACK.
- R. COVER PLATES TO BE STAINLESS STEEL. UNLESS NOTED OTHERWISE, REPLACE ANY EXISTING OUTLETS AND COVERPLATES THAT DO NOT MATCH NEW.
- S. ALL THROUGH PENETRATIONS TO MAINTAIN FIRE RESISTANCE RATING OR HORIZONTAL ASSEMBLY IN ACCORDANCE WITH CODE. PROVIDE UL NUMBER OF DEVICES WHERE APPROPRIATE.
- T. COORDINATE LOCATION OF ALL POWER AND COMMUNICATION DEVICES AND STUD UPS IN FIELD WITH FINAL FURNITURE PACKAGE AND FURNITURE VENDOR. THIS INCLUDES THE LOCATION COORDINATION OF THE FURNITURE IN-FEED WITH TABLE TOP BOX TERMINATION WITH FURNITURE AND AV VENDOR. ALL GROMMET LOCATIONS AT FURNITURE AND/OR MILLWORK WITH FURNITURE/MILLWORK VENDORS.
- U. ALL PENETRATION IN STRUCTURAL SLAB TO BE GPR OR X-RAY SCANNED AND APPROVED BY OWNER TO INSURE STRUCTURAL INTEGRITY OF SLAB.
- V. REFER TO ENLARGED PLANS AND ELEVATIONS FOR FURTHER OUTLET DIMENSIONS.



92 Catamount Road  
Cullowhee, NC 28723

**Gensler**

2020 K St NW  
Washington, DC 20006  
United States

Tel (202) 721-5200  
Fax +1 202.872.8587



MEP ENGINEERS  
1927 South Tryon Street  
Suite 300  
Charlotte, NC 28203  
Tel 704.338.1292

SCO ID: 21-22998-01  
CIP: 42029

Date	Description
1 03/26/2021	DESIGN DEVELOPMENT - ISSUE FOR PRICING
2 04/19/2021	ISSUE FOR PERMIT
3 06/11/2021	ISSUE FOR PERMIT - RESUBMIT
4 10/18/2021	ISSUE FOR BID
6 11/30/2021	ADDENDUM 02

Seal / Signature

Project Name  
**RAMSEY - BASKETBALL LOCKER ROOM RENOVATION**

Project Number  
**009.9478.000**

Description  
ENLARGED PLAN, RCP & INTERIOR ELEVATIONS OF MEN'S LOCKER

Scale  
As indicated

**11.104**





92 Catamount Road  
Cullowhee, NC 28723

**Gensler**

2020 K St NW Washington, DC 20006 United States  
Tel (202) 721-5200 Fax +1 202 872 8587



MEP ENGINEERS  
1927 South Tryon Street  
Suite 300  
Charlotte, NC 28203  
Tel 704.338.1292

SCO ID: 21-22998-01  
CIP: 42029

**SHEET NOTES**

**ENLARGED PLAN**

- 01 EXISTING PARTITIONS & FLOORING TO REMAIN; FLOOR TO RECEIVE NEW CONCRETE SEAL. ENSURE PROTECTION DURING CONSTRUCTION. REMOVE ALL BUILT IN FURNITURE FROM ROOM.
- 02 CONCRETE SEAL TO RECEIVE NEW TILE.
- 03 OPTION 1 WOMEN'S LOCKER CUSTOM CARPET (WATERJET LETTERING IN CARPET TILE)
- 04 OPTION 2 WOMEN'S LOCKER CUSTOM CARPET (BROADLOOM INLAY CARPET)
- Interior Elevations
- 05 POTENTIAL FUTURE GRAPHIC WALL. CONTRACTOR TO PREPARE WALL WITH LEVEL 05 FINISH.
- 06 DG02 APPLIED FULL COURT GRAPHIC.

**REFLECTED CEILING PLAN**

- 01 CONCEALED LED COVE FIXTURE WITH DIMMING CONTROLS.
- 02 REFER TO ENLARGED PLANS AND ELEVATIONS FOR SPEAKER LOCATIONS AND MOUNTING HEIGHT.
- 04 REFER TO FIRE PROTECTION DRAWINGS FOR LOCATION OF SPRINKLER HEADS.
- 05 REFER TO ELECTRICAL DRAWINGS FOR LOCATION OF CEILING MOUNTED FIRE ALARM DEVICES.

**GENERAL NOTES**

- A. AREAS TONED IN GRAY ARE NOT IN CONTRACT.
- B. REFER TO SHEET G1.01 FOR GRAPHIC SYMBOLS AND ABBREVIATIONS.
- C. REFER TO SHEET G1.10 FOR TYPICAL MOUNTING HEIGHTS, AND LOCATION DIAGRAMS.
- D. ON TYPICAL FLOORS PATCH AND EXTEND RESILIENT BASE AS NECESSARY WITH NEW TO MATCH EXISTING.
- E. REFER TO SHEET IS.300. FOR TRANSITION AND BASE DETAILS.
- F. UNLESS NOTED OTHERWISE FINISHES TO BE:  
a. WALL: PT01  
b. WALL BASE: RB01  
c. FLOOR: C01  
d. GYP. BD.: PT04  
e. EXPOSED OPEN CEILING: PT03
- G. SEALANT AND CAULKING COLORS TO MATCH ADJACENT SURFACE.
- H. ALL ITEMS VISIBLE IN SPACE TO BE FINISHED. MISCELLANEOUS UNFINISHED ITEMS AND DEVICES TO BE REVIEWED WITH ARCHITECT AND OWNER FOR FINAL FINISH.
- I. UNLESS NOTED OTHERWISE ALIGN FLOORING TRANSITION WITH CENTERLINE OF DOOR. IF NO DOOR, ALIGN WITH FINISHED BASE.
- J. ALL COLOR FINISHES FOR TRANSITION STRIPS TO BE SELECTED BY ARCHITECT PRIOR TO MANUFACTURE AND INSTALLATION.
- K. UNLESS NOTED OTHERWISE CONTINUE SCHEDULED FLOORING UNDER MILLWORK.
- L. COVER PLATES TO BE STAINLESS STEEL. UNLESS NOTED OTHERWISE, REPLACE ANY EXISTING OUTLETS AND COVER PLATES THAT DO NOT MATCH NEW.
- M. FURNITURE PLANS ARE SHOWN FOR INFORMATION ONLY.
- N. GENERAL CONTRACTOR, FURNITURE VENDOR, ARCHITECT, AND OWNER TO REVIEW SCOPE RESPONSIBILITY PRIOR TO PROCUREMENT.
- O. REFER TO ENGINEERING AND CONSULTANT DRAWINGS FOR ADDITIONAL POWER AND COMMUNICATION REQUIREMENTS.
- P. INDICATED DIMENSIONS ARE TO THE CENTER LINE OF OUTLET OR SWITCH, OR CLUSTER OF OUTLETS OR SWITCHES, UNLESS OTHERWISE NOTED.
- Q. INSTALL OUTLETS ON OPPOSITE SIDES OF PARTITIONS IN SEPARATE STUD CAVITIES. DO NOT INSTALL BACK-TO-BACK.
- R. COVER PLATES TO BE STAINLESS STEEL. UNLESS NOTED OTHERWISE, REPLACE ANY EXISTING OUTLETS AND COVER PLATES THAT DO NOT MATCH NEW.
- S. ALL THROUGH PENETRATIONS TO MAINTAIN FIRE RESISTANCE RATING OR HORIZONTAL FIRE ASSEMBLY IN ACCORDANCE WITH CODE. PROVIDE UL NUMBER OF DEVICES WHERE APPROPRIATE.
- T. COORDINATE LOCATION OF ALL POWER AND COMMUNICATION DEVICES AND STUD UPS IN FIELD WITH FINAL FURNITURE PACKAGE AND FURNITURE VENDOR. THIS INCLUDES THE LOCATION COORDINATION OF THE FURNITURE IN-FEED WITH TABLE TOP BOX TERMINATION WITH FURNITURE AND AV VENDOR. ALL GROMMET LOCATIONS AT FURNITURE AND/OR MILLWORK WITH FURNITURE/MILLWORK VENDORS.
- U. ALL PENETRATION IN STRUCTURAL SLAB TO BE GPR OR X-RAY SCANNED AND APPROVED BY OWNER TO INSURE STRUCTURAL INTEGRITY OF SLAB.
- V. REFER TO ENLARGED PLANS AND ELEVATIONS FOR FURTHER OUTLET DIMENSIONS.

Seal / Signature

Project Name  
**RAMSEY - BASKETBALL LOCKER ROOM RENOVATION**


Project Number  
**009.9478.000**

Description  
ENLARGED PLAN, RCP & INTERIOR ELEVATIONS OF WOMEN'S LOCKER AND LOUNGE


Scale  
As indicated

**11.106**


© 2021 Gensler

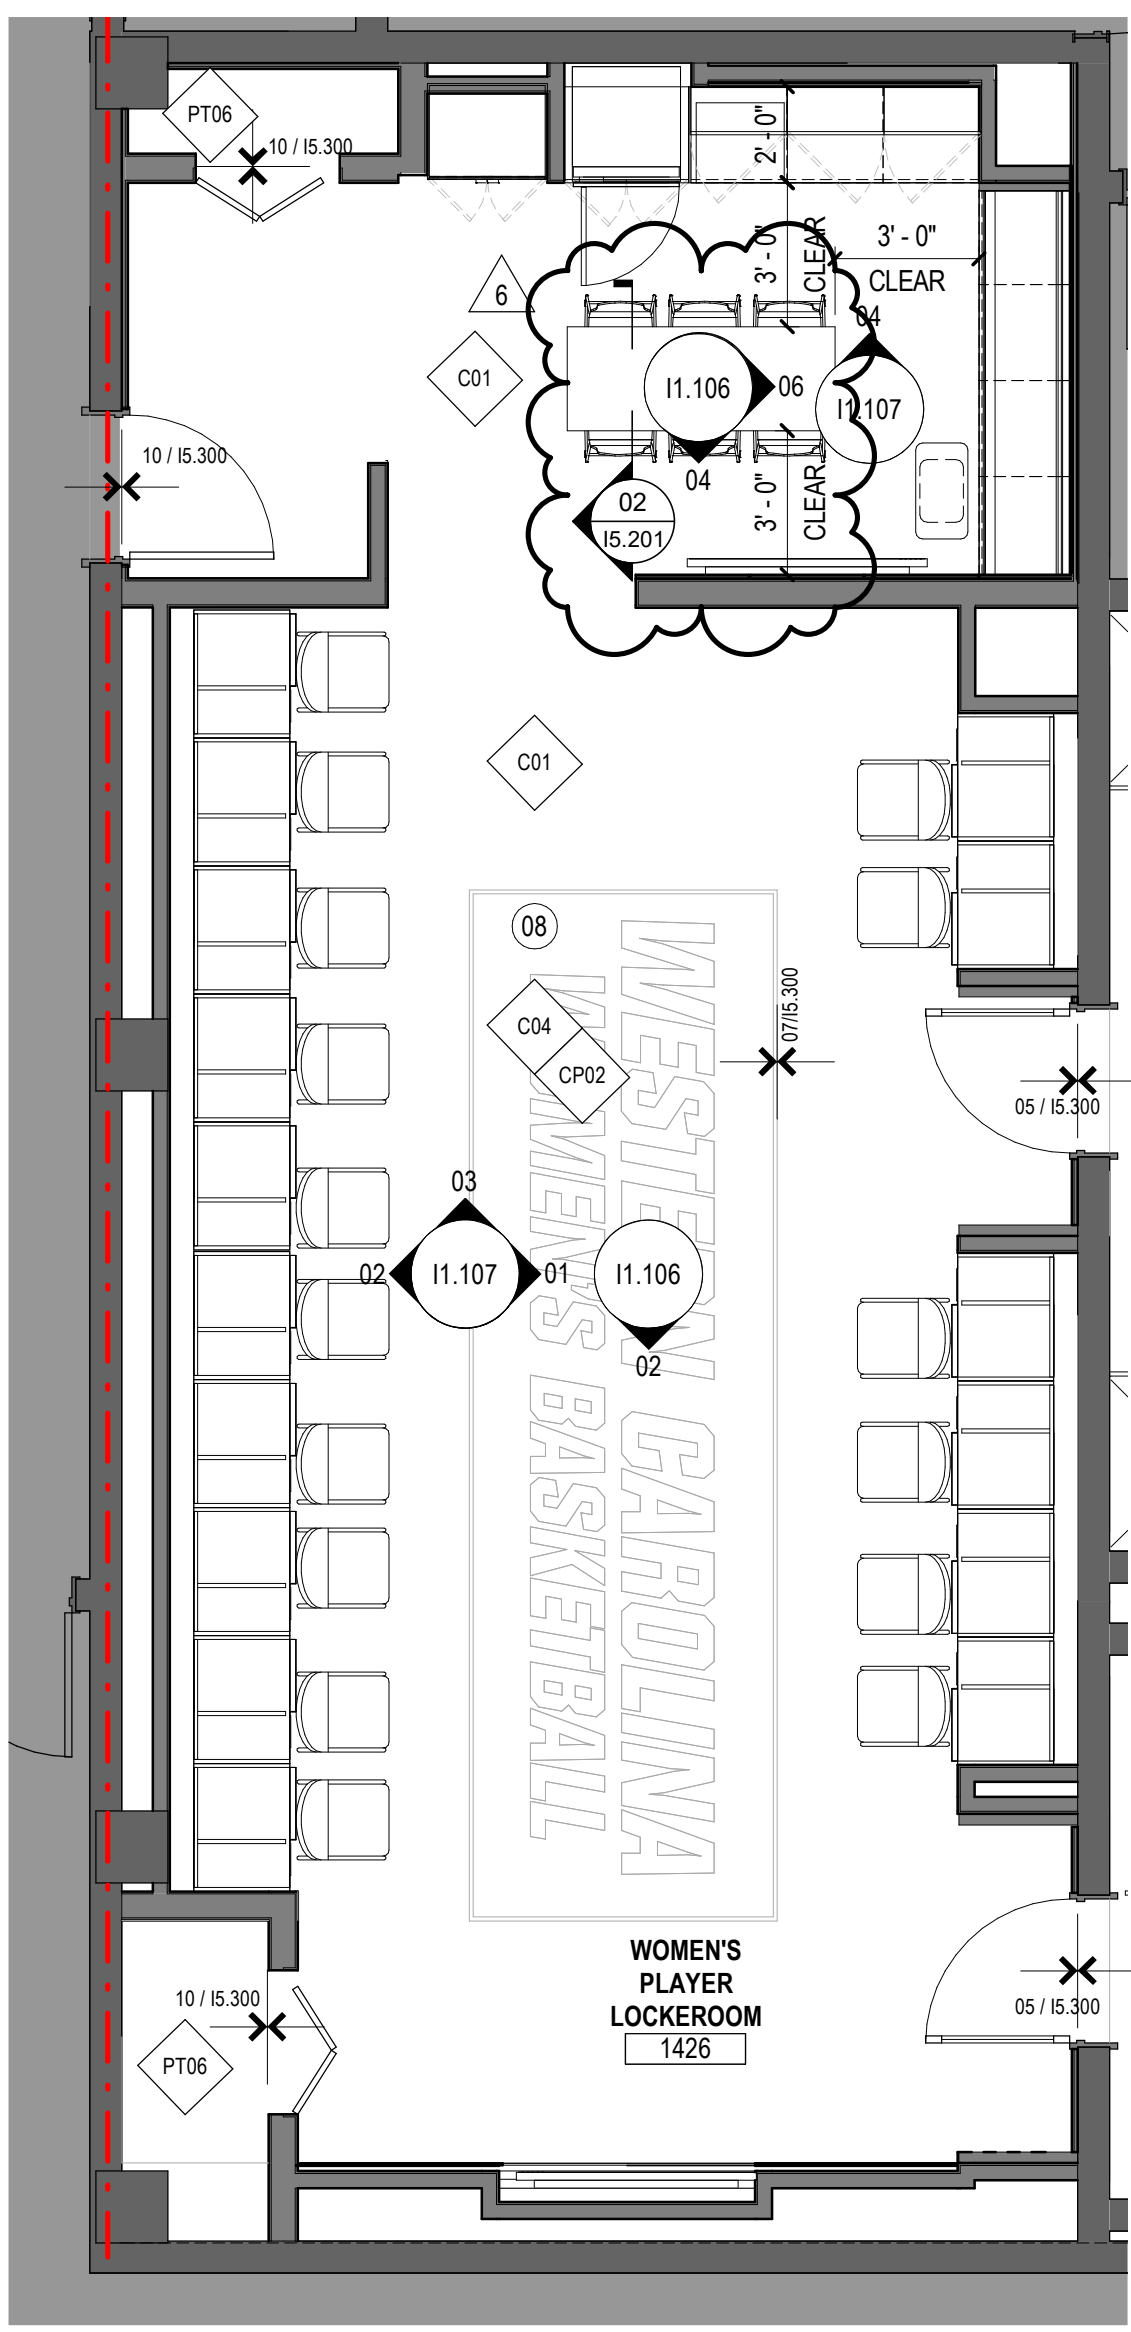


**08 ENLARGED FINISH PLAN @ WOMEN'S LOCKER AND LOUNGE**  
SCALE: 1/4" = 1'-0"

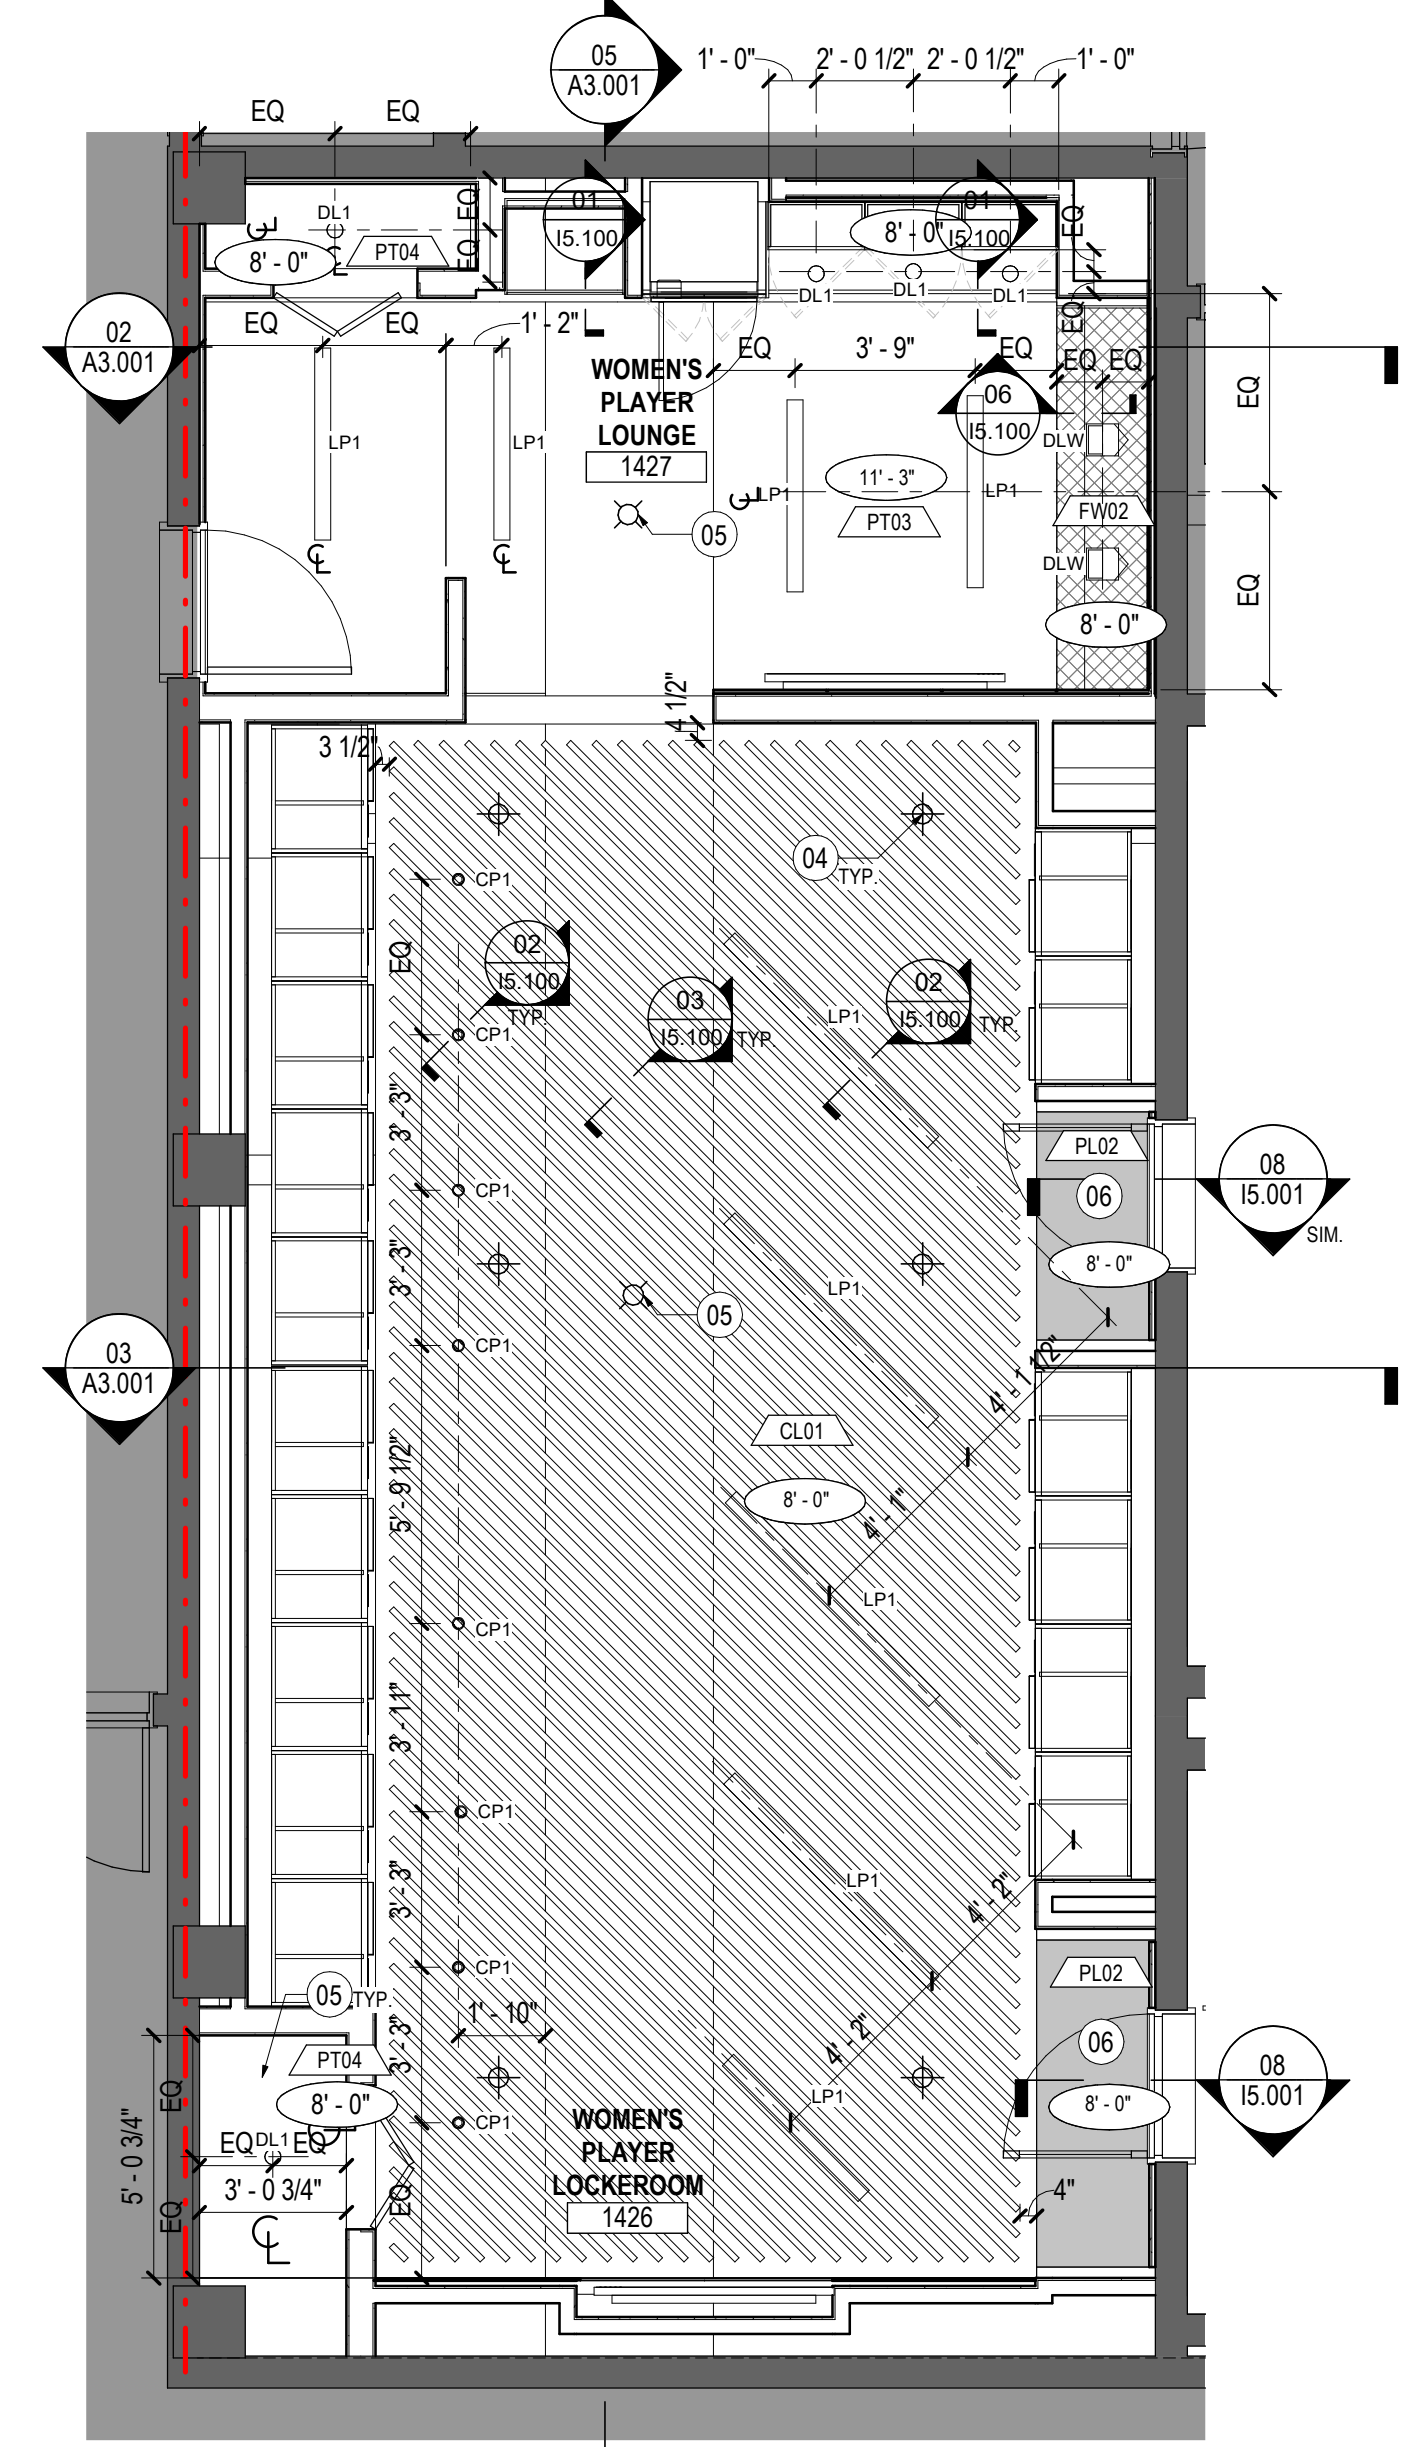


**03 ENLARGED RCP @ WOMEN'S LOCKER AND LOUNGE**  
SCALE: 1/4" = 1'-0"

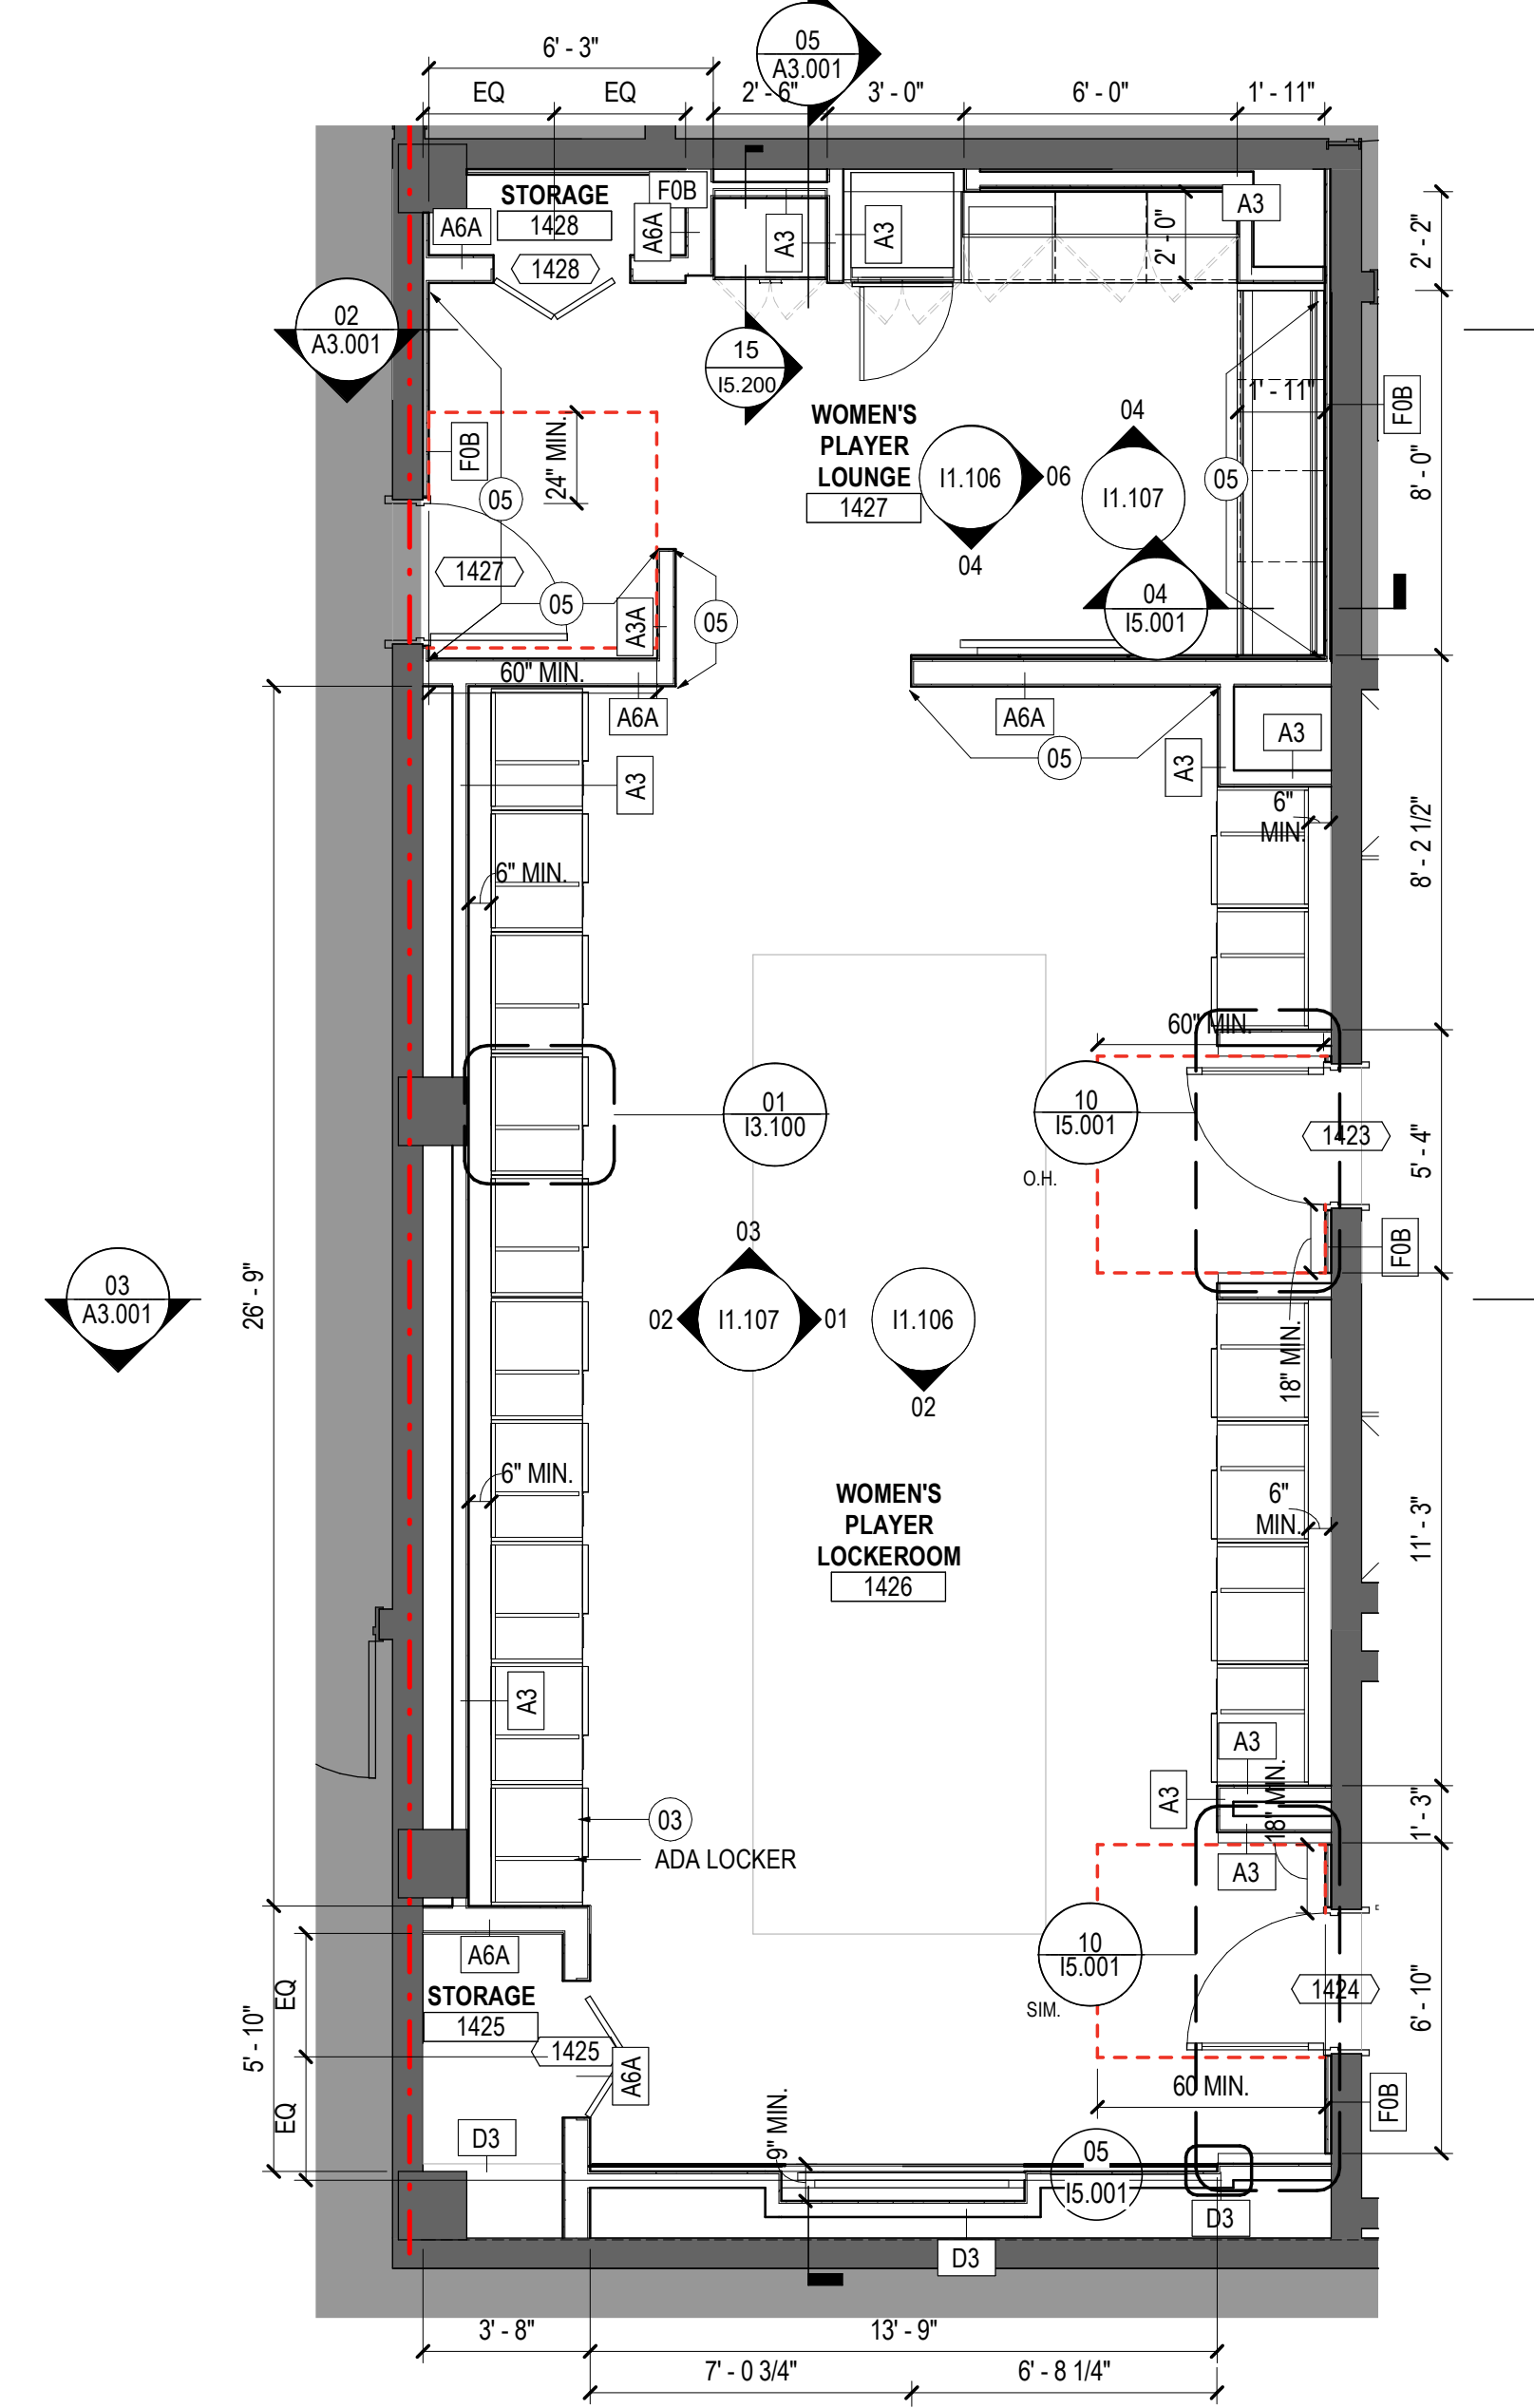


**01 ENLARGED PLAN @ WOMEN'S LOCKER AND LOUNGE**  
SCALE: 1/4" = 1'-0"

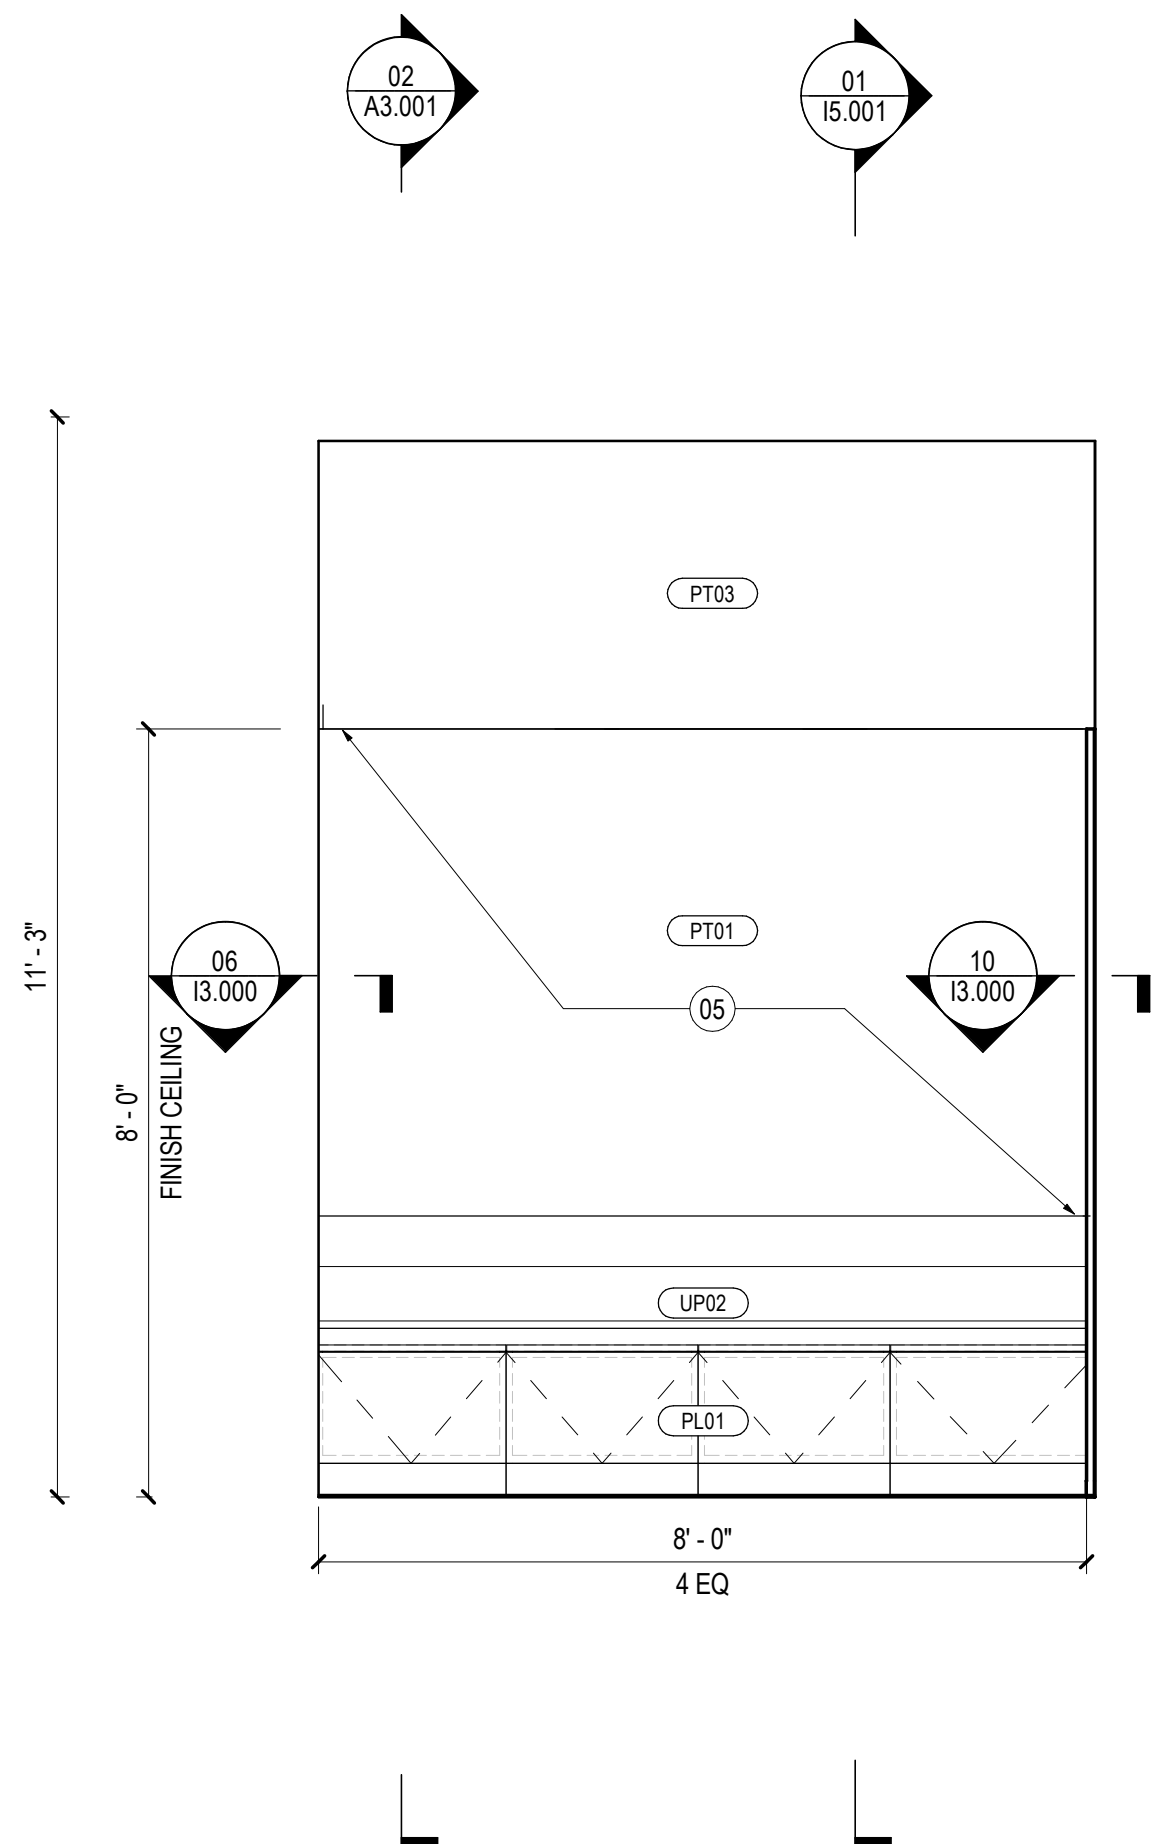

**06 ELEVATION @ WOMEN'S LOUNGE EAST**  
SCALE: 1/2" = 1'-0"

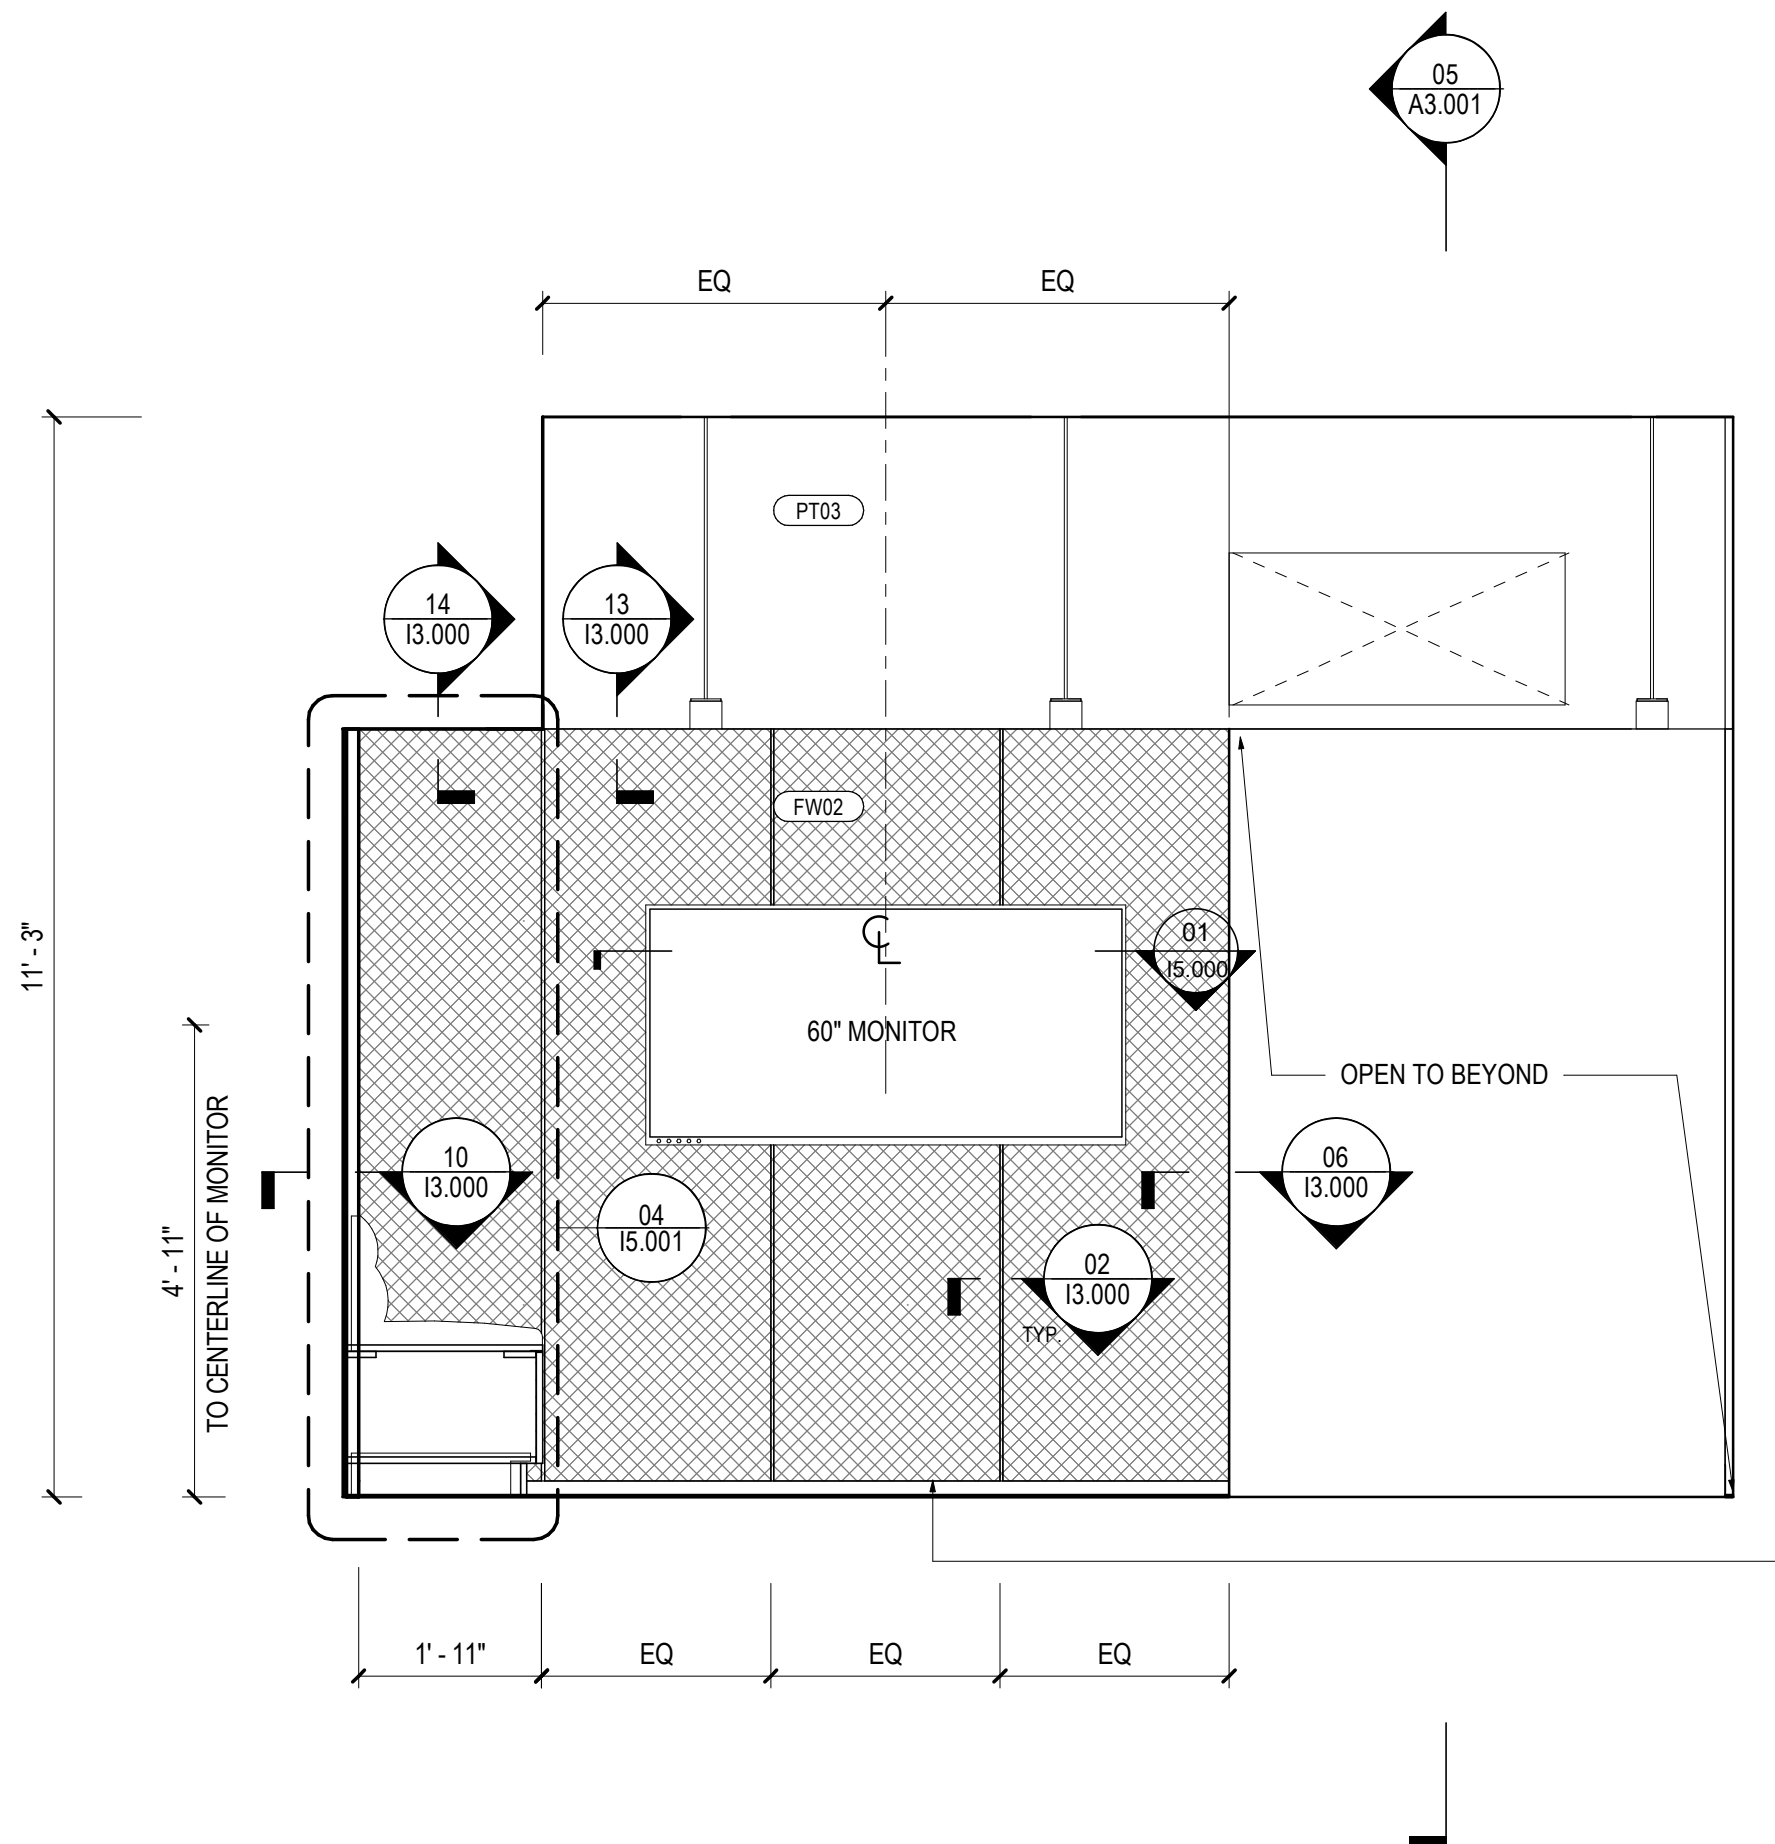

**04 ELEVATION @ WOMEN'S LOUNGE SOUTH**  
SCALE: 1/2" = 1'-0"

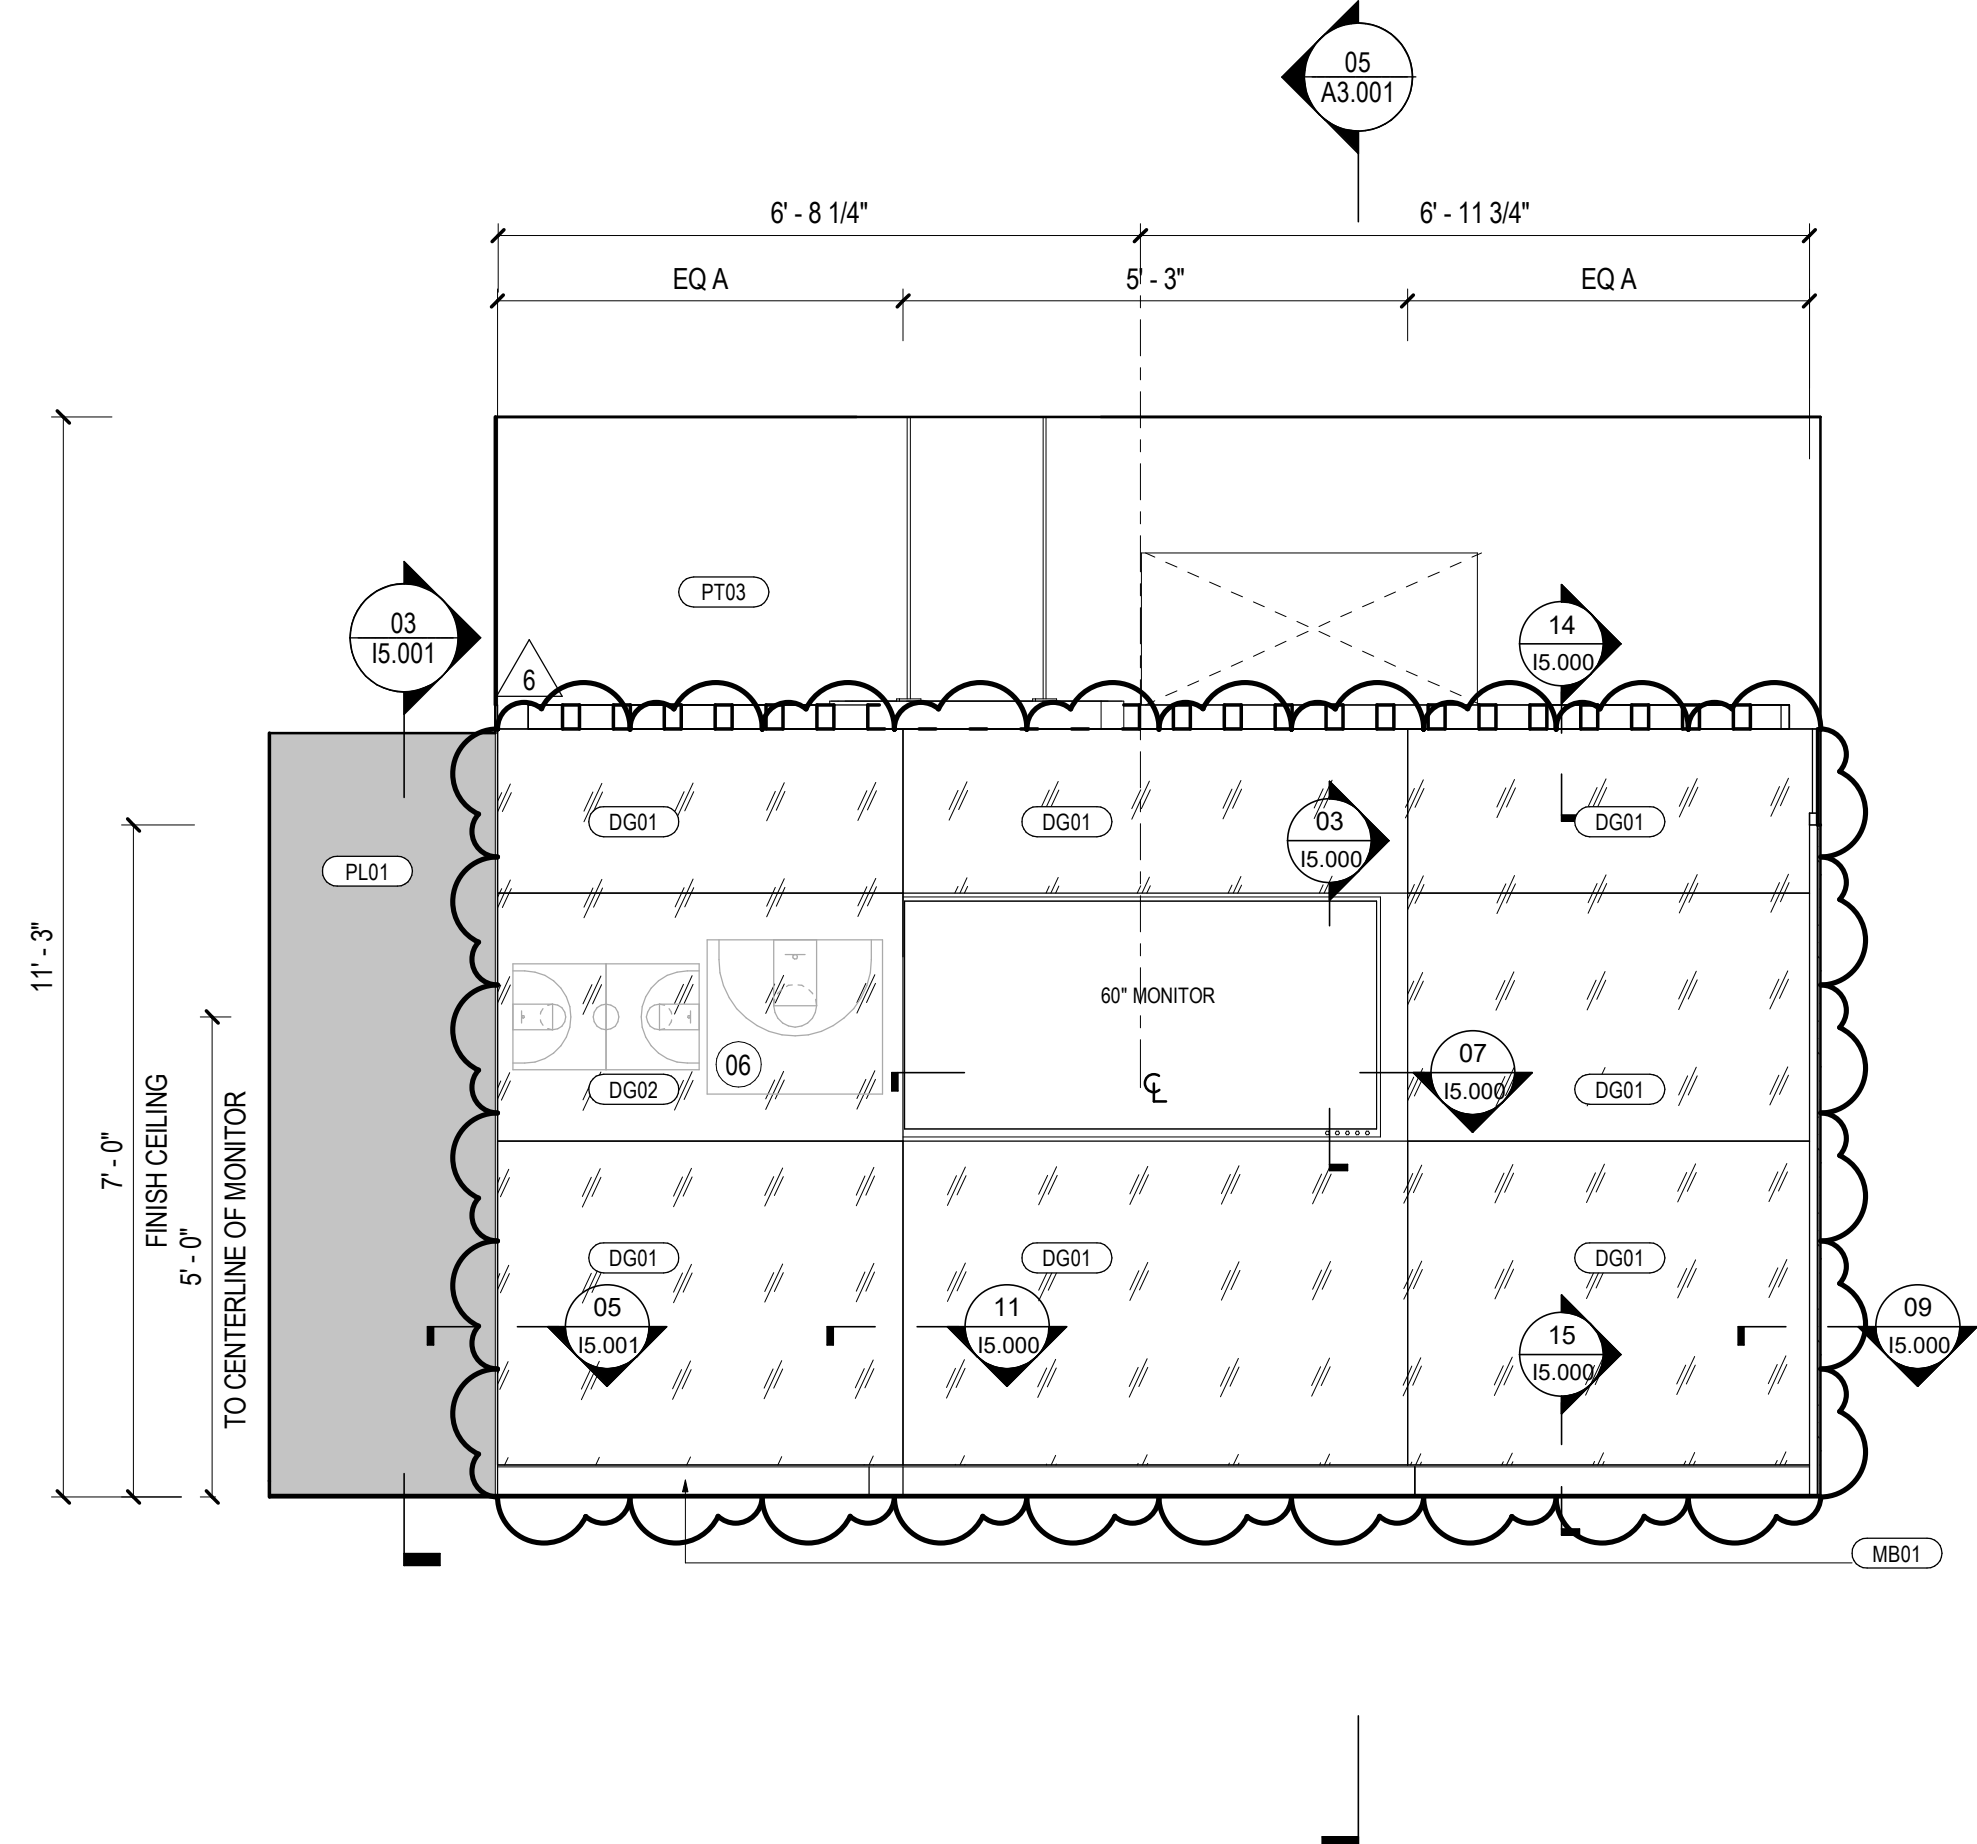

**02 ELEVATION @ WOMEN'S LOCKER ROOM SOUTH**  
SCALE: 1/2" = 1'-0"

11/03/2021 4:54:44 PM BIM 360://009.9478.000 - WCU RMC Basketball SD-CA/liners - 009.9478.000 - WCU Basketball/01.rvt





92 Catamount Road  
Cullowhee, NC 28723

**Gensler**

2020 K St NW Washington, DC 20006 United States  
Tel (202) 721-5200 Fax +1 202 872 8587



MEP ENGINEERS  
1927 South Tryon Street  
Suite 300  
Charlotte, NC 28203  
Tel 704.338.1292

SCO ID: 21-22998-01  
CIP: 42029

**SHEET NOTES**

- 01 EXISTING RESTROOM AND SHOWER CEILING TO REMAIN; CONTRACTOR TO VERIFY NEW DOOR HEIGHT WITH EXISTING CEILING IN FIELD.
- 05 POTENTIAL FUTURE GRAPHIC WALL; CONTRACTOR TO PREPARE WALL WITH LEVEL 05 FINISH.

**GENERAL NOTES**

- A. AREAS TONED IN GRAY ARE NOT IN CONTRACT.
- B. REFER TO SHEET G1.01 FOR GRAPHIC SYMBOLS AND ABBREVIATIONS.
- C. ON TYPICAL FLOORS PATCH AND EXTEND WALL BASE AS NECESSARY WITH NEW TO MATCH EXISTING.
- D. REFER TO SHEET 15.300 FOR TRANSITION AND BASE DETAILS.
- E. UNLESS NOTED OTHERWISE FINISHES TO BE:
  - a. WALL - PT01
  - b. WALL BASE: RB01
  - c. FLOOR: C01
  - d. GYP. BD.: PT04
  - e. EXPOSED OPEN CEILING: PT03
- F. SEALANT AND CAULKING COLORS TO MATCH ADJACENT SURFACE.
- G. ALL ITEMS VISIBLE IN SPACE TO BE FINISHED; MISCELLANEOUS UNFINISHED ITEMS AND DEVICES TO BE REVIEWED WITH ARCHITECT AND OWNER FOR FINAL FINISH.
- H. UNLESS NOTED OTHERWISE ALIGN FLOORING TRANSITION WITH CENTERLINE OF DOOR. IF NO DOOR, ALIGN WITH FINISHED BASE.
- I. ALL COLOR FINISHES FOR TRANSITION STRIPS TO BE SELECTED BY ARCHITECT PRIOR TO INSTALLATION.
- J. UNLESS NOTED OTHERWISE CONTINUE SCHEDULED FLOORING UNDER MILLWORK.
- K. COVER PLATES TO BE STAINLESS STEEL, UNLESS NOTED OTHERWISE. REPLACE ANY EXISTING OUTLETS AND COVER PLATES THAT DO NOT MATCH NEW.

Date	Description
2 04/19/2021	ISSUE FOR PERMIT
3 05/11/2021	ISSUE FOR PERMIT - RESUBMIT
4 10/18/2021	ISSUE FOR BID
6 11/30/2021	ADDENDUM 02

Seal / Signature


Project Name  
**RAMSEY - BASKETBALL LOCKER ROOM RENOVATION**

Project Number  
**009.9478.000**


Description  
INTERIOR ELEVATIONS OF WOMEN'S LOCKER AND LOUNGE

Scale  
1/2" = 1'-0"


**11.107**

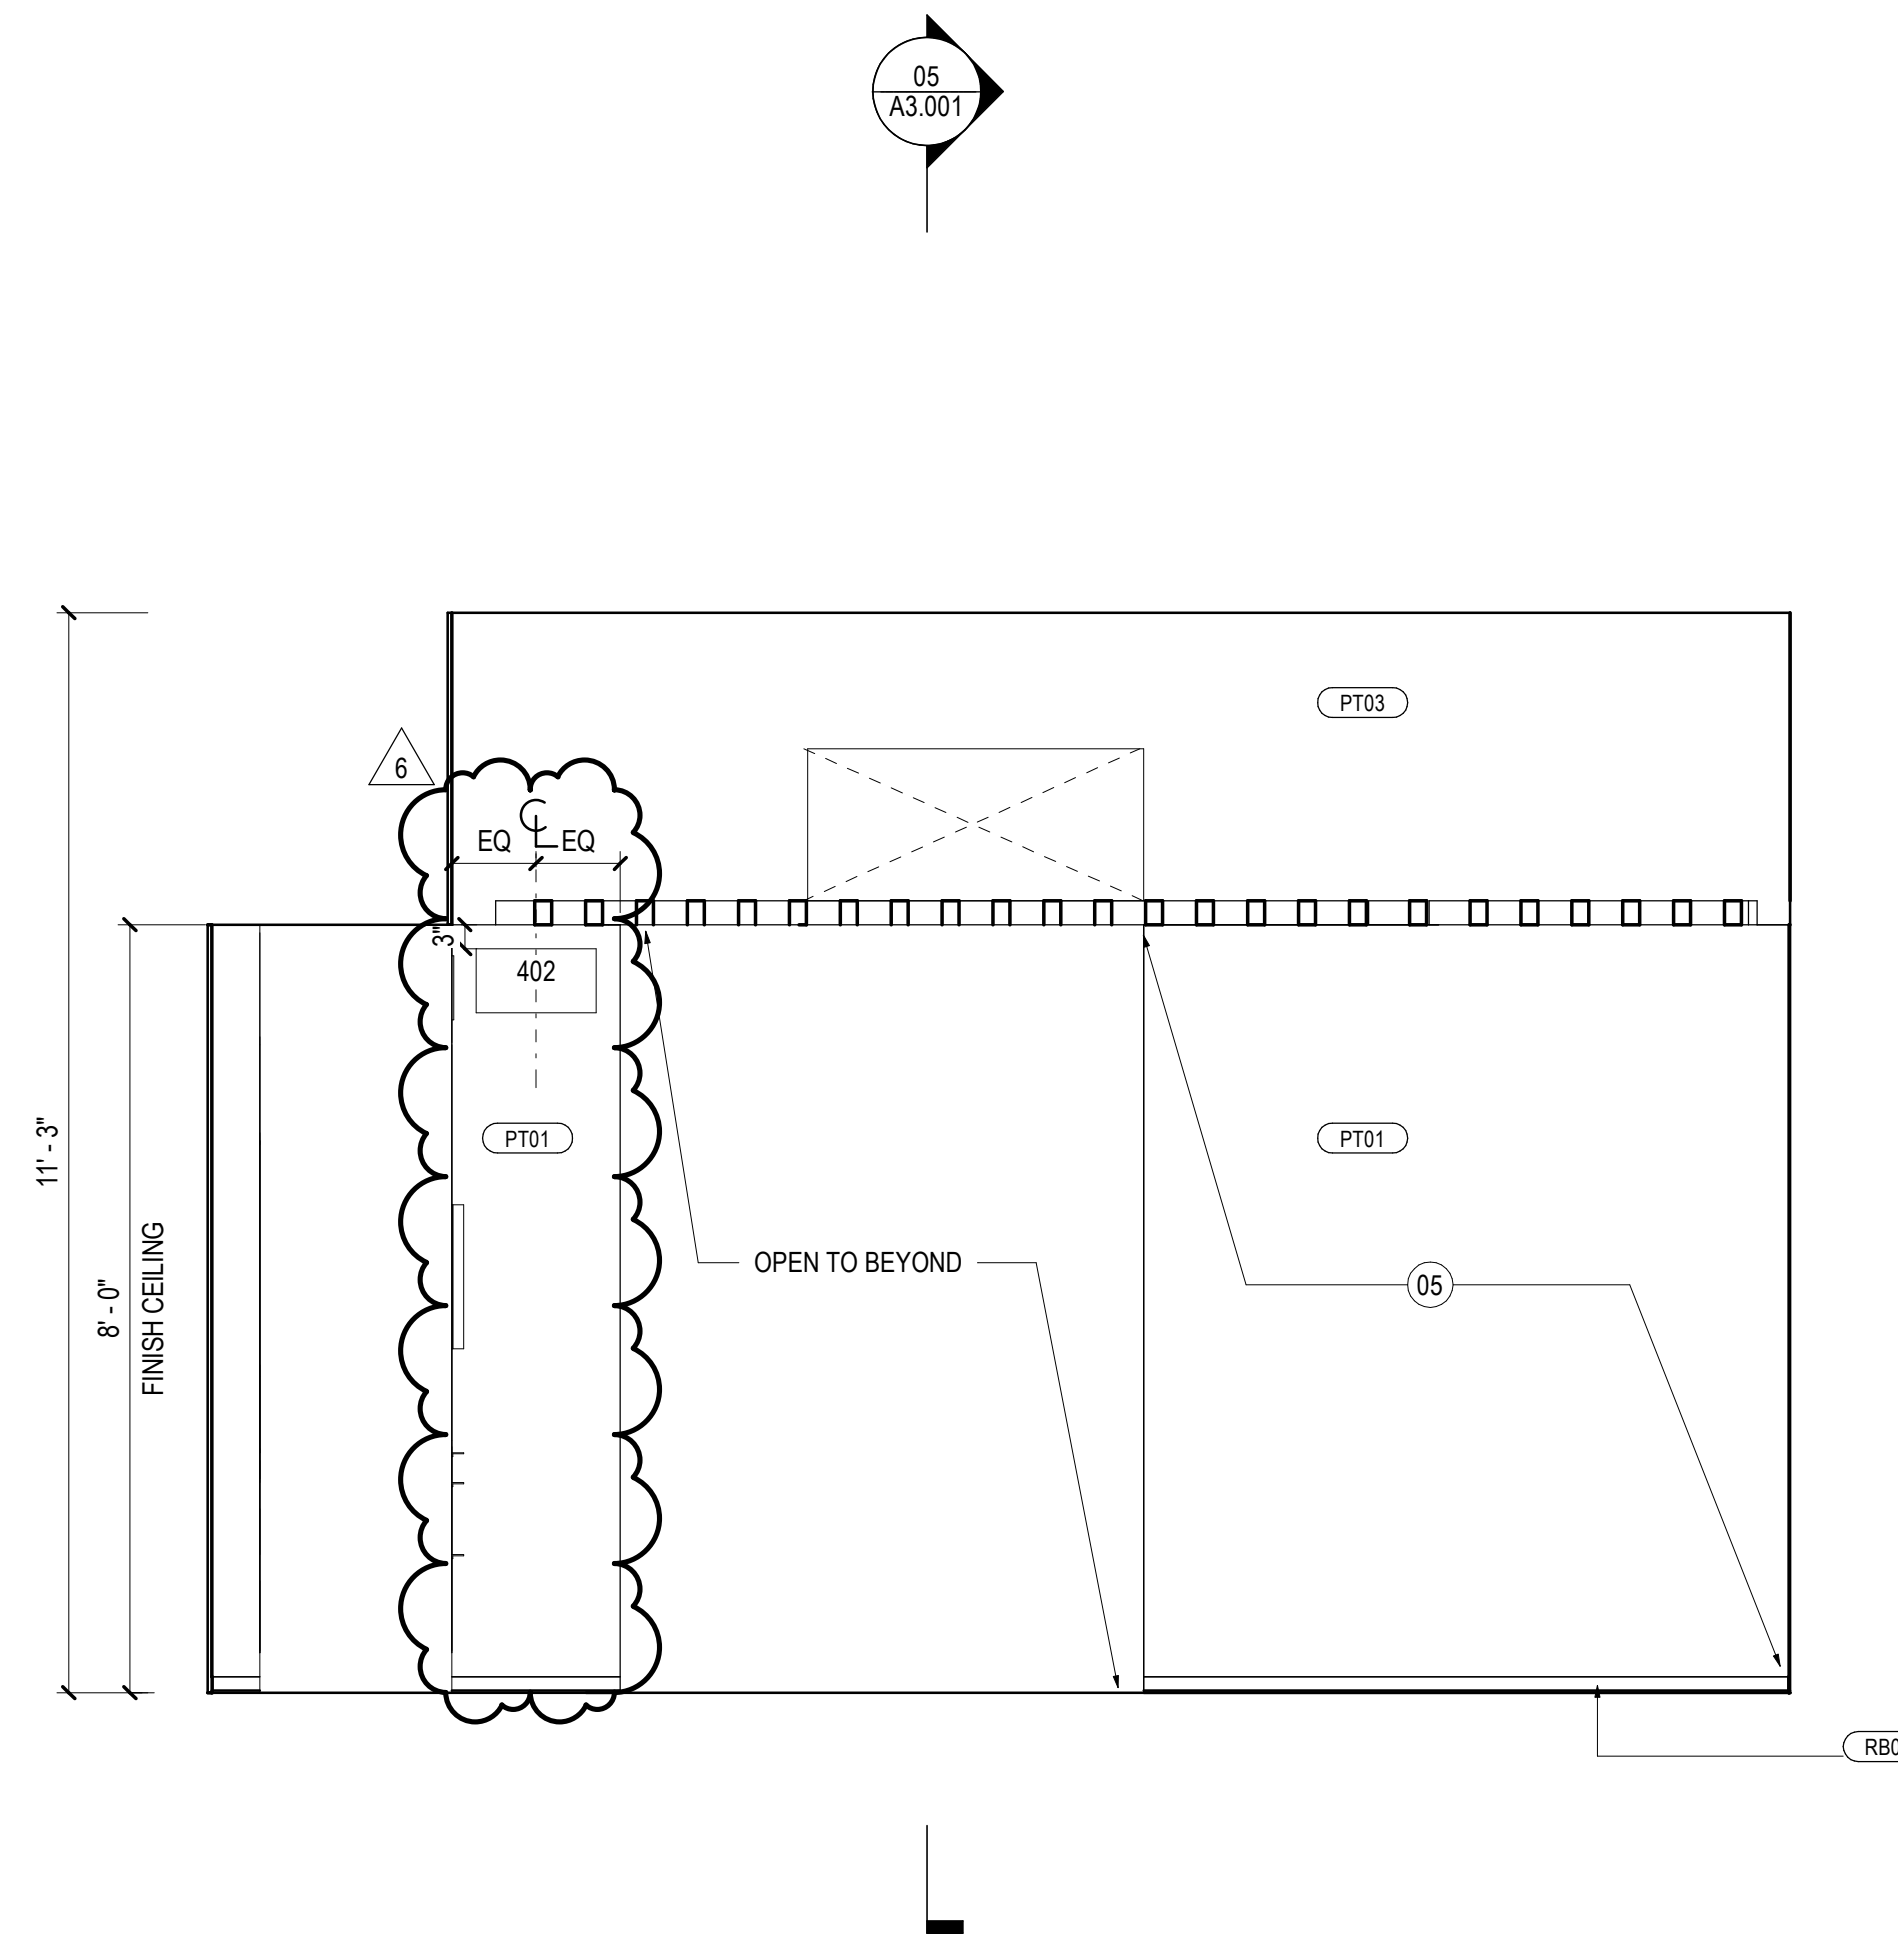


**03 ELEVATION @ WOMEN'S PLAYER LOCKERROOM NORTH**  
SCALE: 1/2" = 1'-0"

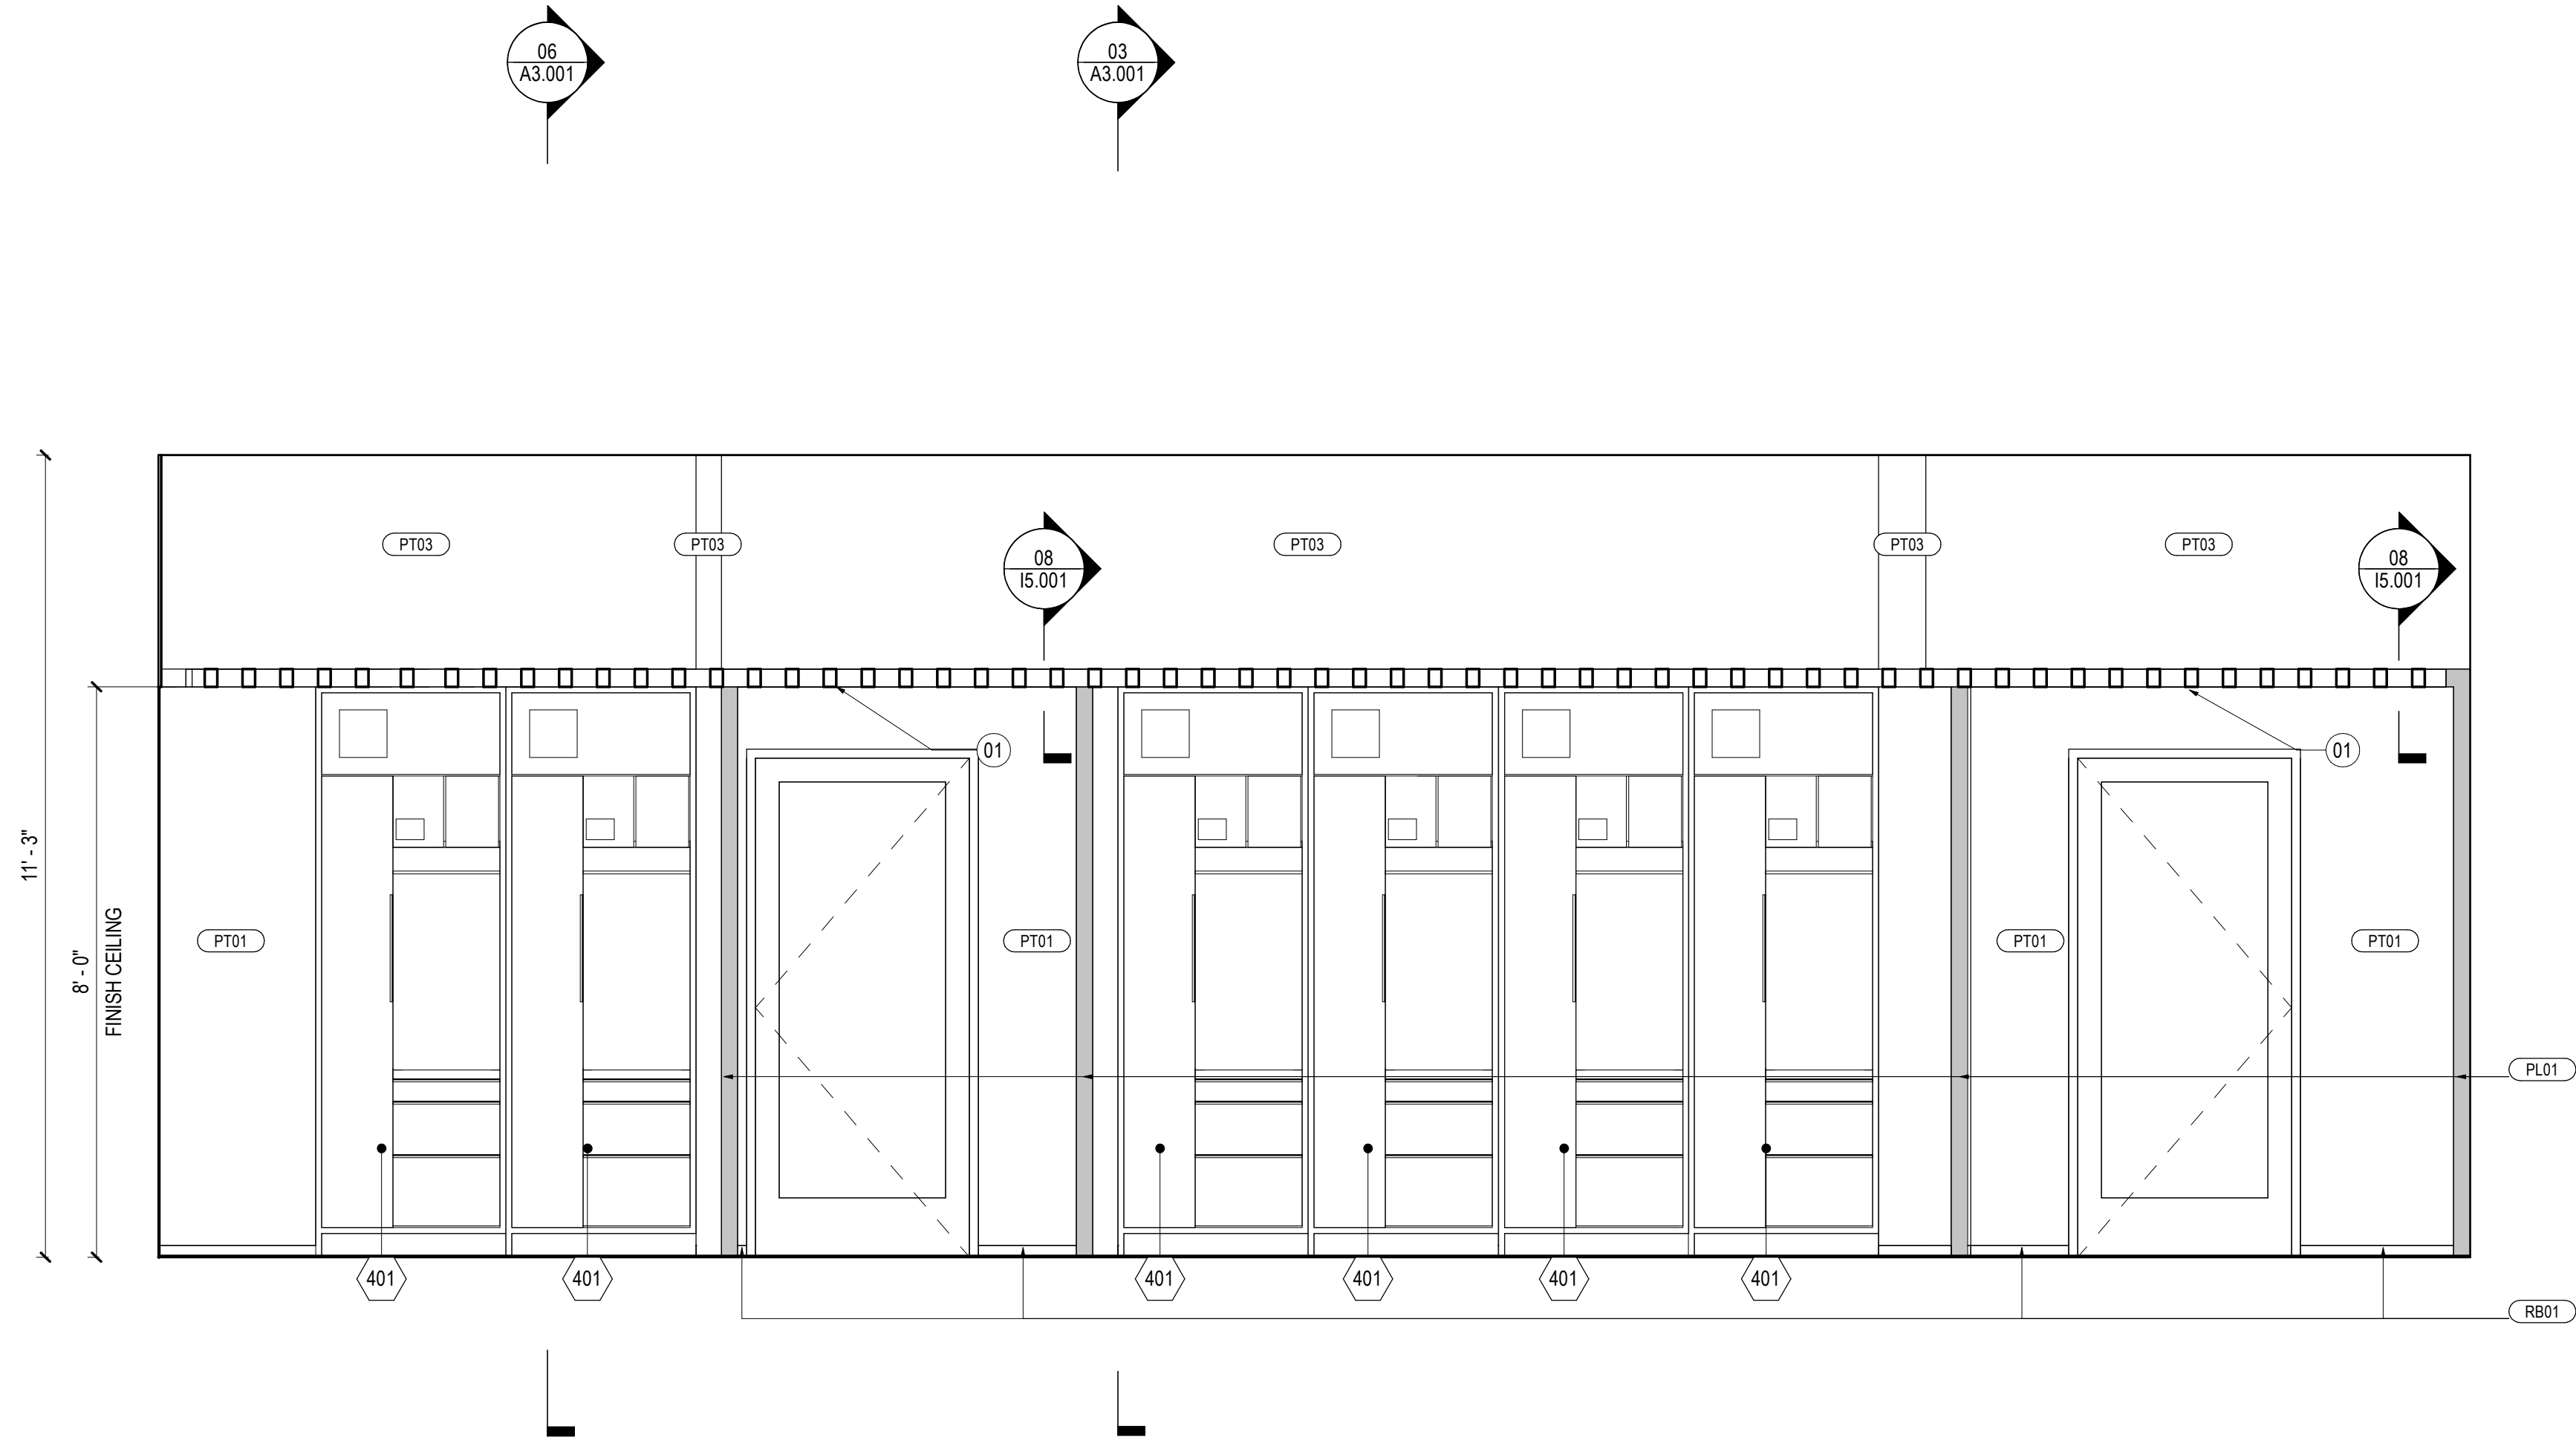

**01 ELEVATION @ WOMEN'S PLAYER LOCKERROOM EAST**  
SCALE: 1/2" = 1'-0"

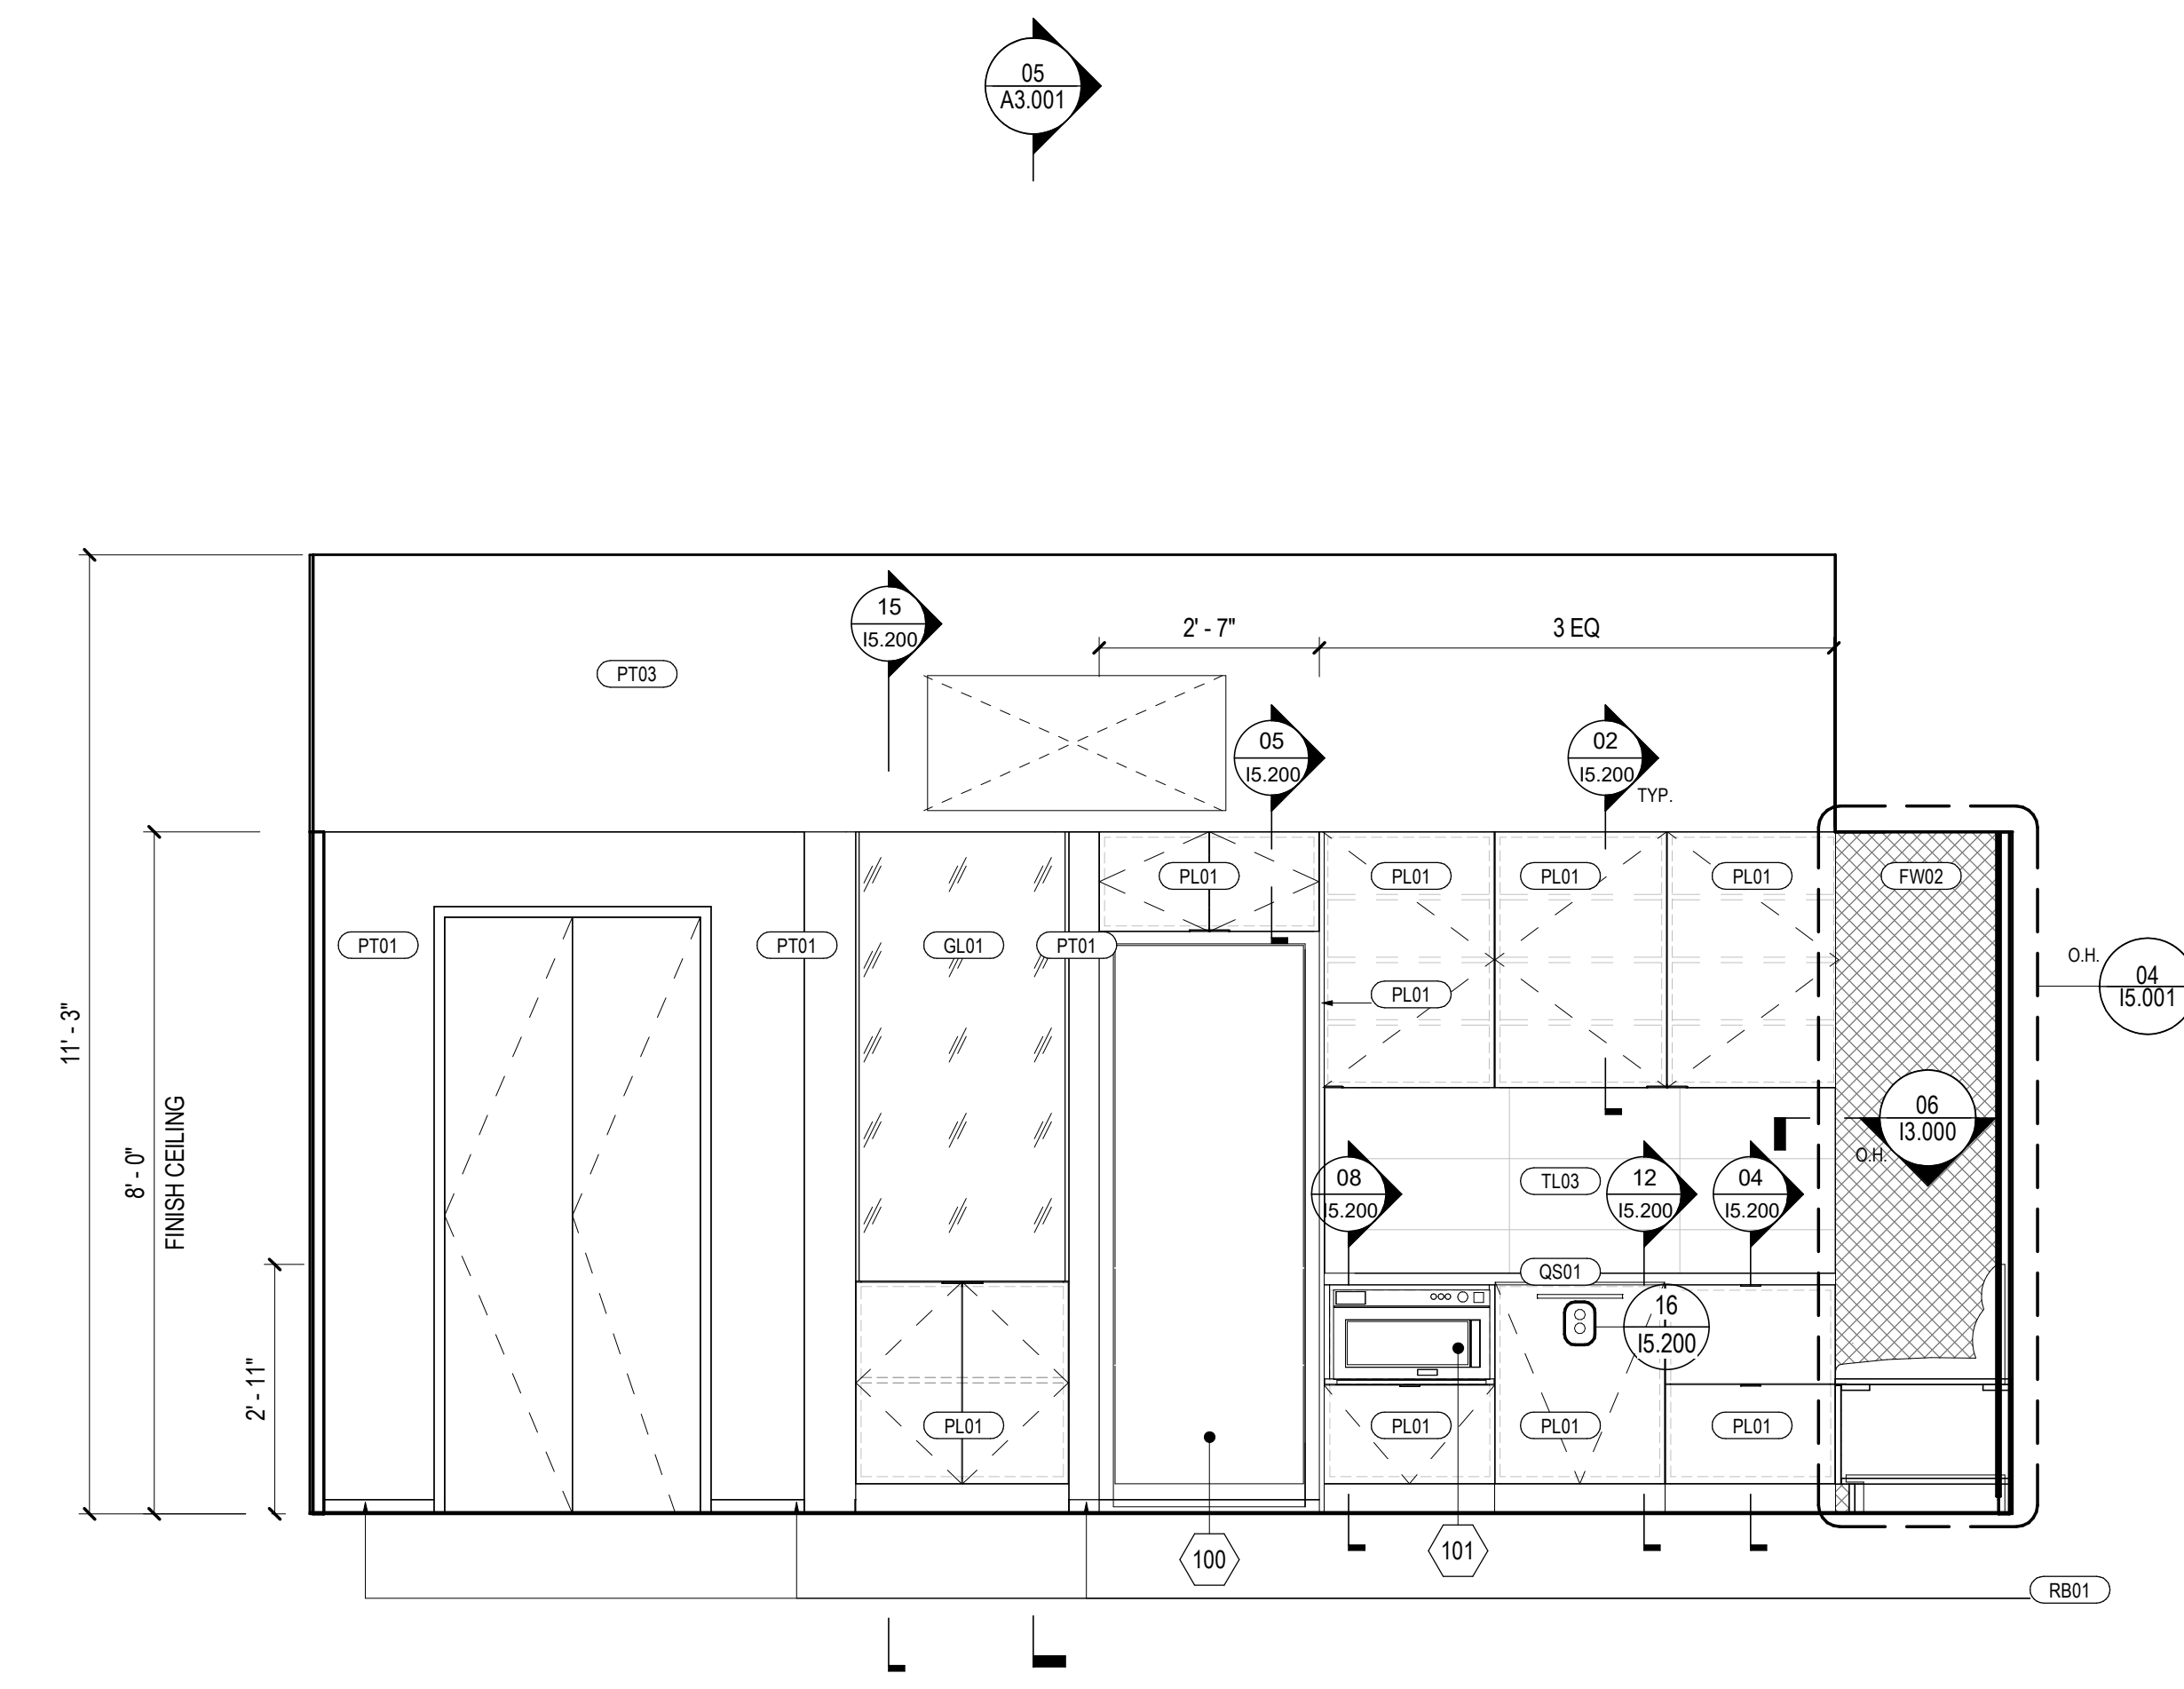

**04 ELEVATION @ WOMEN'S LOUNGE NORTH**  
SCALE: 1/2" = 1'-0"

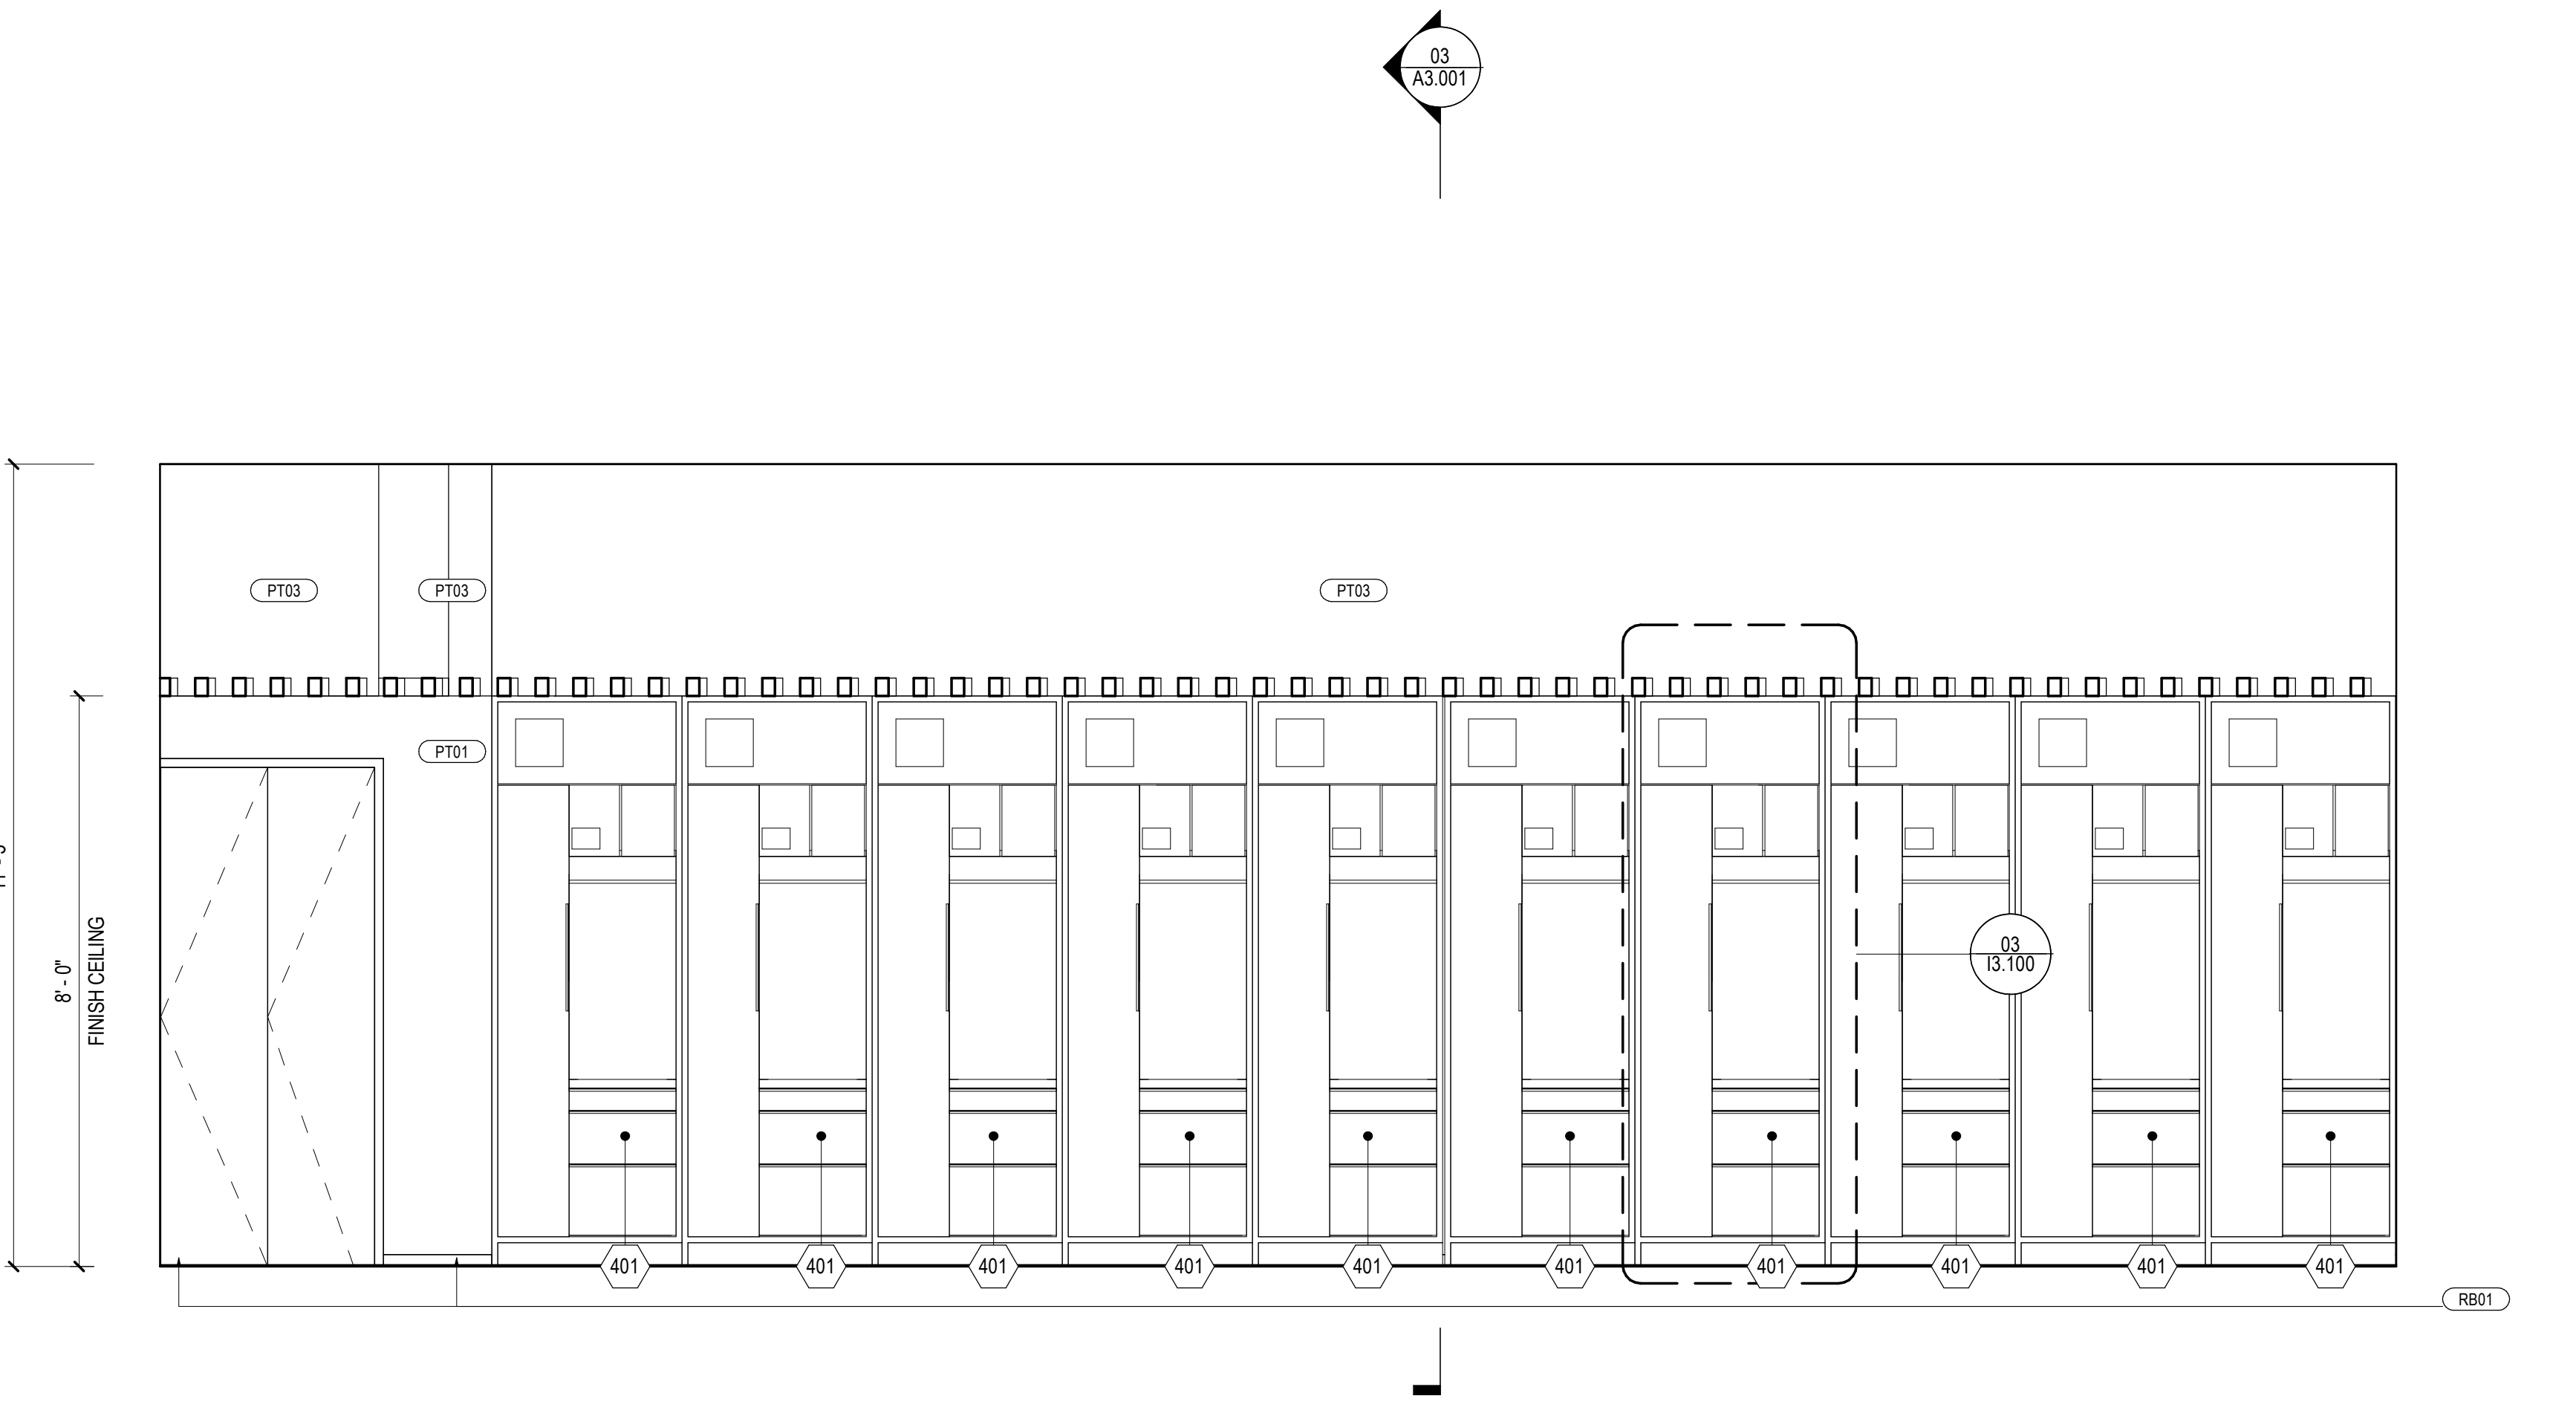

**02 ELEVATION @ WOMEN'S PLAYER LOCKERROOM WEST**  
SCALE: 1/2" = 1'-0"





92 Catamount Road  
Cullowhee, NC 28723

**Gensler**

2020 K St NW  
Washington, DC 20006  
United States  
Tel (202) 721-5200  
Fax +1 202 872 8587



MEP ENGINEERS  
1927 South Tryon Street  
Suite 300  
Charlotte, NC 28203  
Tel 704.338.1292

SCO ID: 21-22998-01  
CIP: 42029

**SHEET NOTES**

**ENLARGED PLAN**

- 01 EXISTING PARTITIONS & FLOORING TO REMAIN. FLOOR TO RECEIVE NEW CONCRETE SEAL. ENSURE PROTECTION DURING CONSTRUCTION. REMOVE ALL BUILT IN FURNITURE FROM ROOM.
- 02 C04 - OPTION 1 WOMEN'S LOCKER CUSTOM CARPET (WATERJET LETTERING IN CARPET TILE)
- 03 CPO2 - OPTION 2 WOMEN'S LOCKER CUSTOM CARPET (BROADLOOM INLAY CARPET)

**REFLECTED CEILING PLAN**

- 01 CONCEALED LED COVE FIXTURE WITH DIMMING CONTROLS.
- 02 REFER TO ENLARGED PLANS AND ELEVATIONS FOR SPEAKER LOCATIONS AND MOUNTING HEIGHT.
- 04 REFER TO FIRE PROTECTION DRAWINGS FOR LOCATION OF SPRINKLER HEADS.
- 05 REFER TO ELECTRICAL DRAWINGS FOR LOCATION OF CEILING MOUNTED FIRE ALARM DEVICES.

**GENERAL NOTES**

- A. AREAS TONED IN GRAY ARE NOT IN CONTRACT.
- B. REFER TO SHEET G1.01 FOR GRAPHIC SYMBOLS AND ABBREVIATIONS.
- C. REFER TO SHEET G1.10 FOR TYPICAL MOUNTING HEIGHTS, AND LOCATION DIAGRAMS.
- D. ON TYPICAL FLOORS PATCH AND EXTEND RESILIENT BASE AS NECESSARY WITH NEW TO MATCH EXISTING.
- E. REFER TO SHEET IS.300. FOR TRANSITION AND BASE DETAILS.
- F. UNLESS NOTED OTHERWISE FINISHES TO BE:  
a. WALL: PT01  
b. WALL BASE: RB01  
c. FLOOR: C01  
d. GYP. BD.: PT04  
e. EXPOSED OPEN CEILING: PT03
- G. SEALANT AND CAULKING COLORS TO MATCH ADJACENT SURFACE.
- H. ALL ITEMS VISIBLE IN SPACE TO BE FINISHED. MISCELLANEOUS UNFINISHED ITEMS AND DEVICES TO BE REVIEWED WITH ARCHITECT AND OWNER FOR FINAL FINISH.
- I. UNLESS NOTED OTHERWISE ALIGN FLOORING TRANSITION WITH CENTERLINE OF DOOR. IF NO DOOR, ALIGN WITH FINISHED BASE.
- J. ALL COLOR FINISHES FOR TRANSITION STRIPS TO BE SELECTED BY ARCHITECT PRIOR TO MANUFACTURE AND INSTALLATION.
- K. UNLESS NOTED OTHERWISE CONTINUE SCHEDULED FLOORING UNDER MILLWORK.
- L. COVER PLATES TO BE STAINLESS STEEL. UNLESS NOTED OTHERWISE. REPLACE ANY EXISTING OUTLETS AND COVER PLATES THAT DO NOT MATCH NEW.
- M. FURNITURE PLANS ARE SHOWN FOR INFORMATION ONLY.
- N. GENERAL CONTRACTOR, FURNITURE VENDOR, ARCHITECT, AND OWNER TO REVIEW SCOPE RESPONSIBILITY PRIOR TO PROCUREMENT.
- O. REFER TO ENGINEERING AND CONSULTANT DRAWINGS FOR ADDITIONAL POWER AND COMMUNICATION REQUIREMENTS.
- P. INDICATED DIMENSIONS ARE TO THE CENTER LINE OF OUTLET OR SWITCH, OR CLUSTER OF OUTLETS OR SWITCHES, UNLESS OTHERWISE NOTED.
- Q. INSTALL OUTLETS ON OPPOSITE SIDES OF PARTITIONS IN SEPARATE STUD CAVITIES. DO NOT INSTALL BACK-TO-BACK.
- R. COVER PLATES TO BE STAINLESS STEEL. UNLESS NOTED OTHERWISE. REPLACE ANY EXISTING OUTLETS AND COVER PLATES THAT DO NOT MATCH NEW.
- S. ALL THROUGH PENETRATIONS TO MAINTAIN FIRE RESISTANCE RATING OR HORIZONTAL ASSEMBLY IN ACCORDANCE WITH CODE. PROVIDE UL NUMBER OF DEVICES WHERE APPROPRIATE.
- T. COORDINATE LOCATION OF ALL POWER AND COMMUNICATION DEVICES AND STUD UPS IN FIELD WITH FINAL FURNITURE PACKAGE AND FURNITURE VENDOR. THIS INCLUDES THE LOCATION COORDINATION OF THE FURNITURE IN-FEED WITH TABLE TOP BOX TERMINATION WITH FURNITURE AND AV VENDOR. ALL GROMMET LOCATIONS AT FURNITURE AND/OR MILLWORK WITH FURNITURE/MILLWORK VENDORS.
- U. ALL PENETRATION IN STRUCTURAL SLAB TO BE GFR OR X-RAY SCANNED AND APPROVED BY OWNER TO INSURE STRUCTURAL INTEGRITY OF SLAB.
- V. REFER TO ENLARGED PLANS AND ELEVATIONS FOR FURTHER OUTLET DIMENSIONS.

Seal / Signature


Project Name  
**RAMSEY - BASKETBALL LOCKER ROOM RENOVATION**

Project Number  
**009.9478.000**


Description  
ENLARGED PLAN, RCP & INTERIOR ELEVATIONS OF STORAGE

Scale  
As indicated


**11.109**

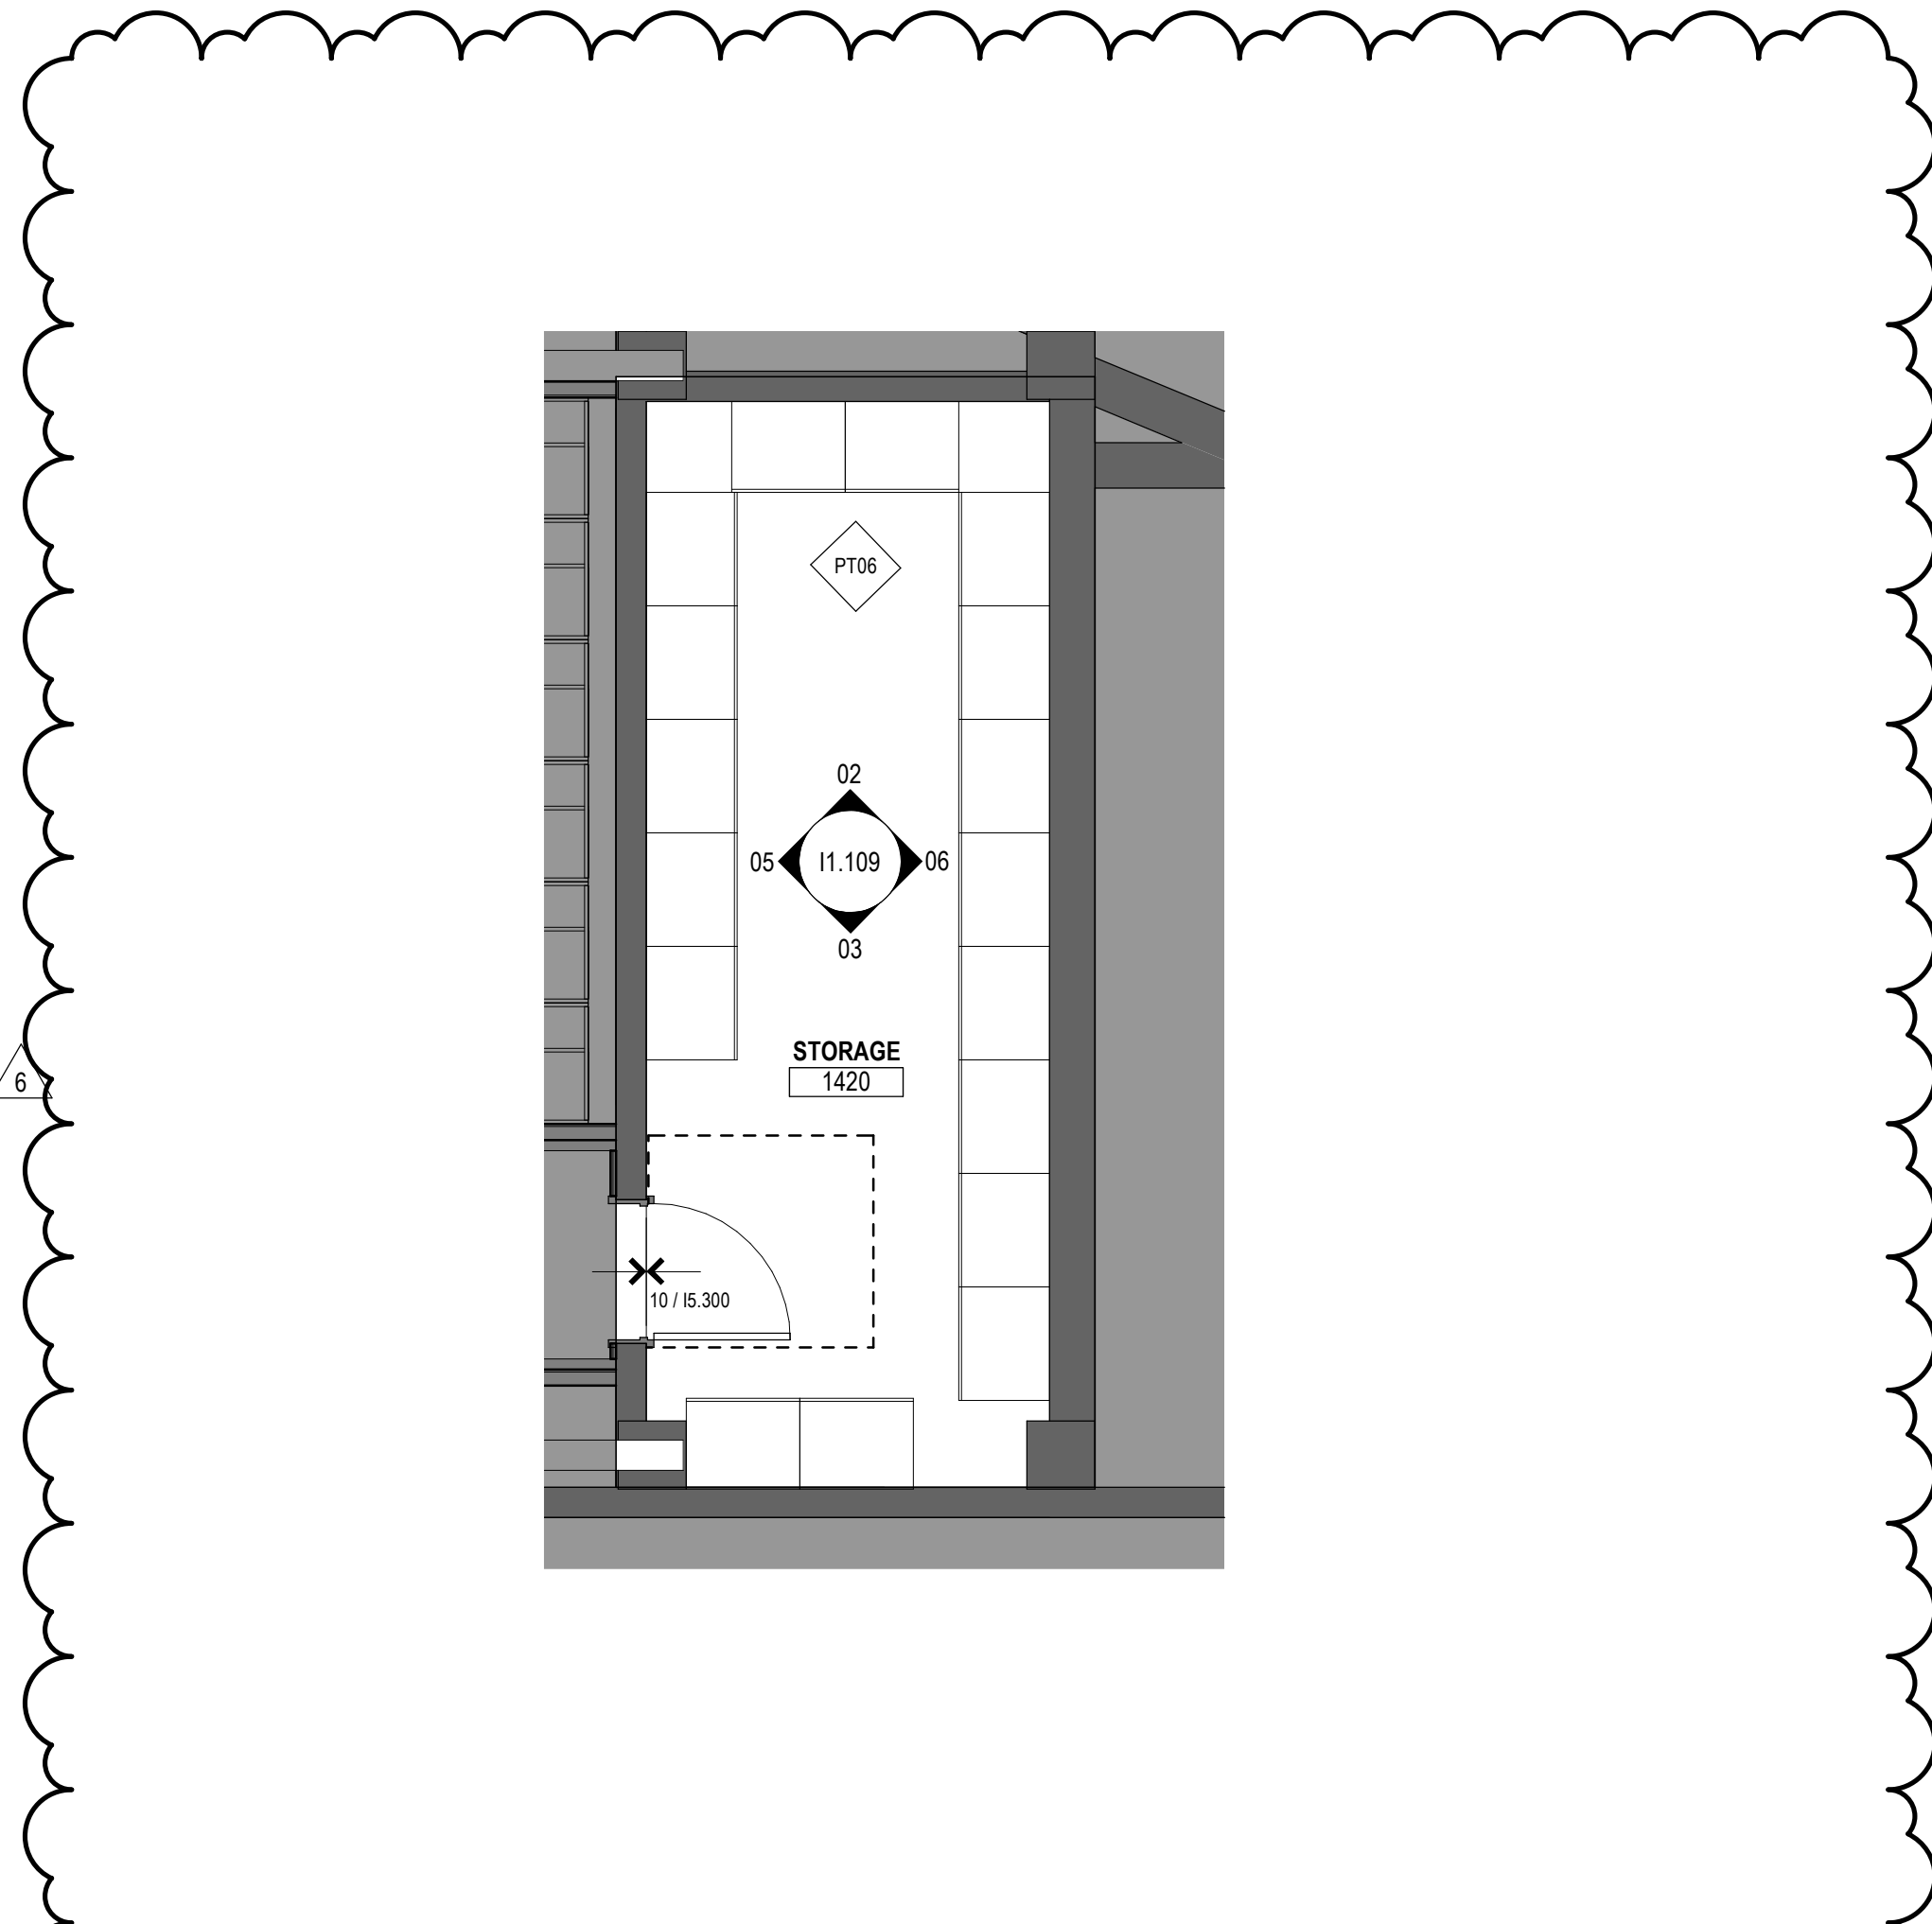


**07 ENLARGED FINISH PLAN @ STORAGE**  
SCALE: 1/4" = 1'-0"

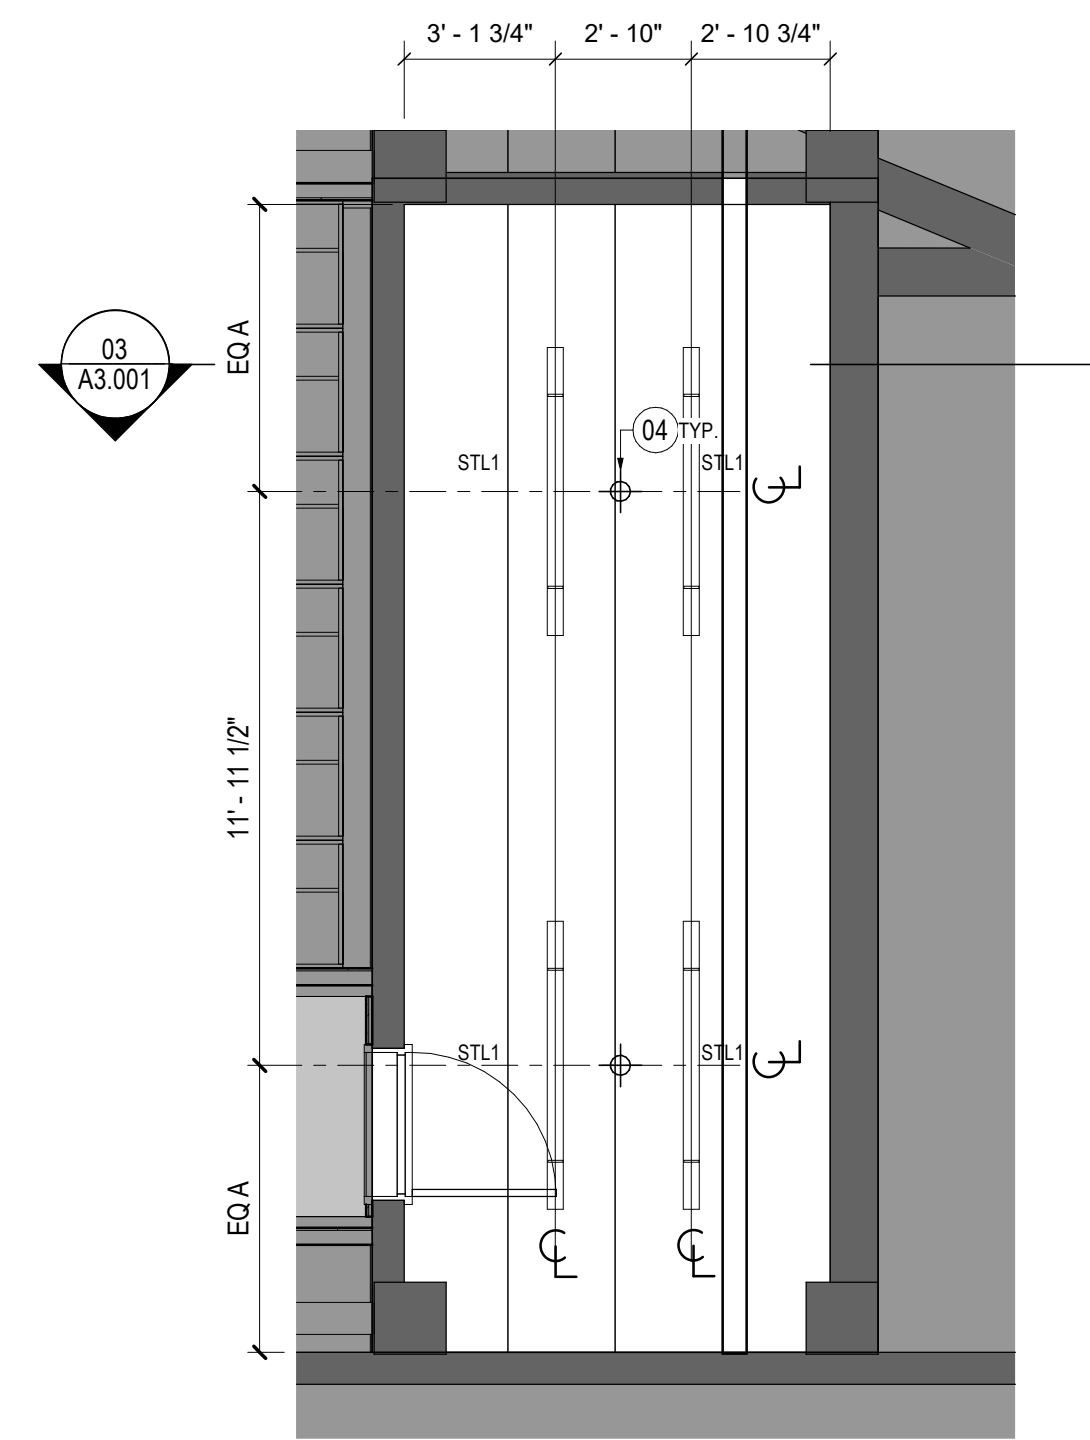


**04 ENLARGED RCP @ STORAGE**  
SCALE: 1/4" = 1'-0"

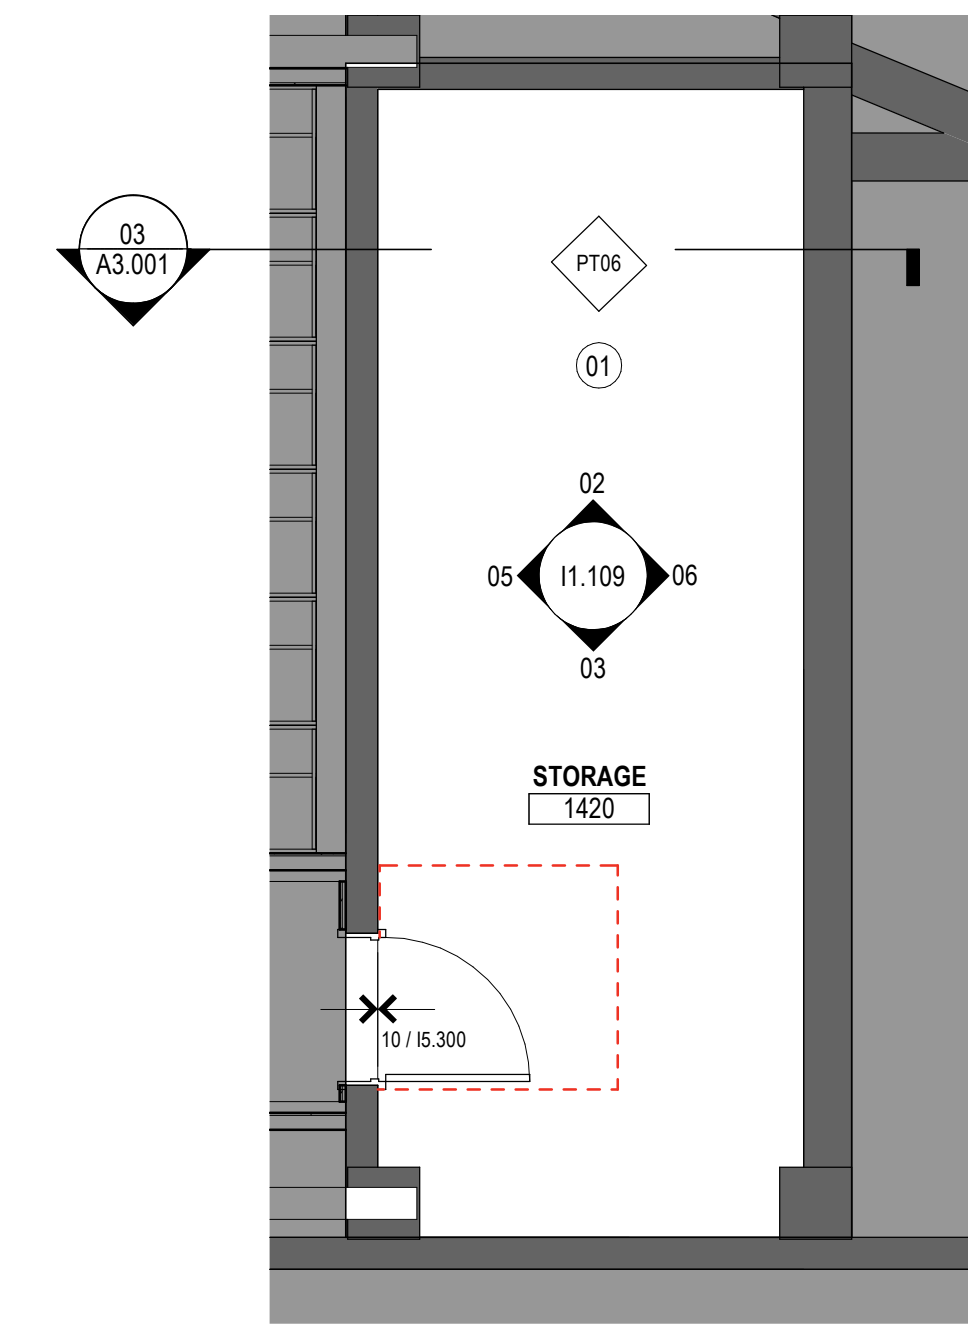


**01 ENLARGED PLAN @ STORAGE**  
SCALE: 1/4" = 1'-0"

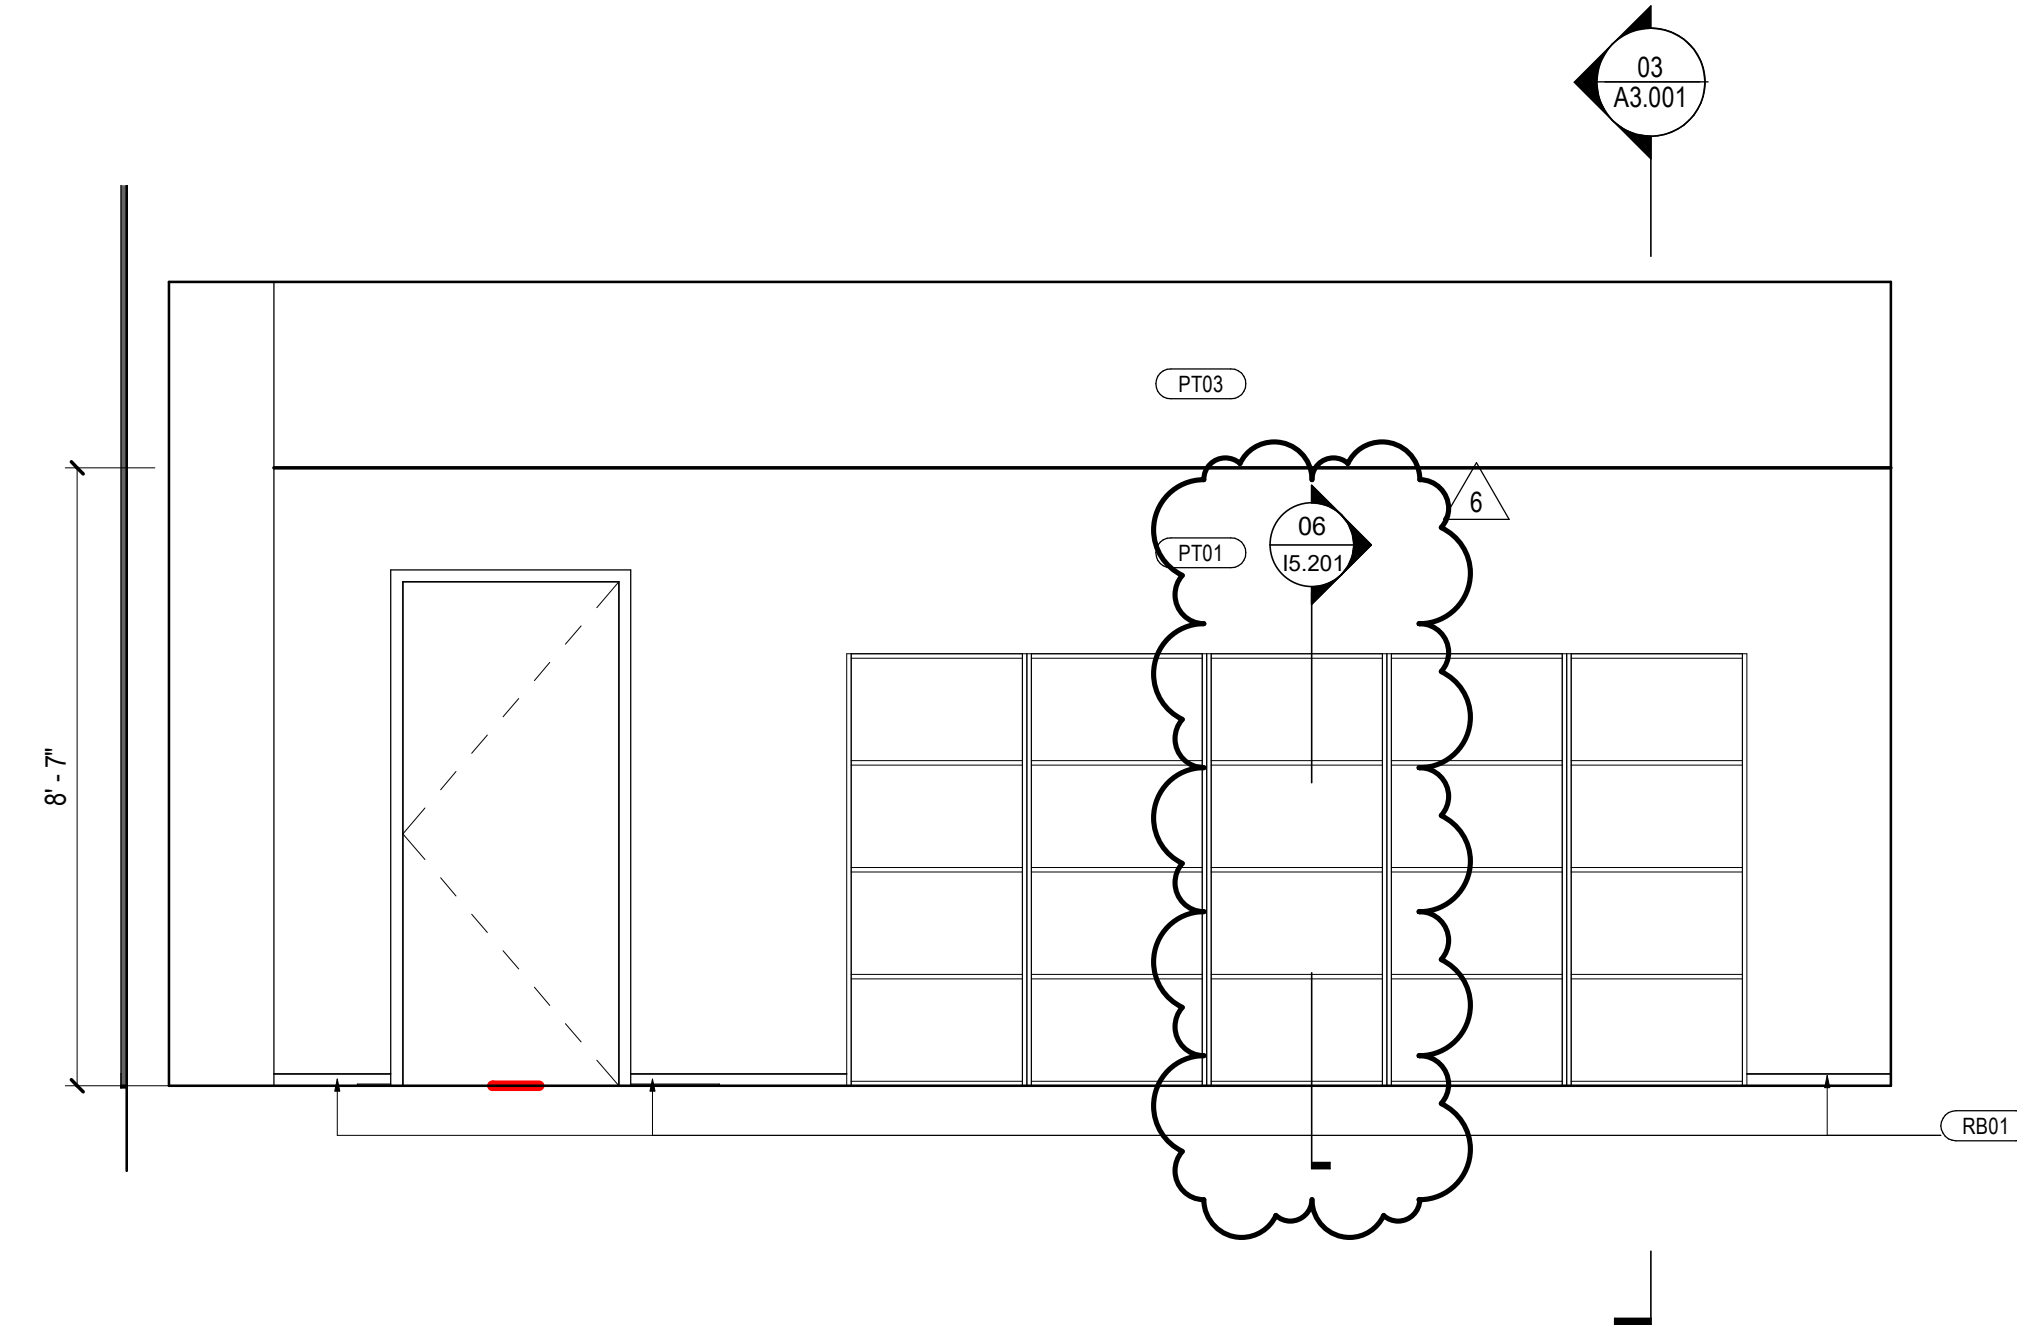


**05 ELEVATION @ STORAGE WEST**  
SCALE: 3/8" = 1'-0"

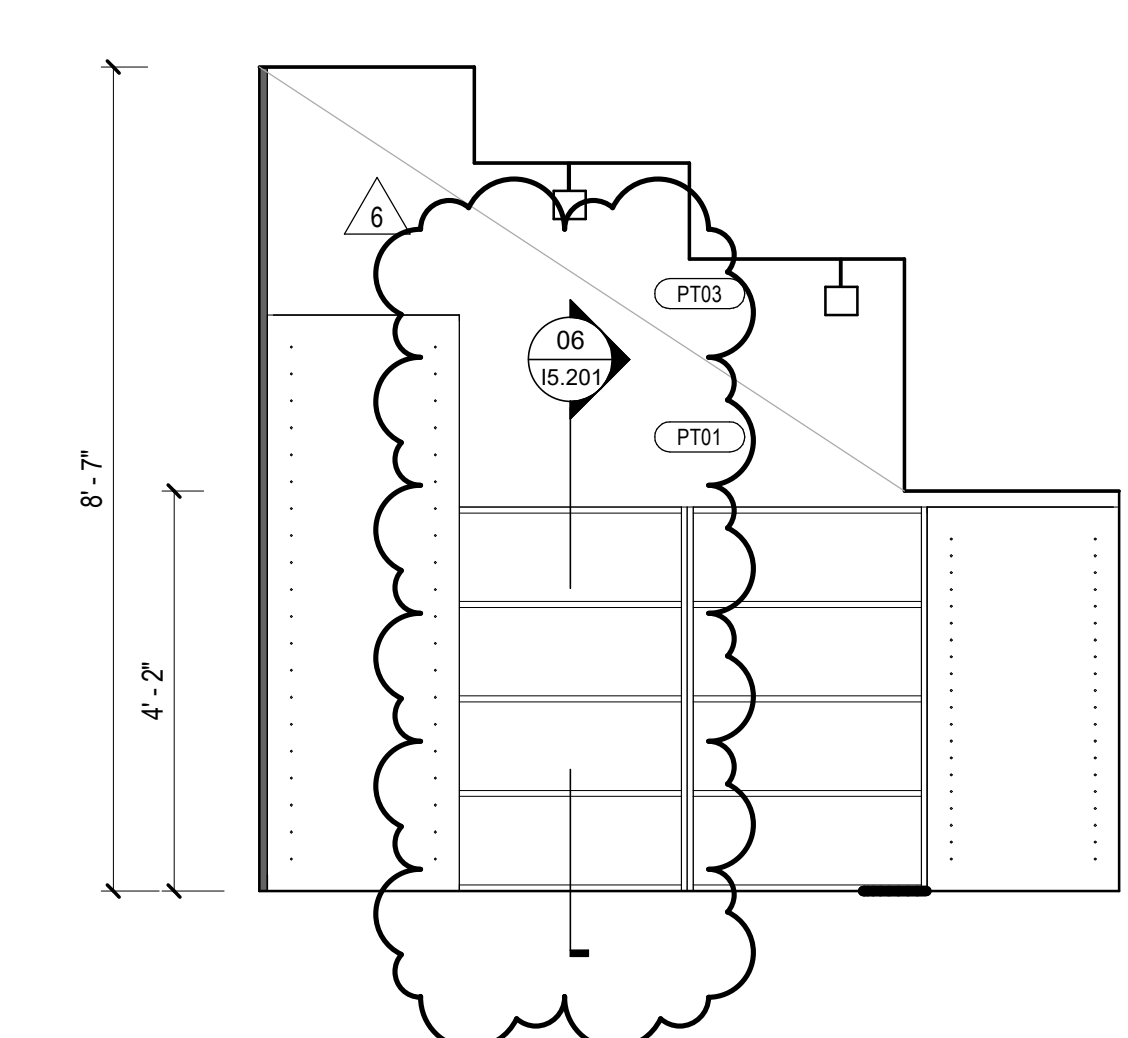

**02 ELEVATION @ STORAGE NORTH**  
SCALE: 1/2" = 1'-0"

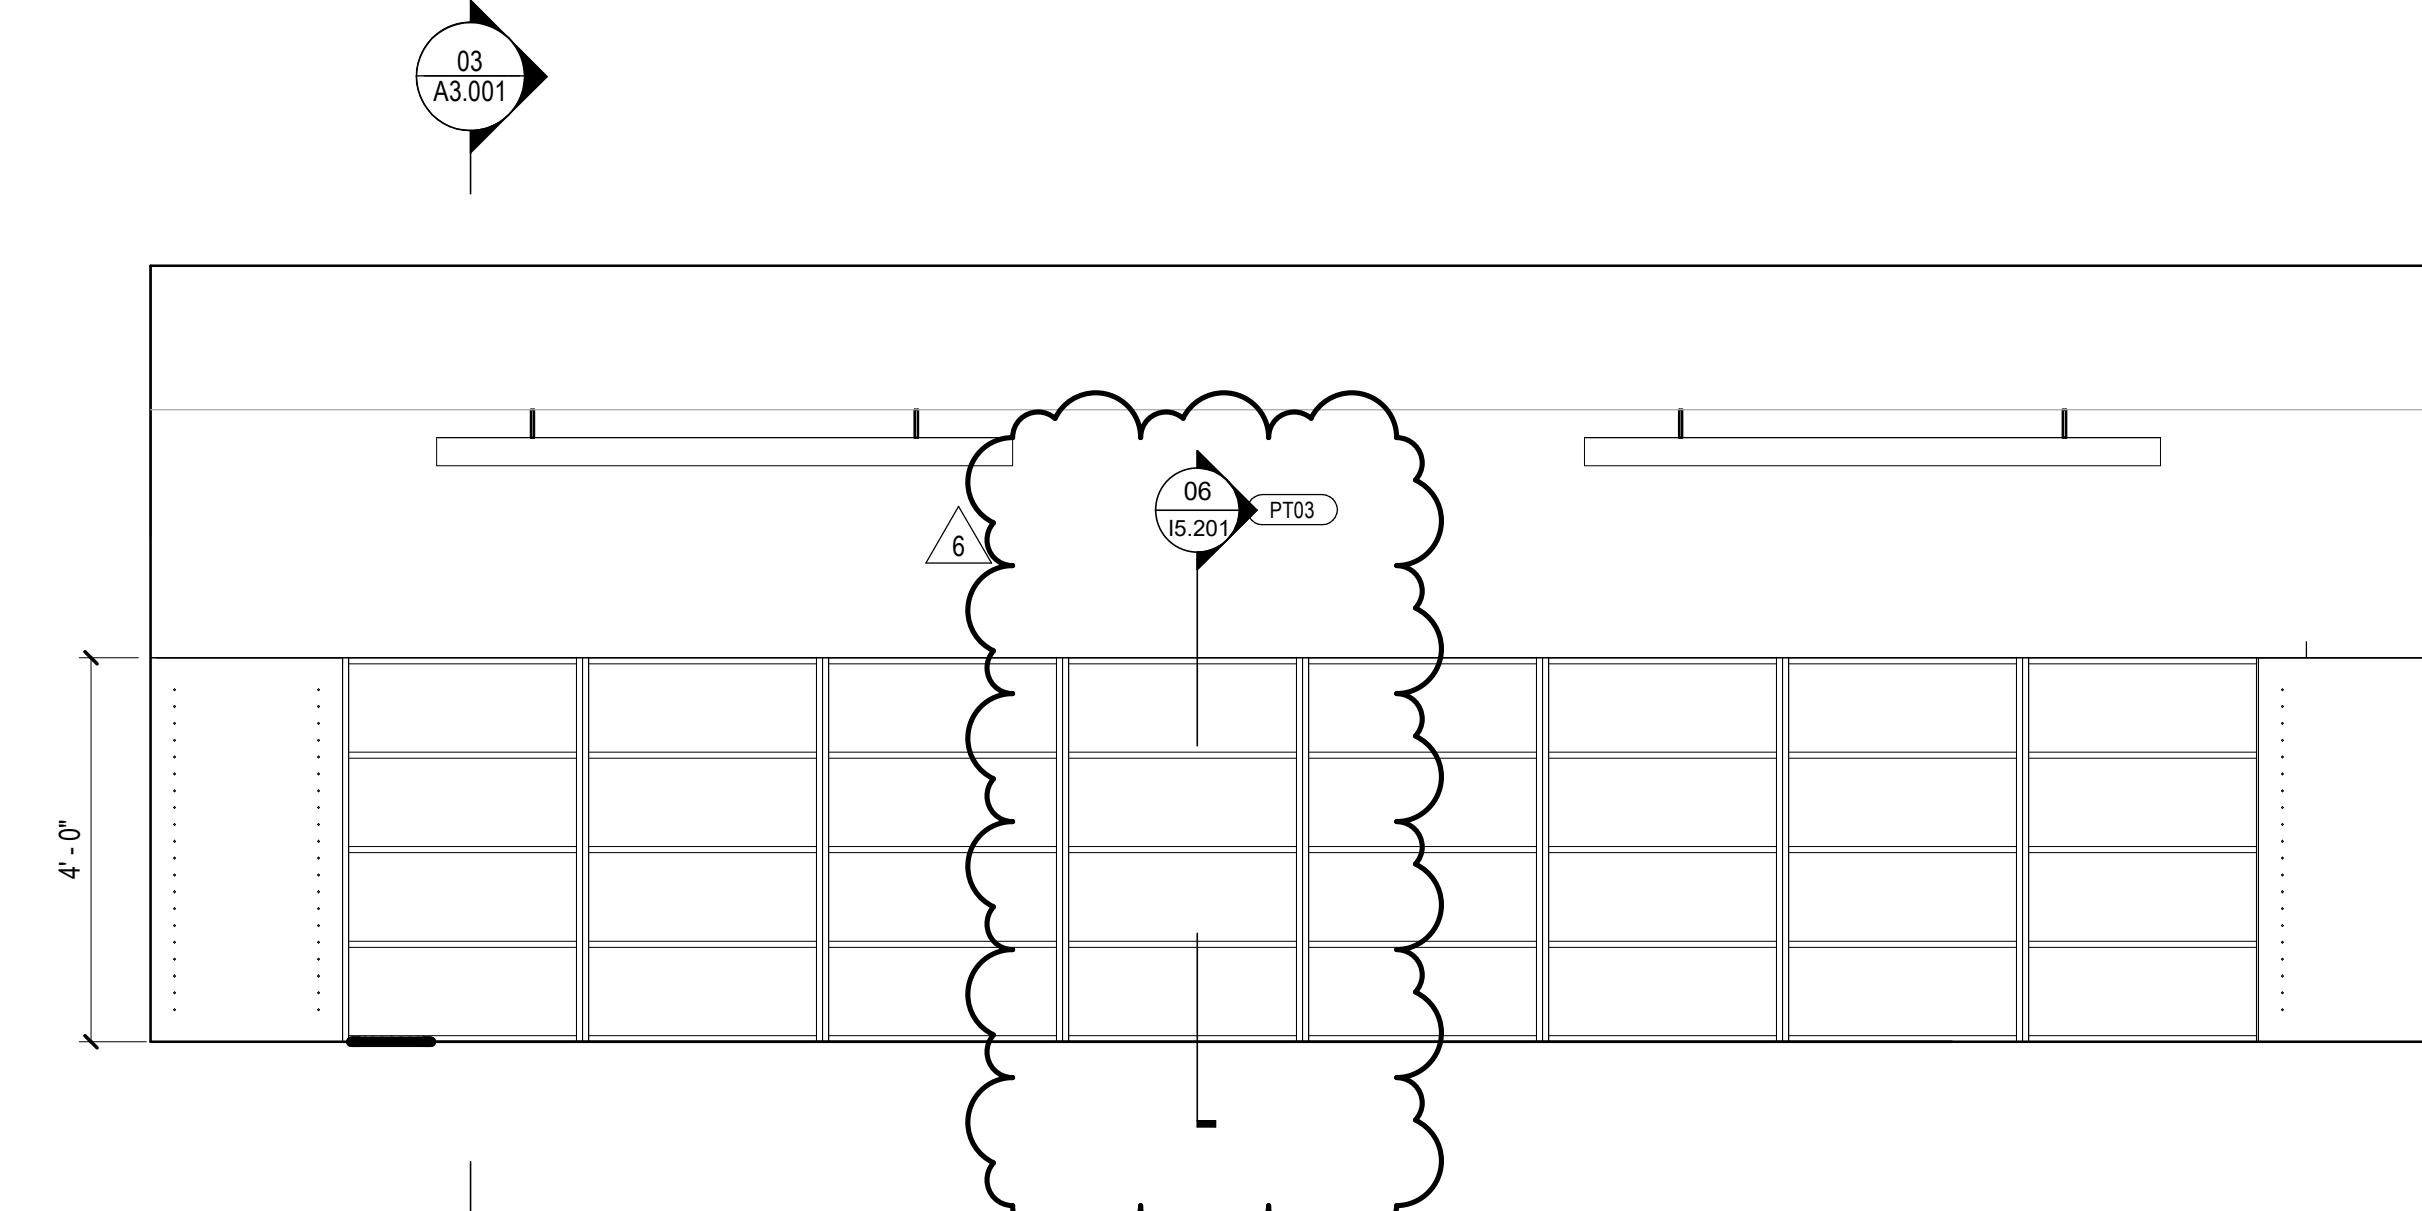


**06 ELEVATION @ STORAGE EAST**  
SCALE: 1/2" = 1'-0"

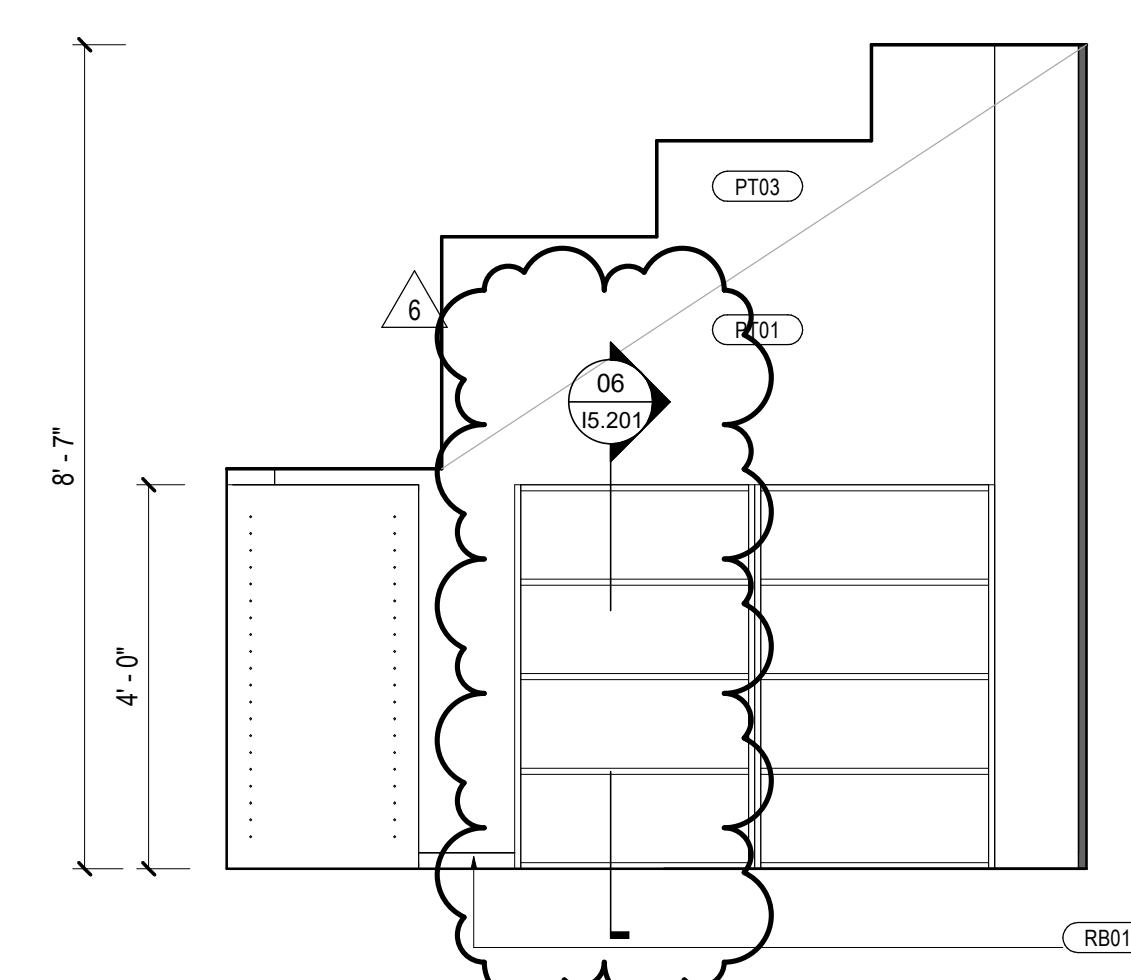


**03 ELEVATION @ STORAGE SOUTH**  
SCALE: 1/2" = 1'-0"




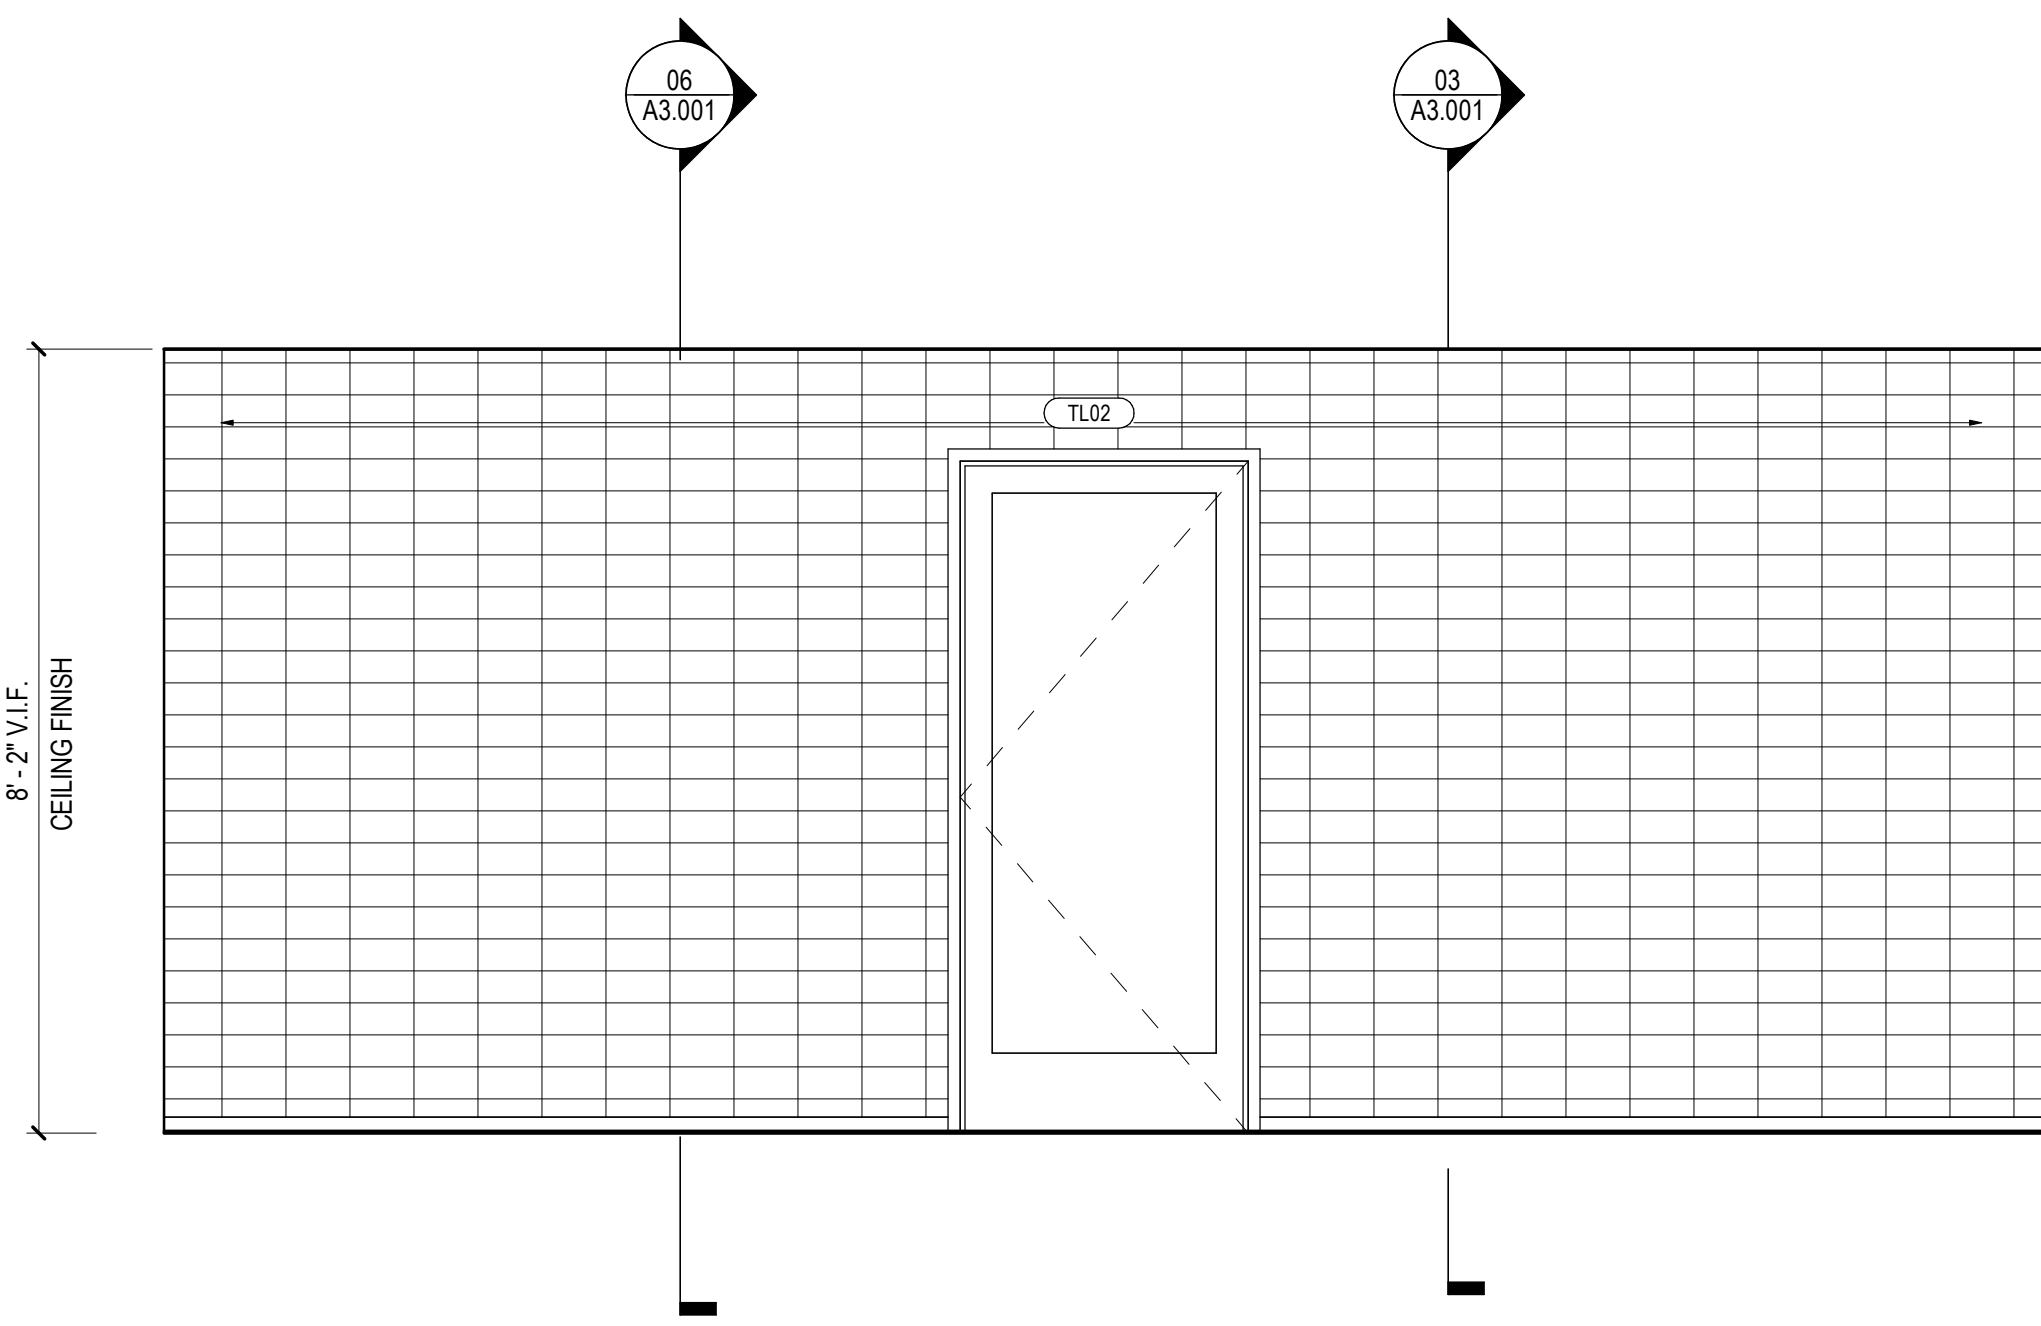


**07 ELEVATION @ MEN'S SHOWER EAST**  
SCALE: 1/2" = 1'-0"

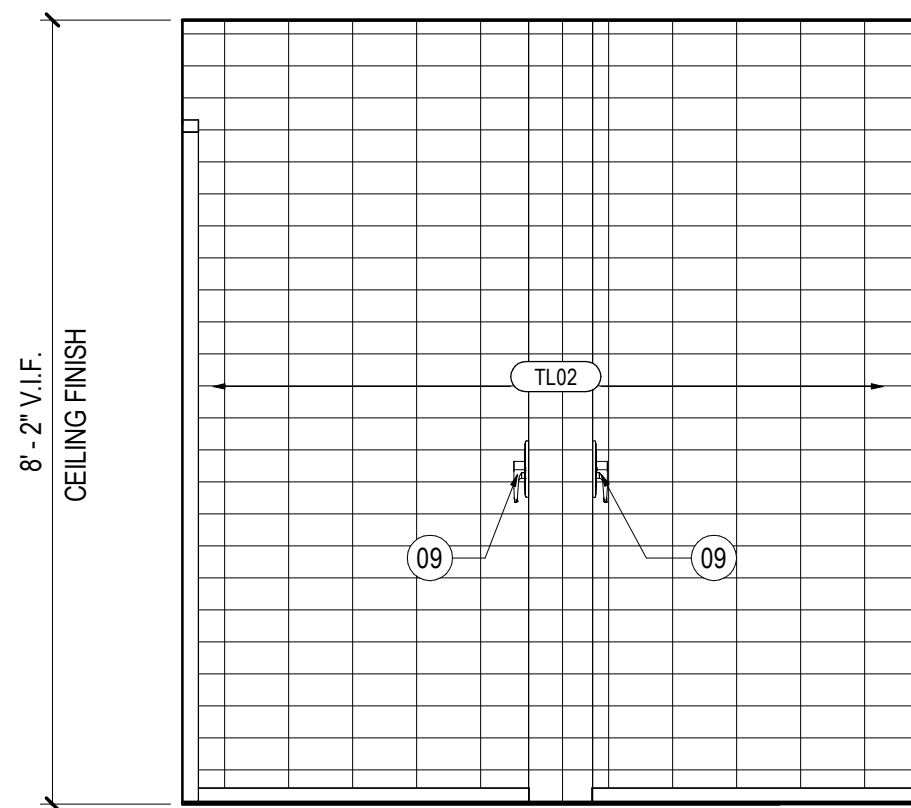


**04 ELEVATION @ MEN'S SHOWER SOUTH**  
SCALE: 1/2" = 1'-0"

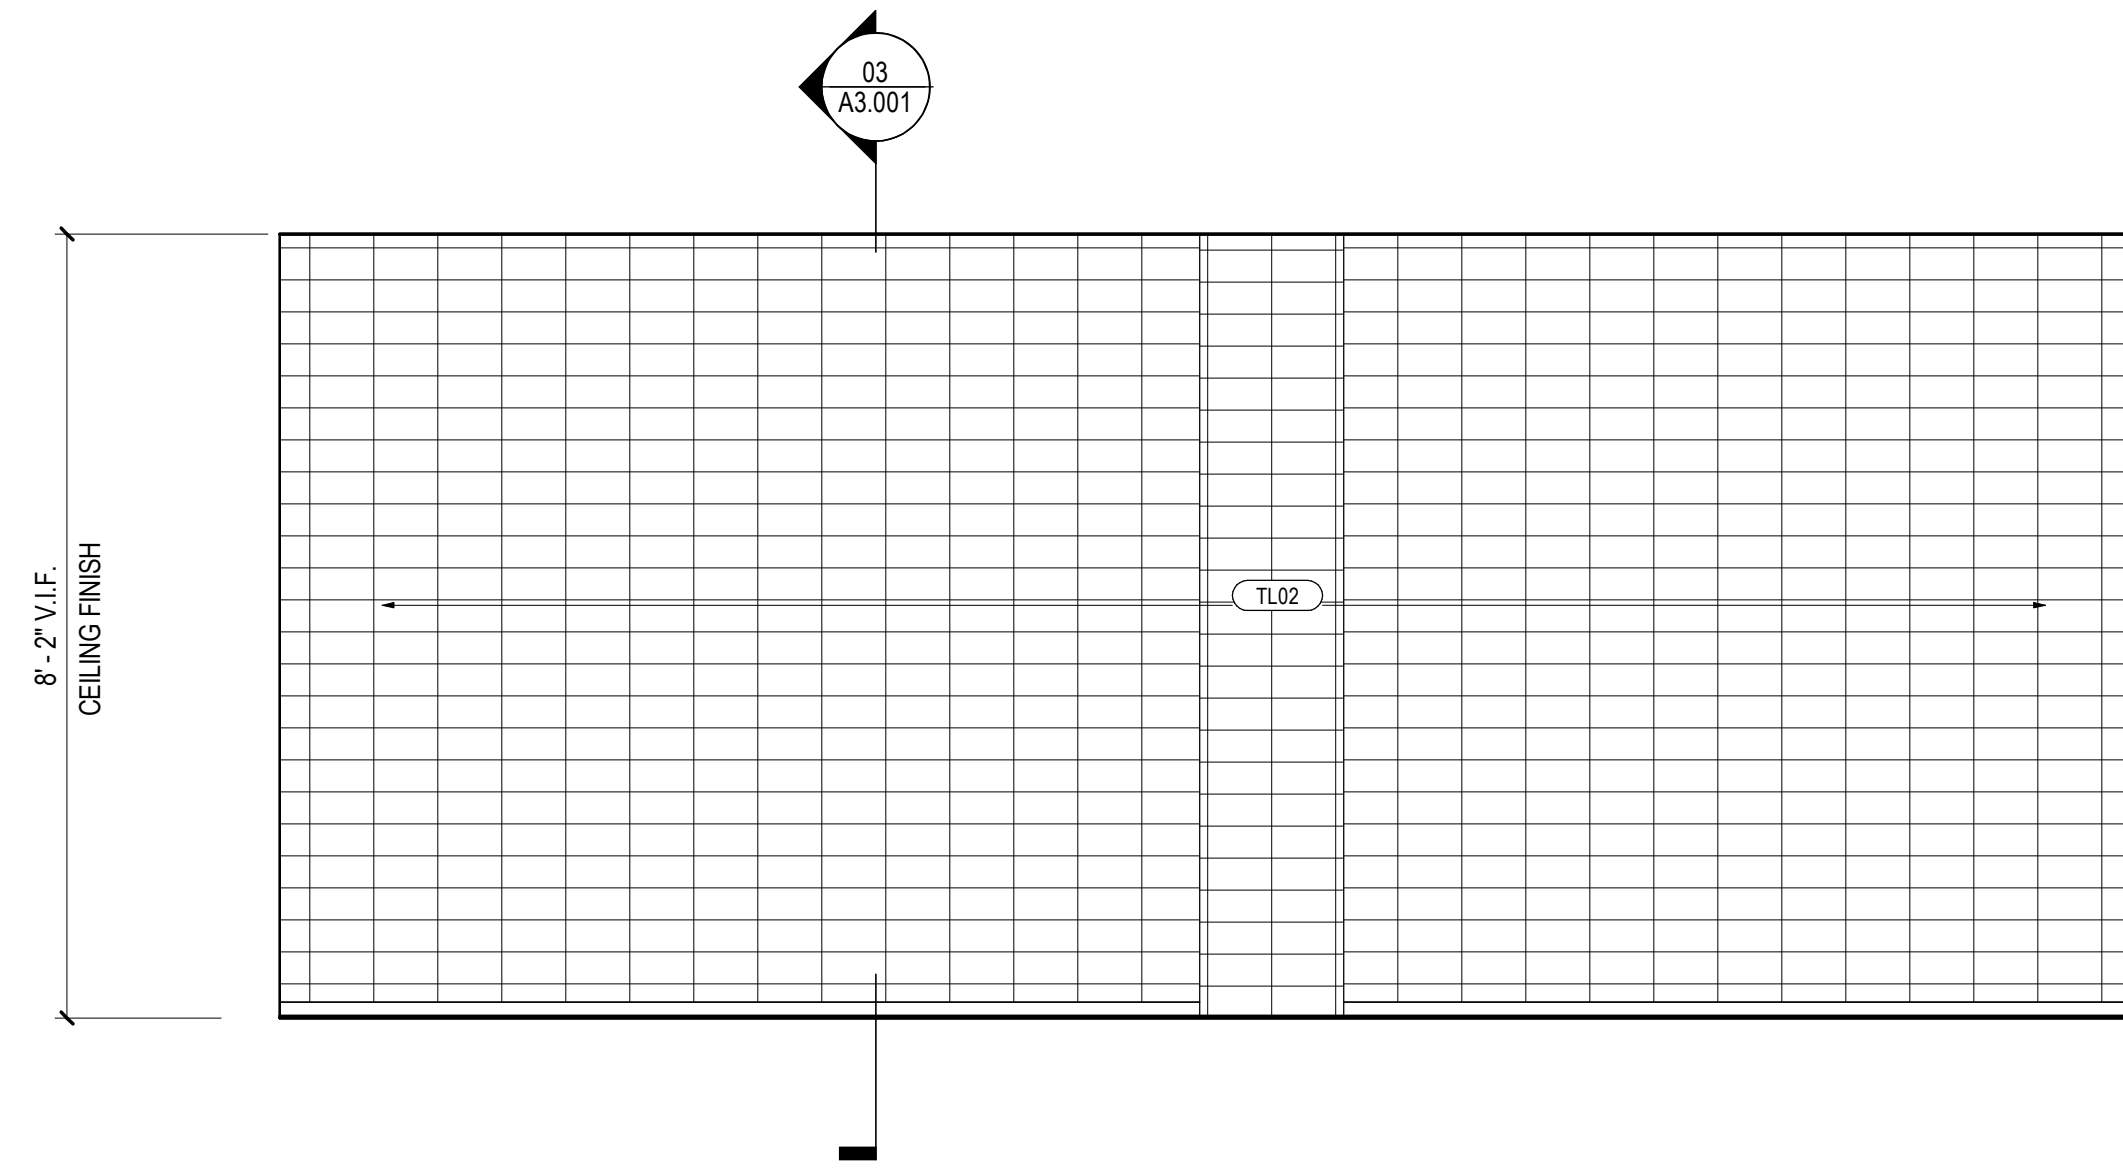


**01 ELEVATION @ MEN'S SHOWER WEST**  
SCALE: 1/2" = 1'-0"

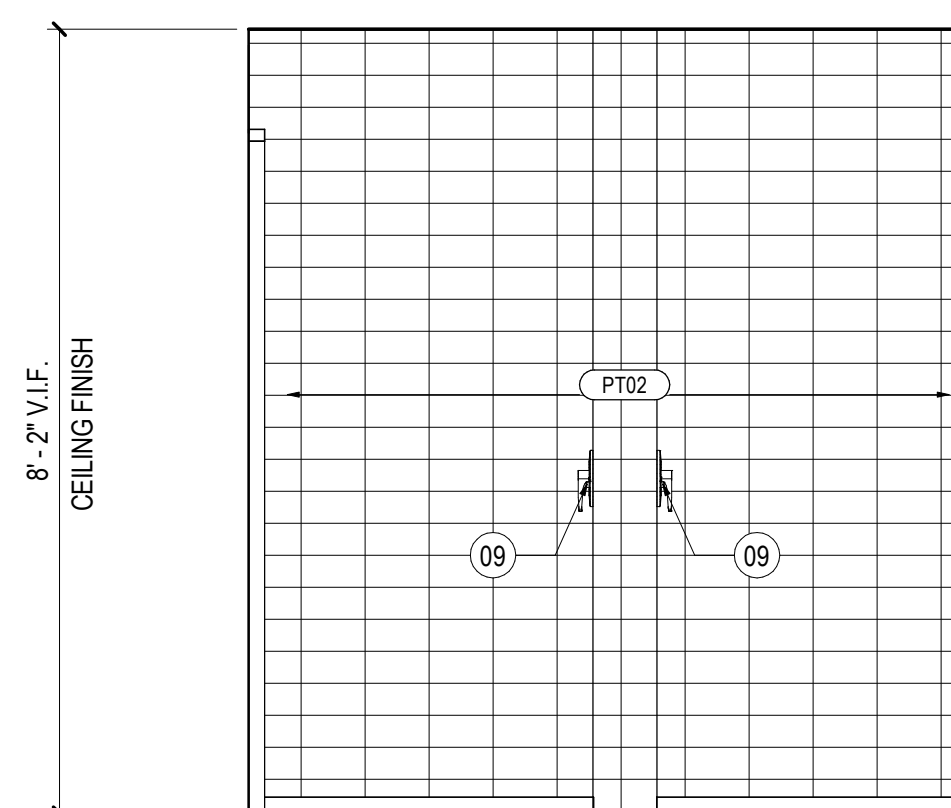


**05 ELEVATION @ WOMEN'S SHOWER NORTH**  
SCALE: 1/2" = 1'-0"

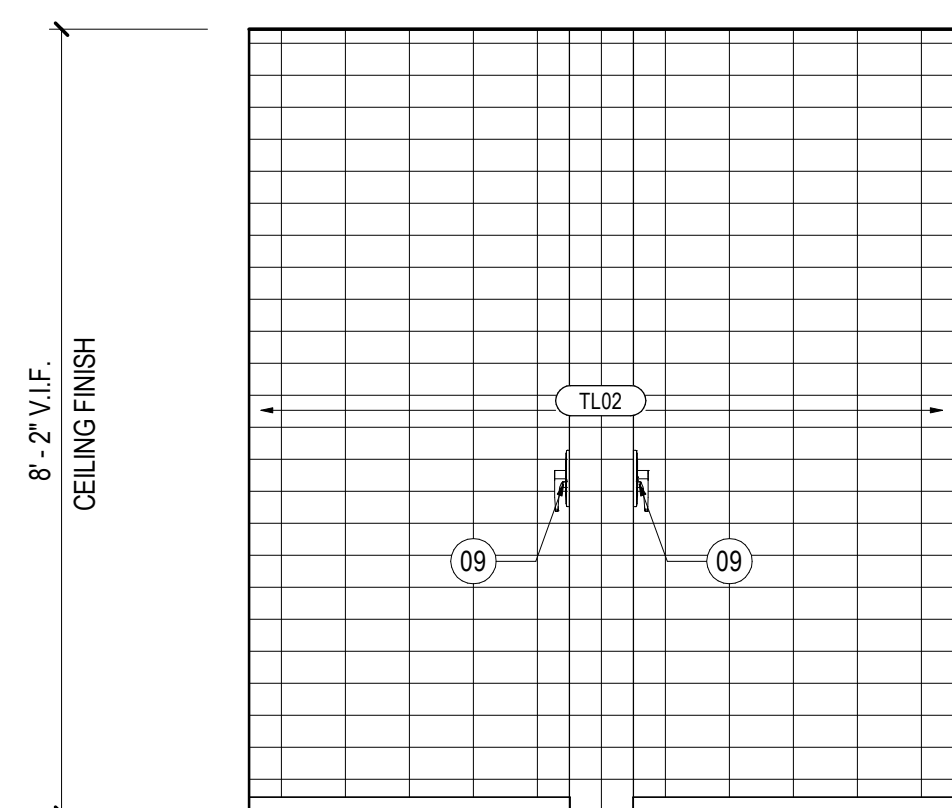


**02 ELEVATION @ MEN'S SHOWER NORTH**  
SCALE: 1/2" = 1'-0"

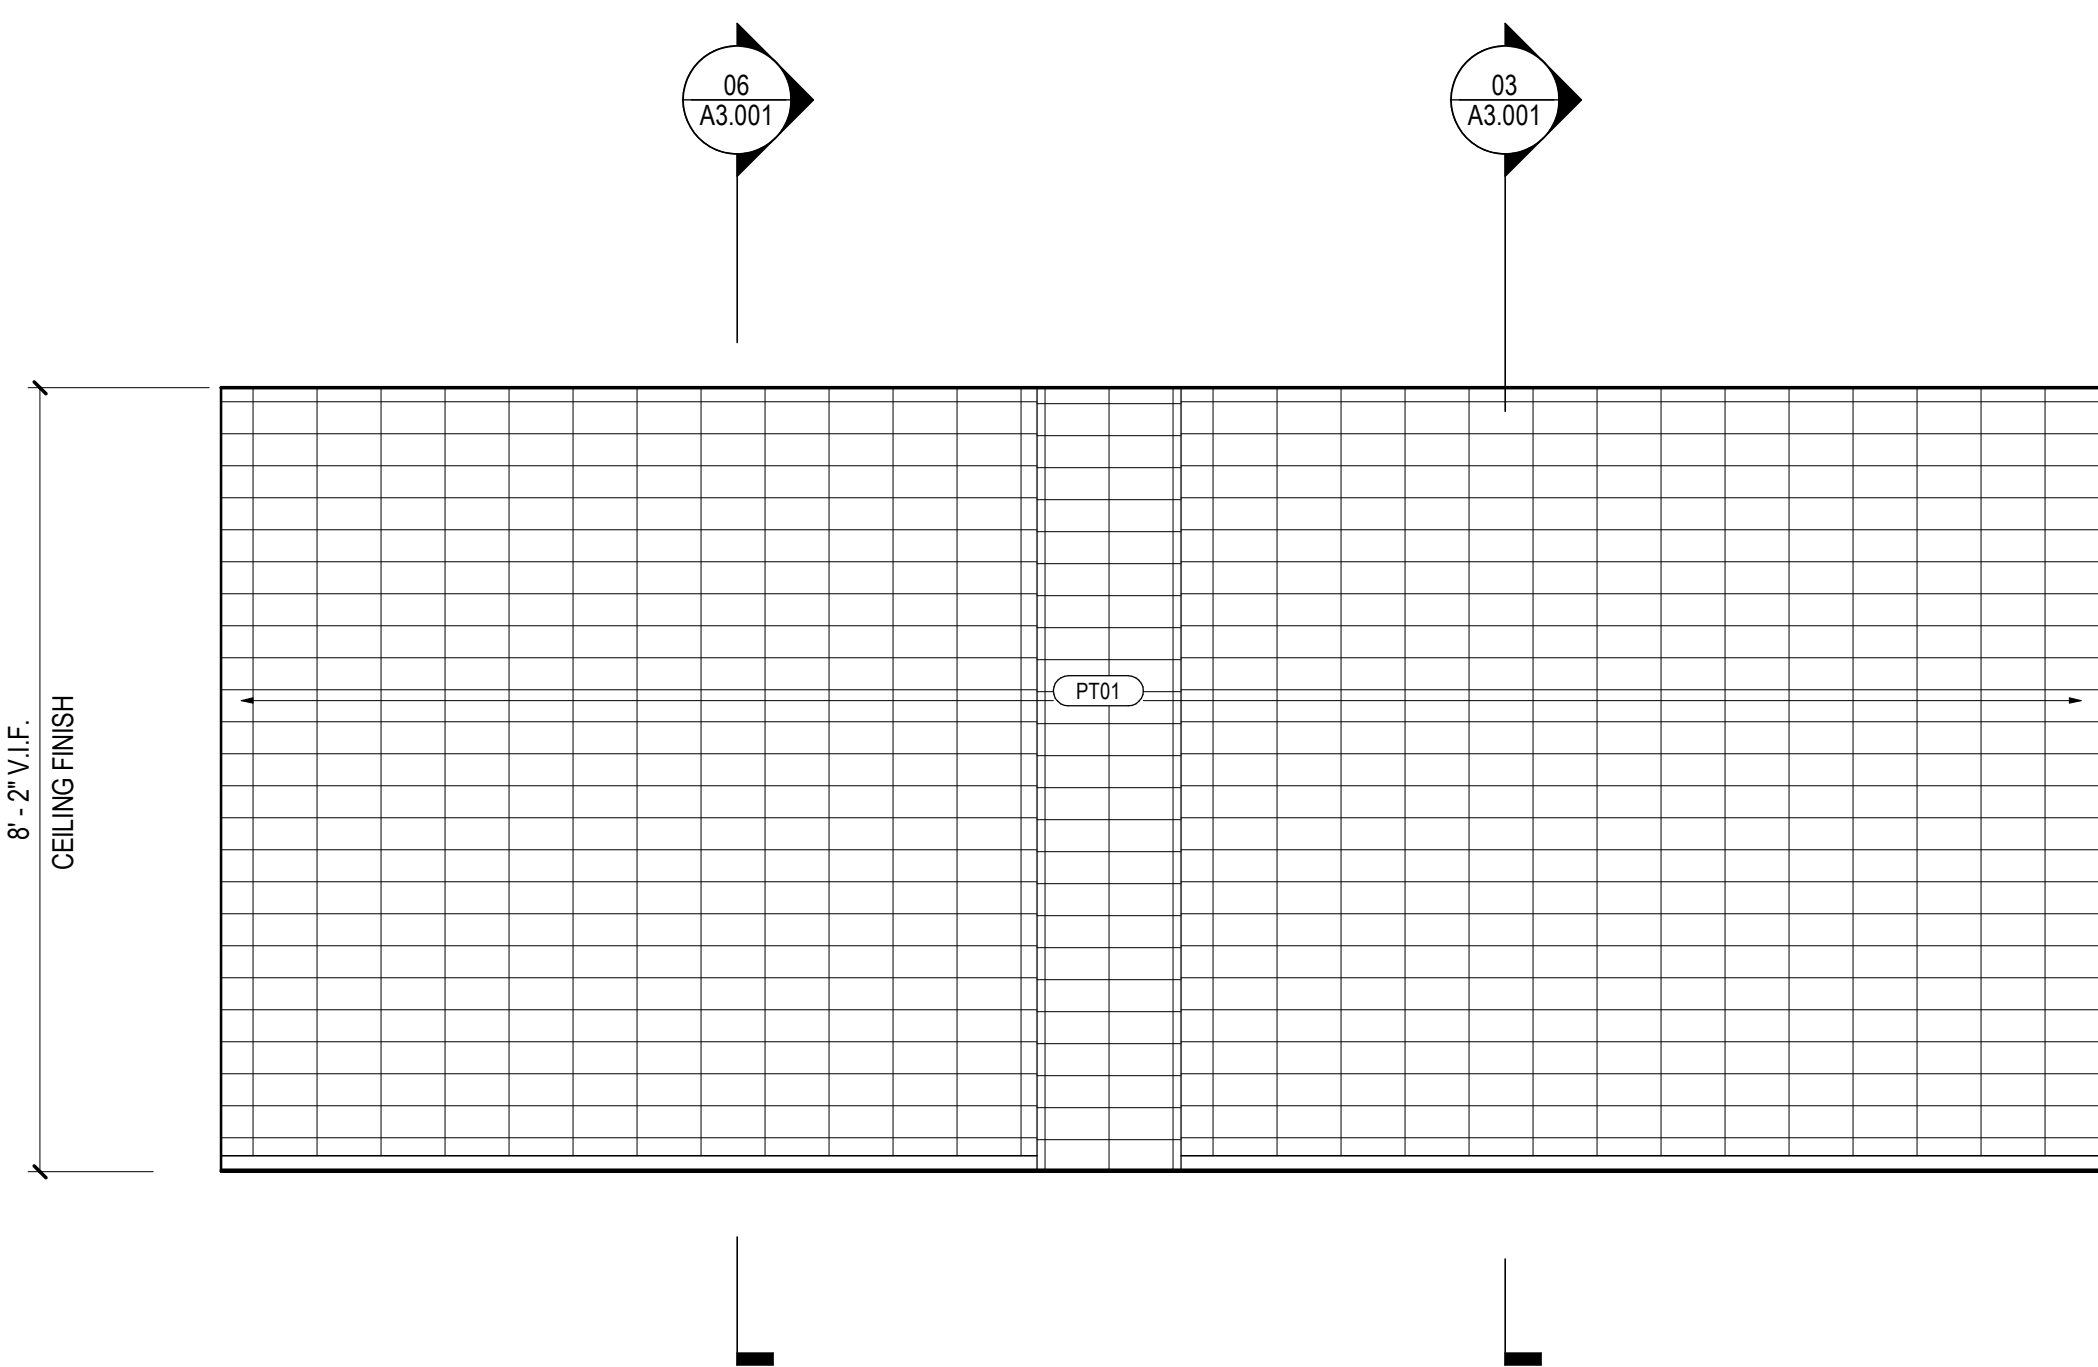

**09 ELEVATION @ WOMEN'S SHOWER EAST**  
SCALE: 1/2" = 1'-0"

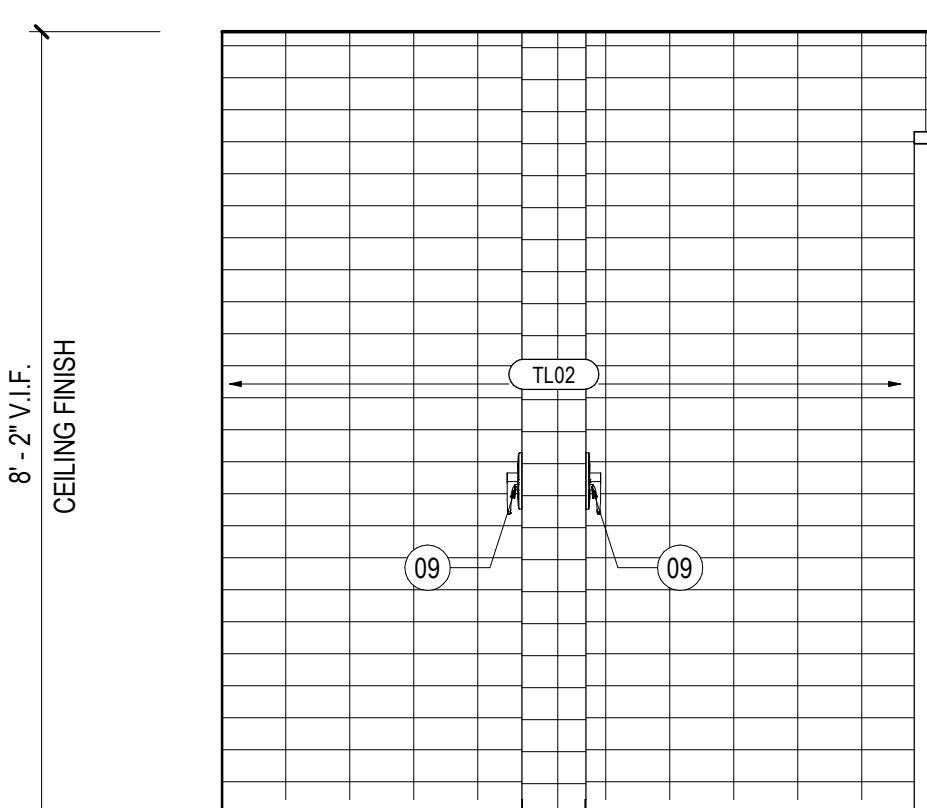

**06 ELEVATION @ WOMEN'S SHOWER SOUTH**  
SCALE: 1/2" = 1'-0"

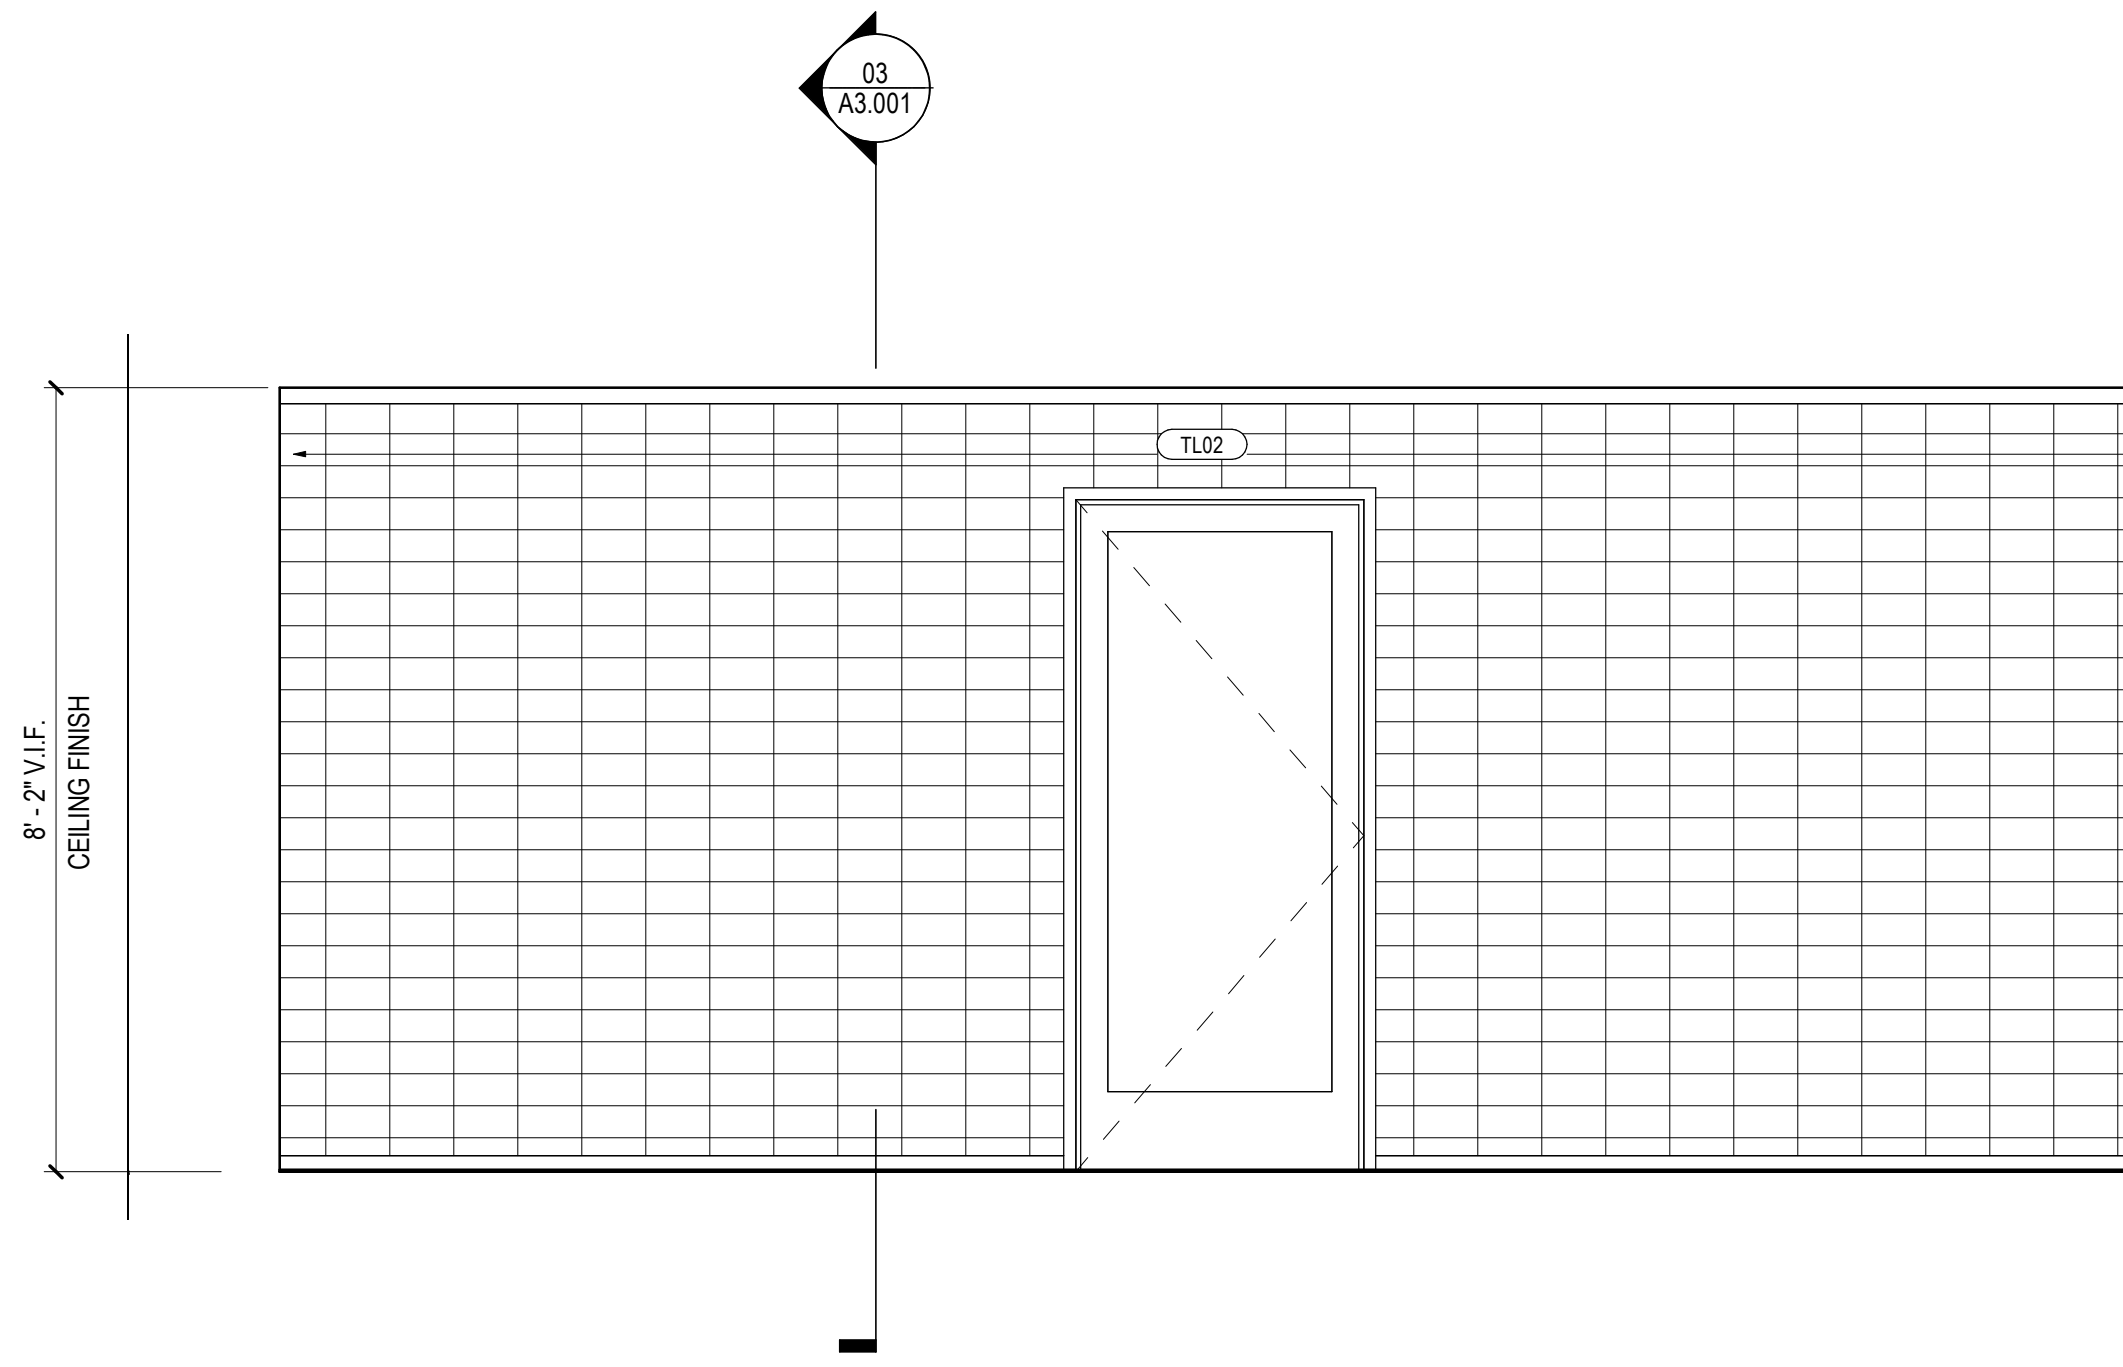

**03 ELEVATION @ WOMEN'S SHOWER WEST**  
SCALE: 1/2" = 1'-0"

**SHEET NOTES**

09 FIXTURE IS EXISTING TO REMAIN.



92 Catamount Road  
Cullowhee, NC 28723

**Gensler**

2020 K St NW  
Washington, DC 20006  
United States  
Tel (202) 721-5200  
Fax +1 202 872 8587



**MEP ENGINEERS**  
1927 South Tryon Street  
Suite 300  
Charlotte, NC 28203  
Tel 704.338.1292

SCO ID: 21-22998-01  
CIP: 42029

**GENERAL NOTES**

- A. AREAS TONED IN GRAY ARE NOT IN CONTRACT.
- B. REFER TO SHEET G1.01 FOR GRAPHIC SYMBOLS AND ABBREVIATIONS.
- C. REFER TO SHEET G1.10 FOR TYPICAL MOUNTING HEIGHTS, AND LOCATION DIAGRAMS.
- D. ON TYPICAL FLOORS PATCH AND EXTEND RESILIENT BASE AS NECESSARY WITH NEW TO MATCH EXISTING.
- E. REFER TO SHEET IS.300, FOR TRANSITION AND BASE DETAILS.
- F. UNLESS NOTED OTHERWISE FINISHES TO BE:
  - a. WALL - PT01
  - b. WALL BASE - RB01
  - c. FLOOR - C01
  - d. GYP. BD - PT04
  - e. EXPOSED OPEN CEILING - PT03
- G. SEALANT AND CAULKING COLORS TO MATCH ADJACENT SURFACE.
- H. ALL ITEMS VISIBLE IN SPACE TO BE FINISHED. MISCELLANEOUS UNFINISHED ITEMS AND DEVICES TO BE REVIEWED WITH ARCHITECT AND OWNER FOR FINAL FINISH.
- I. UNLESS NOTED OTHERWISE ALIGN FLOORING TRANSITION WITH CENTERLINE OF DOOR. IF NO DOOR, ALIGN WITH FINISHED BASE.
- J. ALL COLOR FINISHES FOR TRANSITION STRIPS TO BE SELECTED BY ARCHITECT PRIOR TO MANUFACTURE AND INSTALLATION.
- K. UNLESS NOTED OTHERWISE CONTINUE SCHEDULED FLOORING UNDER MILLWORK.
- L. COVER PLATES TO BE STAINLESS STEEL. UNLESS NOTED OTHERWISE, REPLACE ANY EXISTING OUTLETS AND COVER PLATES THAT DO NOT MATCH NEW.
- M. FURNITURE PLANS ARE SHOWN FOR INFORMATION ONLY.
- N. GENERAL CONTRACTOR, FURNITURE VENDOR, ARCHITECT, AND OWNER TO REVIEW SCOPE RESPONSIBILITY PRIOR TO PROCUREMENT.
- O. REFER TO ENGINEERING AND CONSULTANT DRAWINGS FOR ADDITIONAL POWER AND COMMUNICATION REQUIREMENTS.
- P. INDICATED DIMENSIONS ARE TO THE CENTER LINE OF OUTLET OR SWITCH, OR GLISTER OF OUTLETS OR SWITCHES, UNLESS OTHERWISE NOTED.
- Q. INSTALL OUTLETS ON OPPOSITE SIDES OF PARTITIONS IN SEPARATE STUD CAVITIES. DO NOT INSTALL BACK-TO-BACK.
- R. COVER PLATES TO BE STAINLESS STEEL. UNLESS NOTED OTHERWISE, REPLACE ANY EXISTING OUTLETS AND COVERPLATES THAT DO NOT MATCH NEW.
- S. ALL THROUGH PENETRATIONS TO MAINTAIN FIRE RESISTANCE RATING OR HORIZONTAL ASSEMBLY IN ACCORDANCE WITH CODE. PROVIDE UL NUMBER OF DEVICES WHERE APPROPRIATE.
- T. COORDINATE LOCATION OF ALL POWER AND COMMUNICATION DEVICES AND STUB UPS IN FIELD WITH FINAL FURNITURE PACKAGE AND FURNITURE VENDOR. THIS INCLUDES THE LOCATION COORDINATION OF THE FURNITURE IN-FEED WITH TABLE TOP BOX TERMINATION WITH FURNITURE AND AV VENDOR. ALL GROMMET LOCATIONS AT FURNITURE AND/OR MILLWORK WITH FURNITURE/MILLWORK VENDORS.
- U. ALL PENETRATION IN STRUCTURAL SLAB TO BE GPR OR X-RAY SCANNED AND APPROVED BY OWNER TO INSURE STRUCTURAL INTEGRITY OF SLAB.
- V. REFER TO ENLARGED PLANS AND ELEVATIONS FOR FURTHER OUTLET DIMENSIONS.

Date	Description
6 11/30/2021	ADDENDUM 02

Seal / Signature

Project Name  
**RAMSEY - BASKETBALL LOCKER ROOM RENOVATION**


Project Number  
**009.9478.000**

Description  
**INTERIOR ELEVATIONS @ SHOWERS**


Scale  
1/2" = 1'-0"

**11.110**




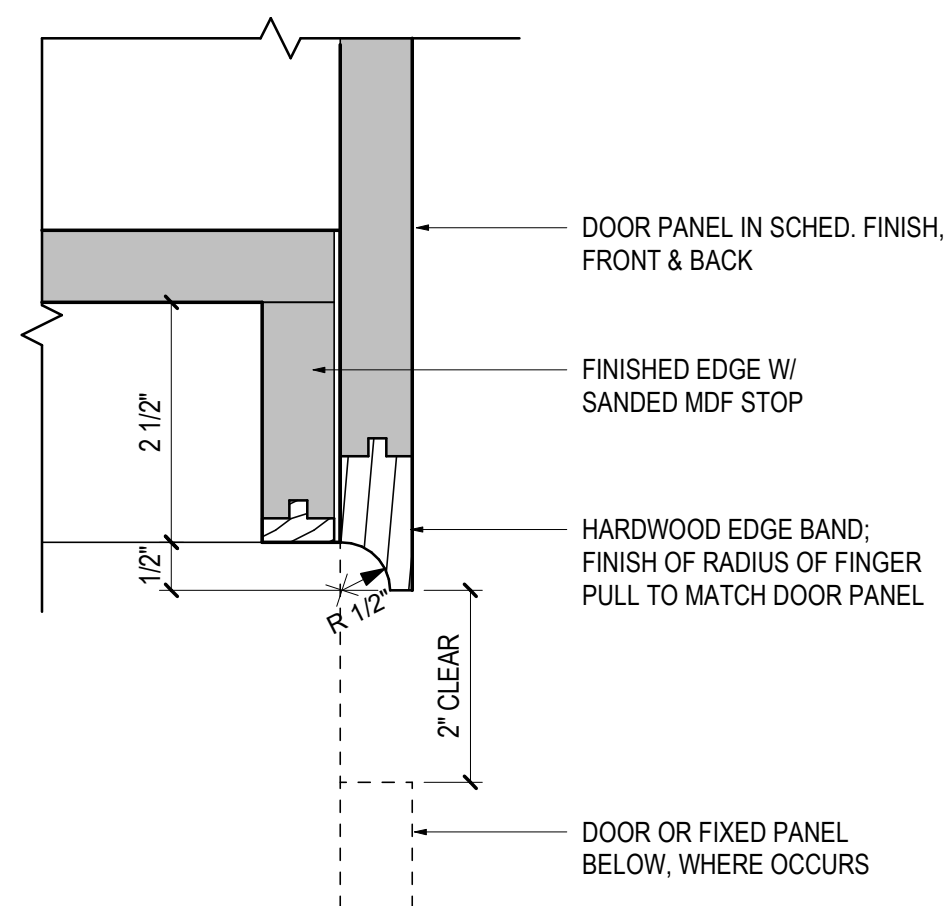


**09** DETAIL OVERHEAD FINGER PULL  
SCALE: 6" = 1'-0"

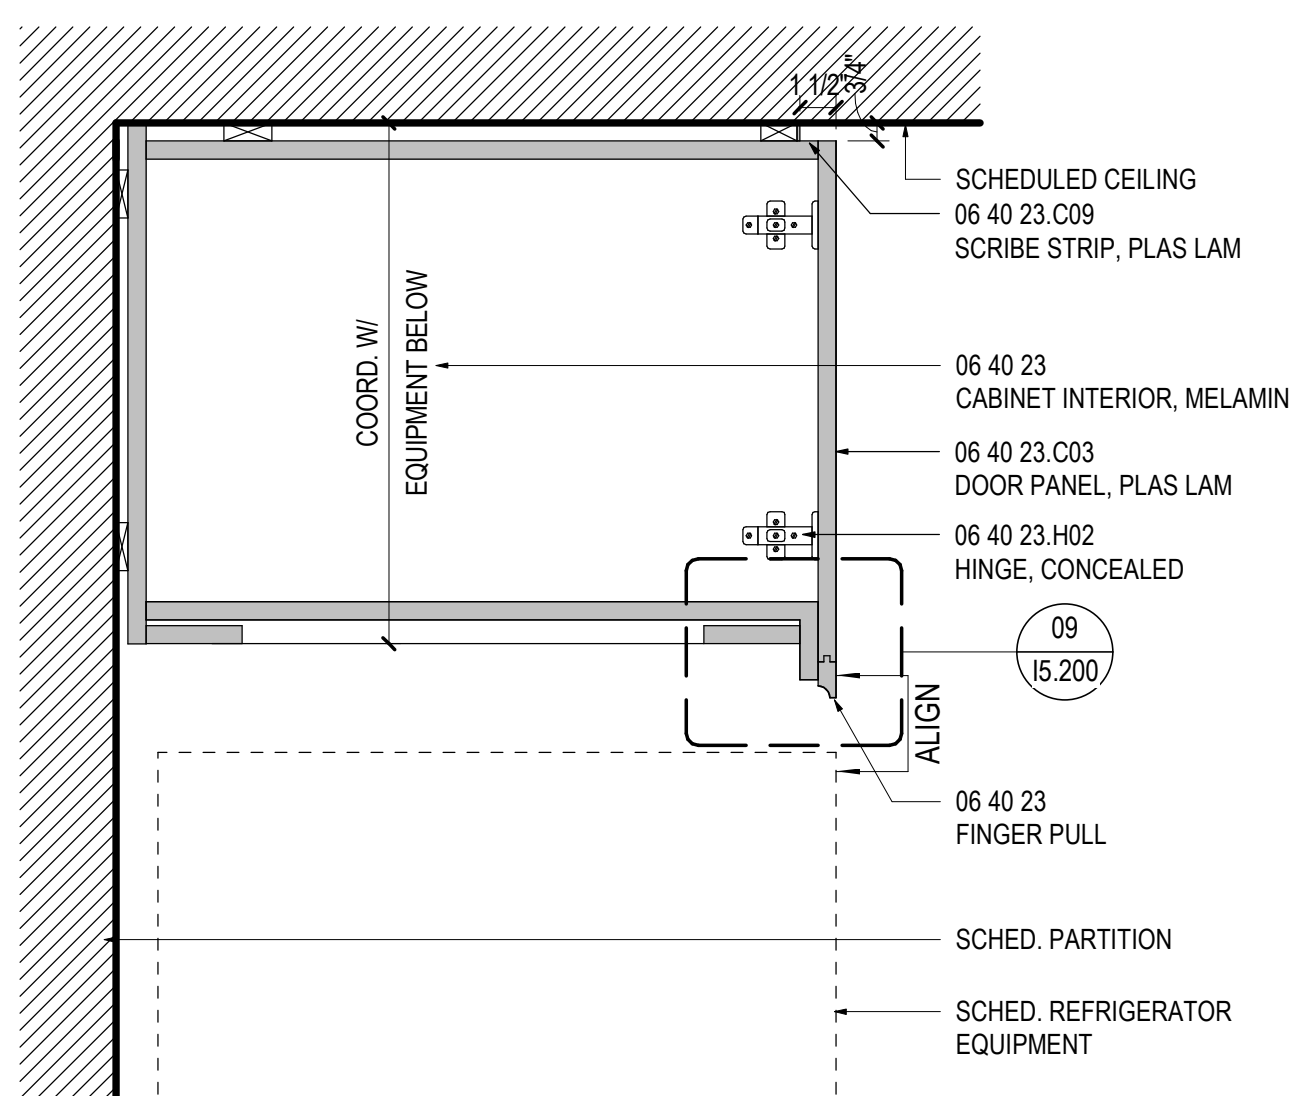


**05** UPPER CABINET ABOVE REFRIGERATOR  
SCALE: 1 1/2" = 1'-0"

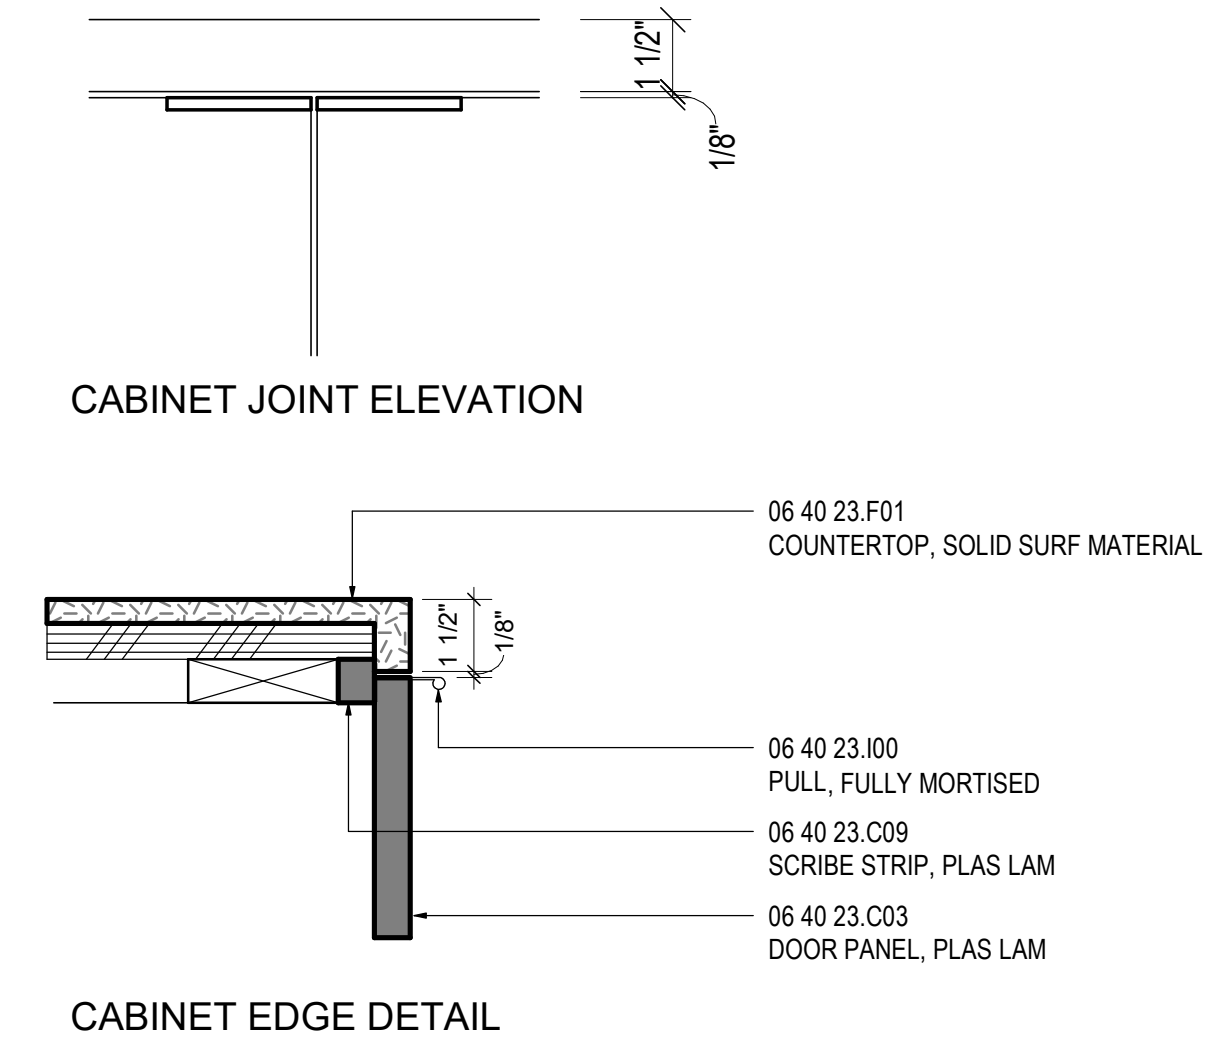


**01** CABINET EDGE DETAIL  
SCALE: 3" = 1'-0"

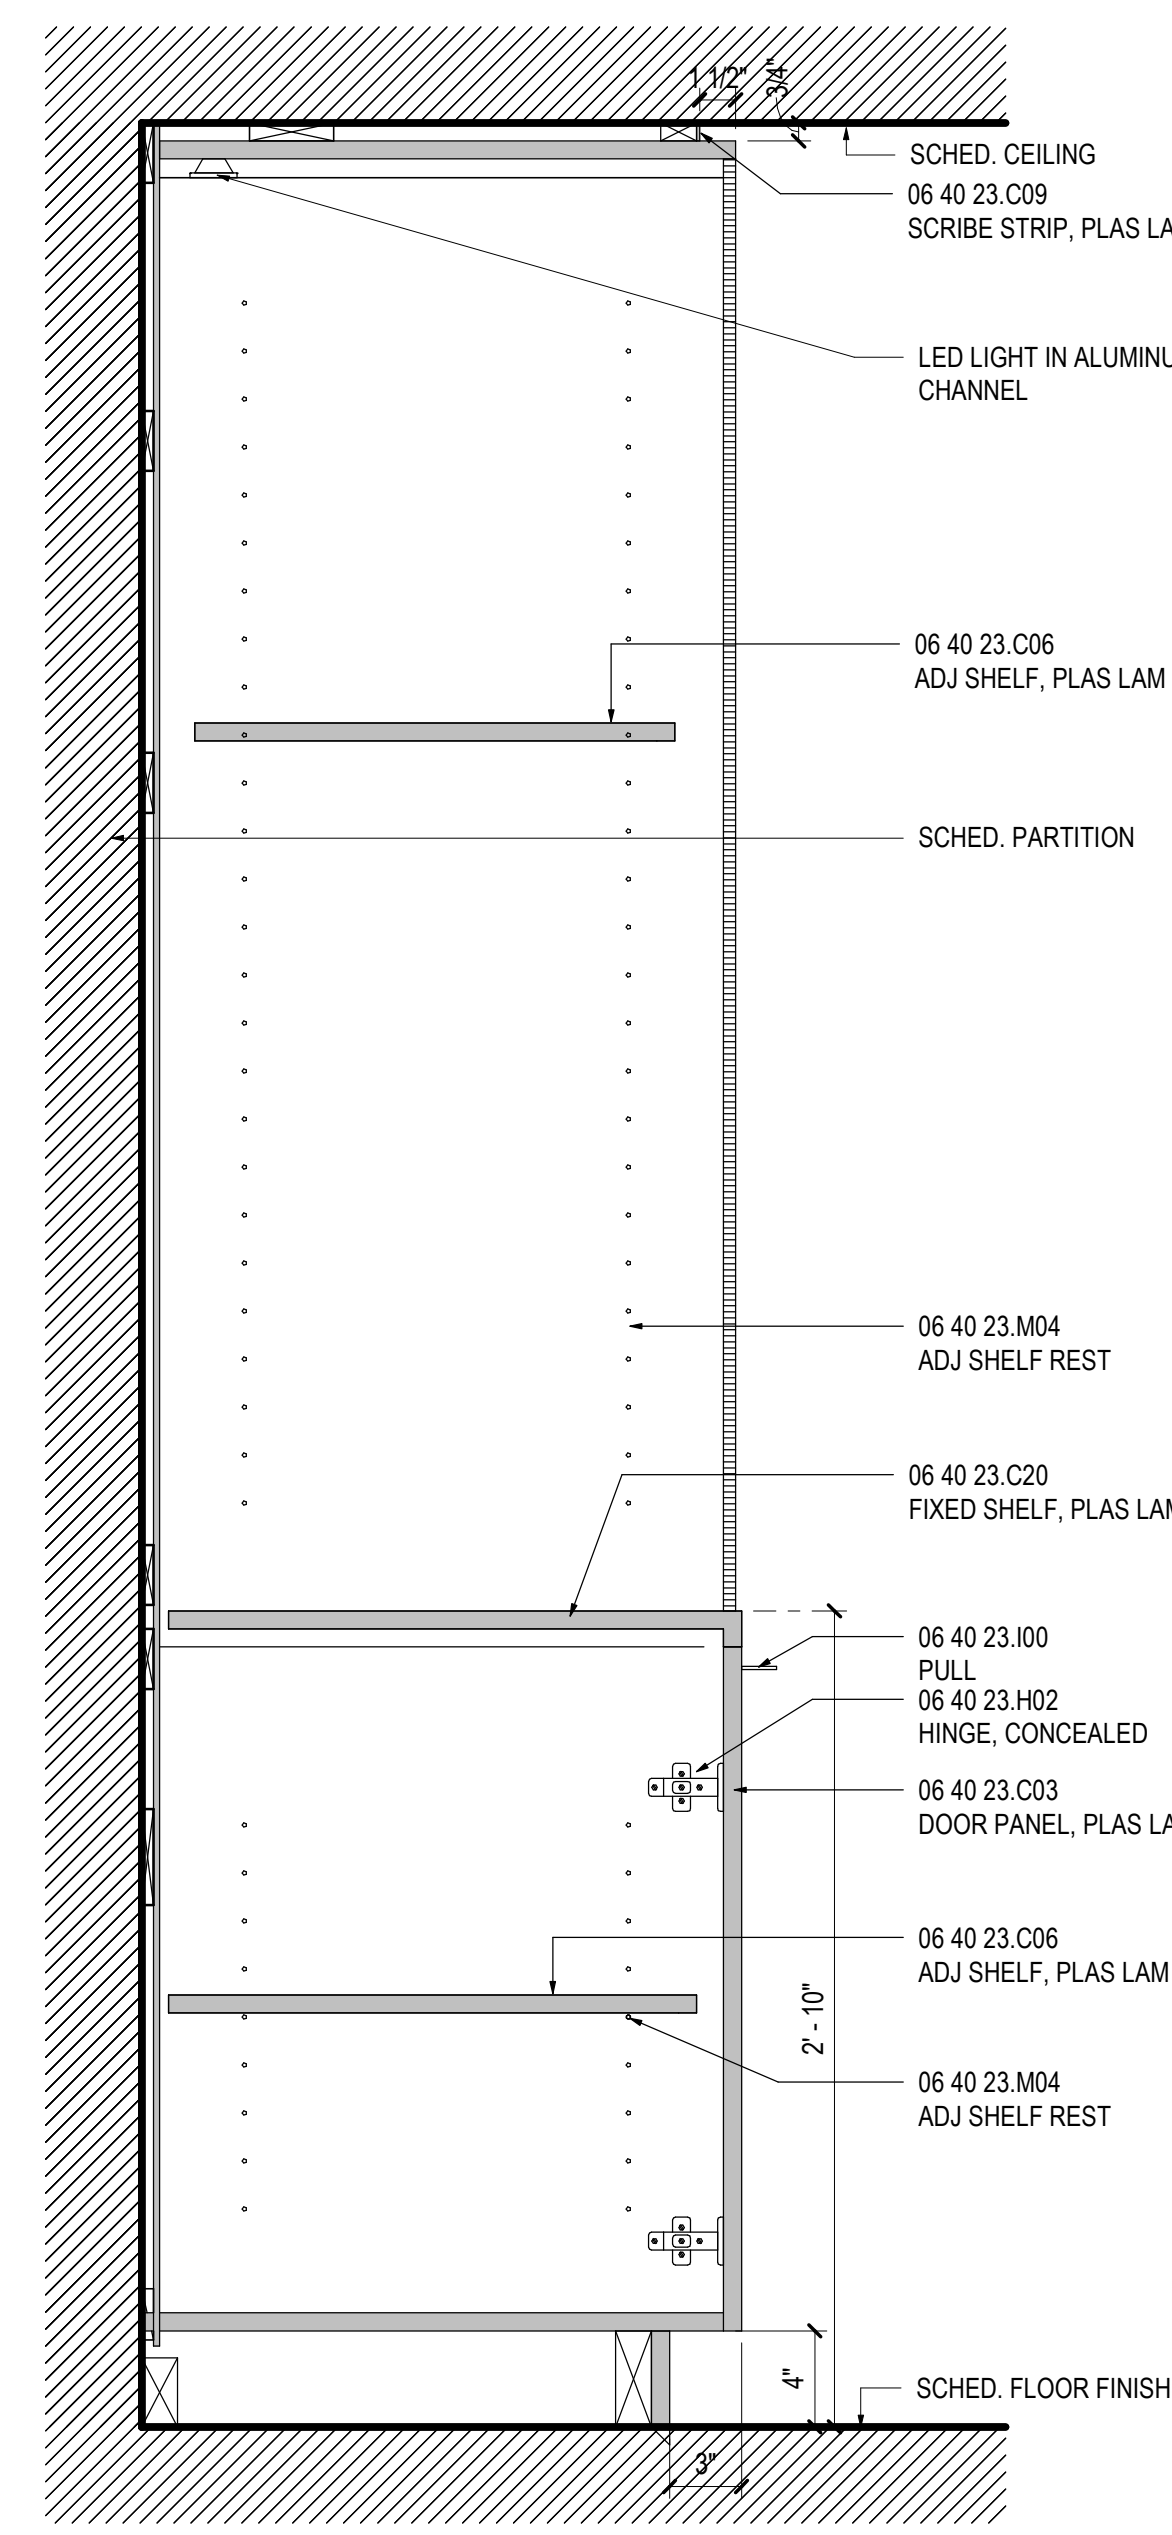


**15** DETAIL SECTION @ TROPHY DISPLAY  
SCALE: 1 1/2" = 1'-0"

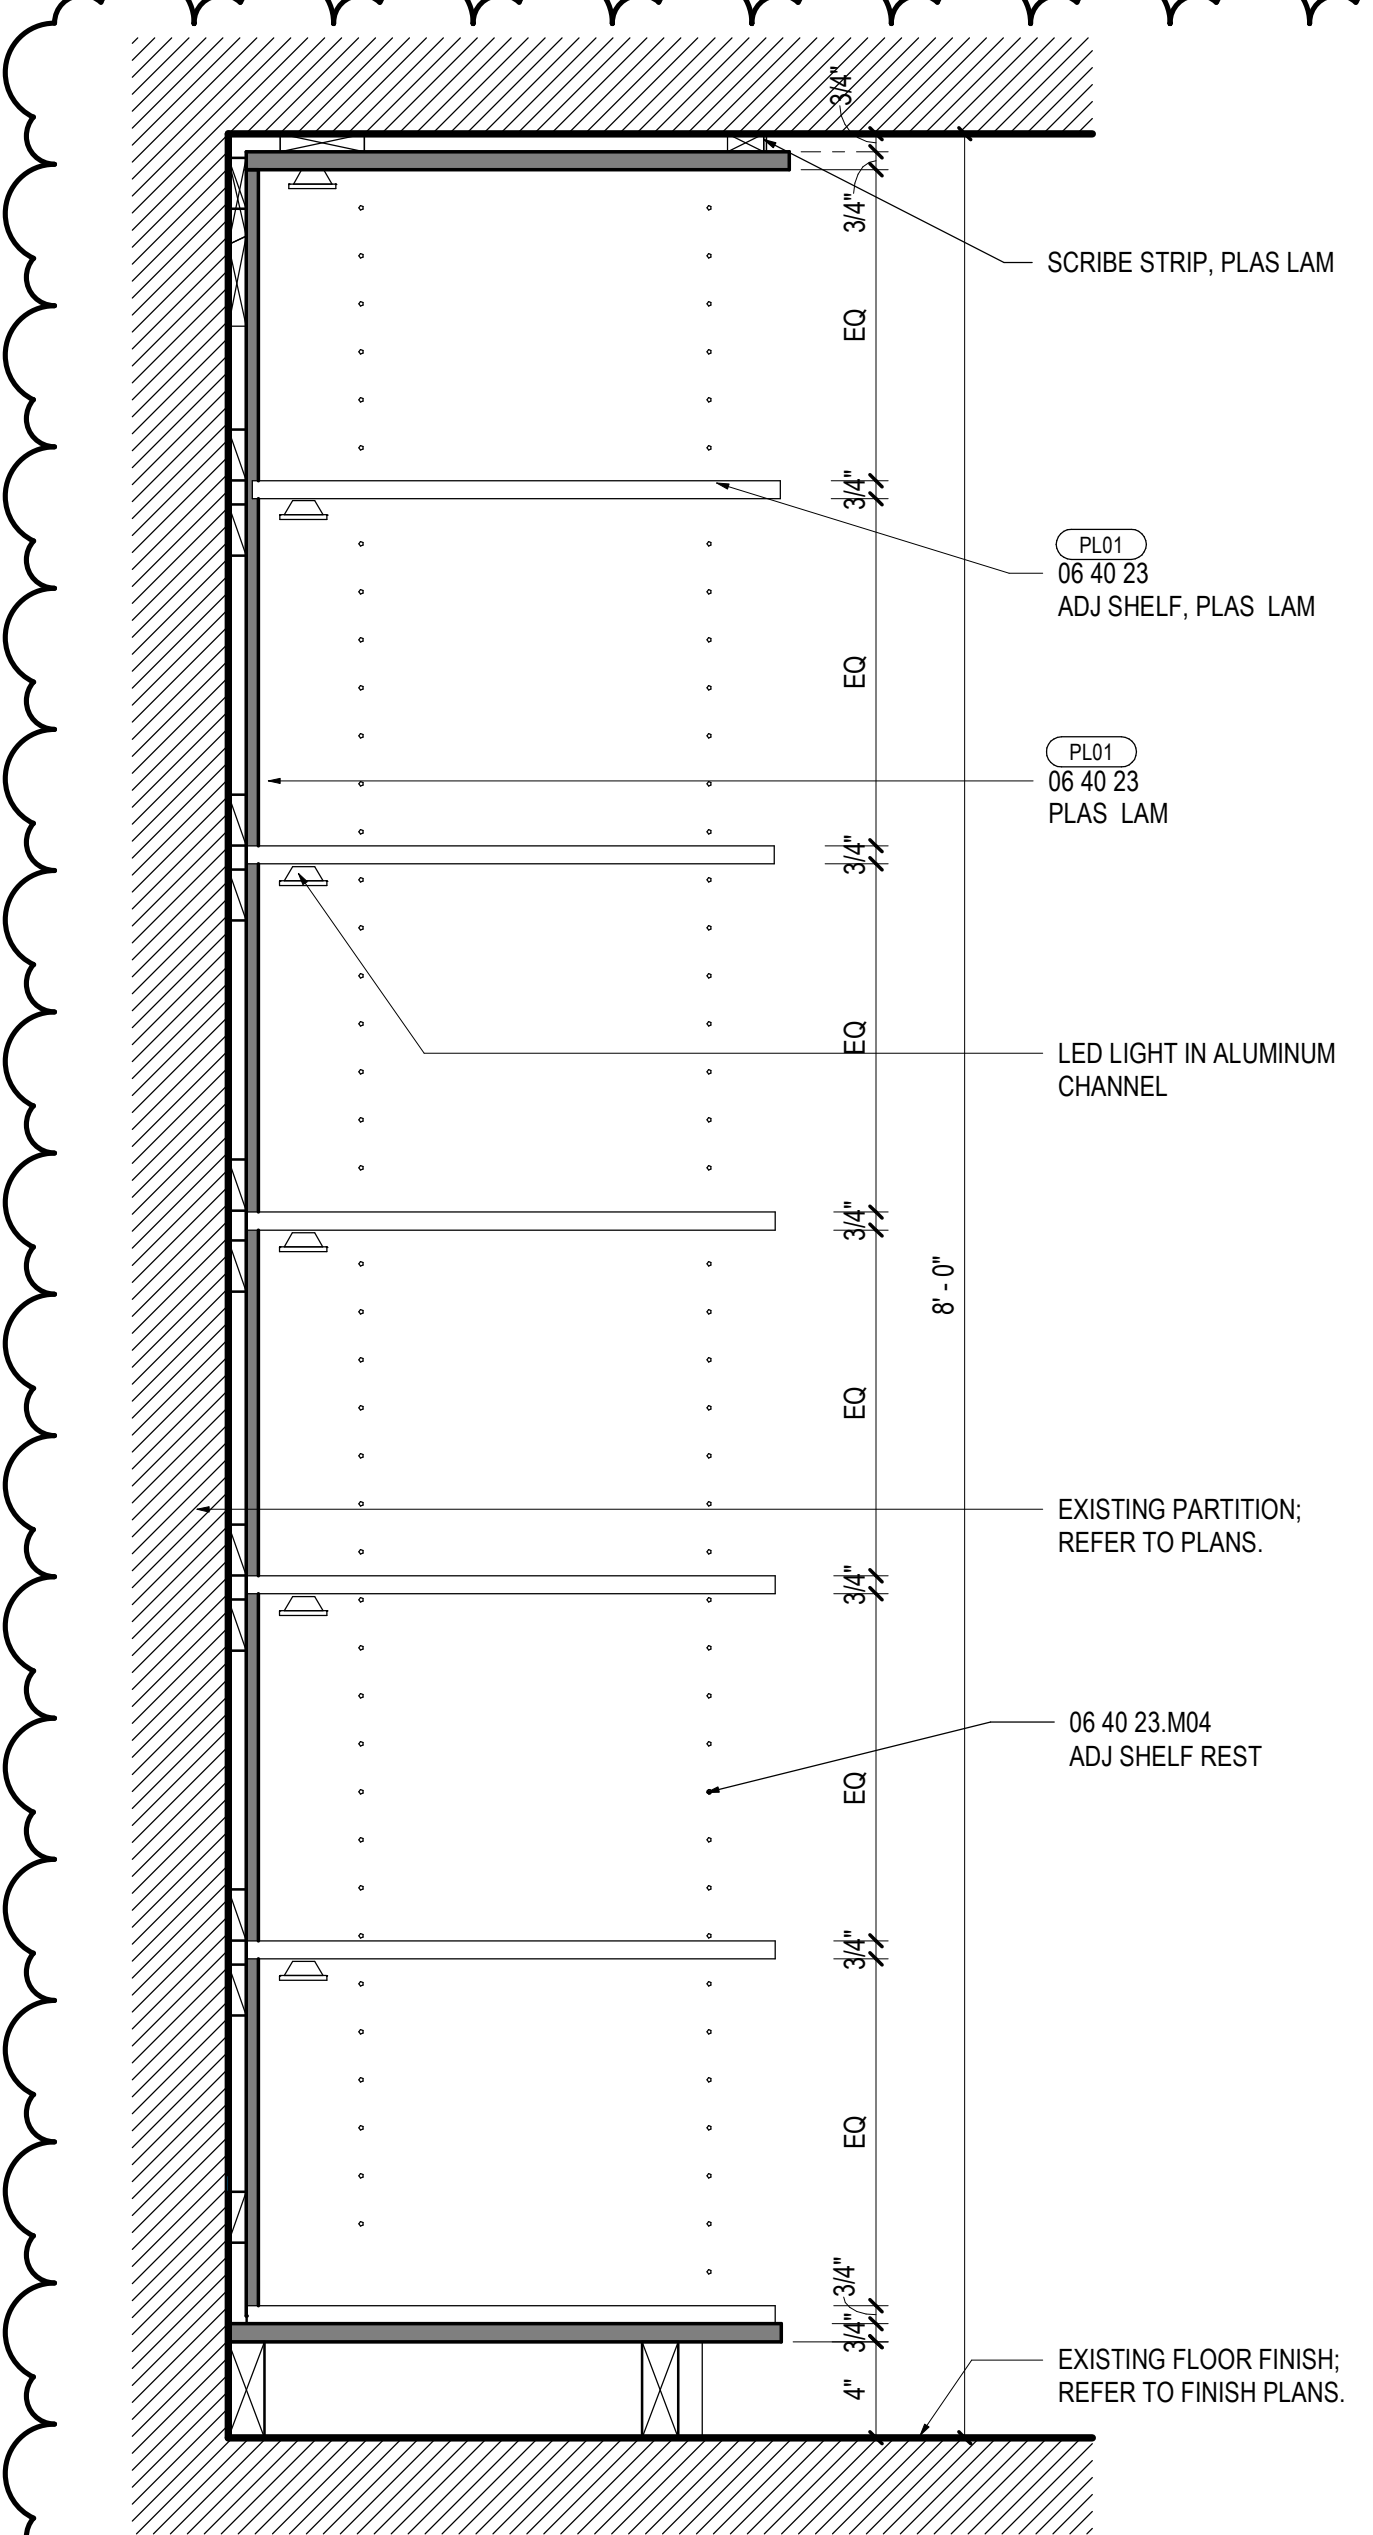


**11** DETAIL SECTION @ CLOTHING DISPLAY  
SCALE: 1 1/2" = 1'-0"

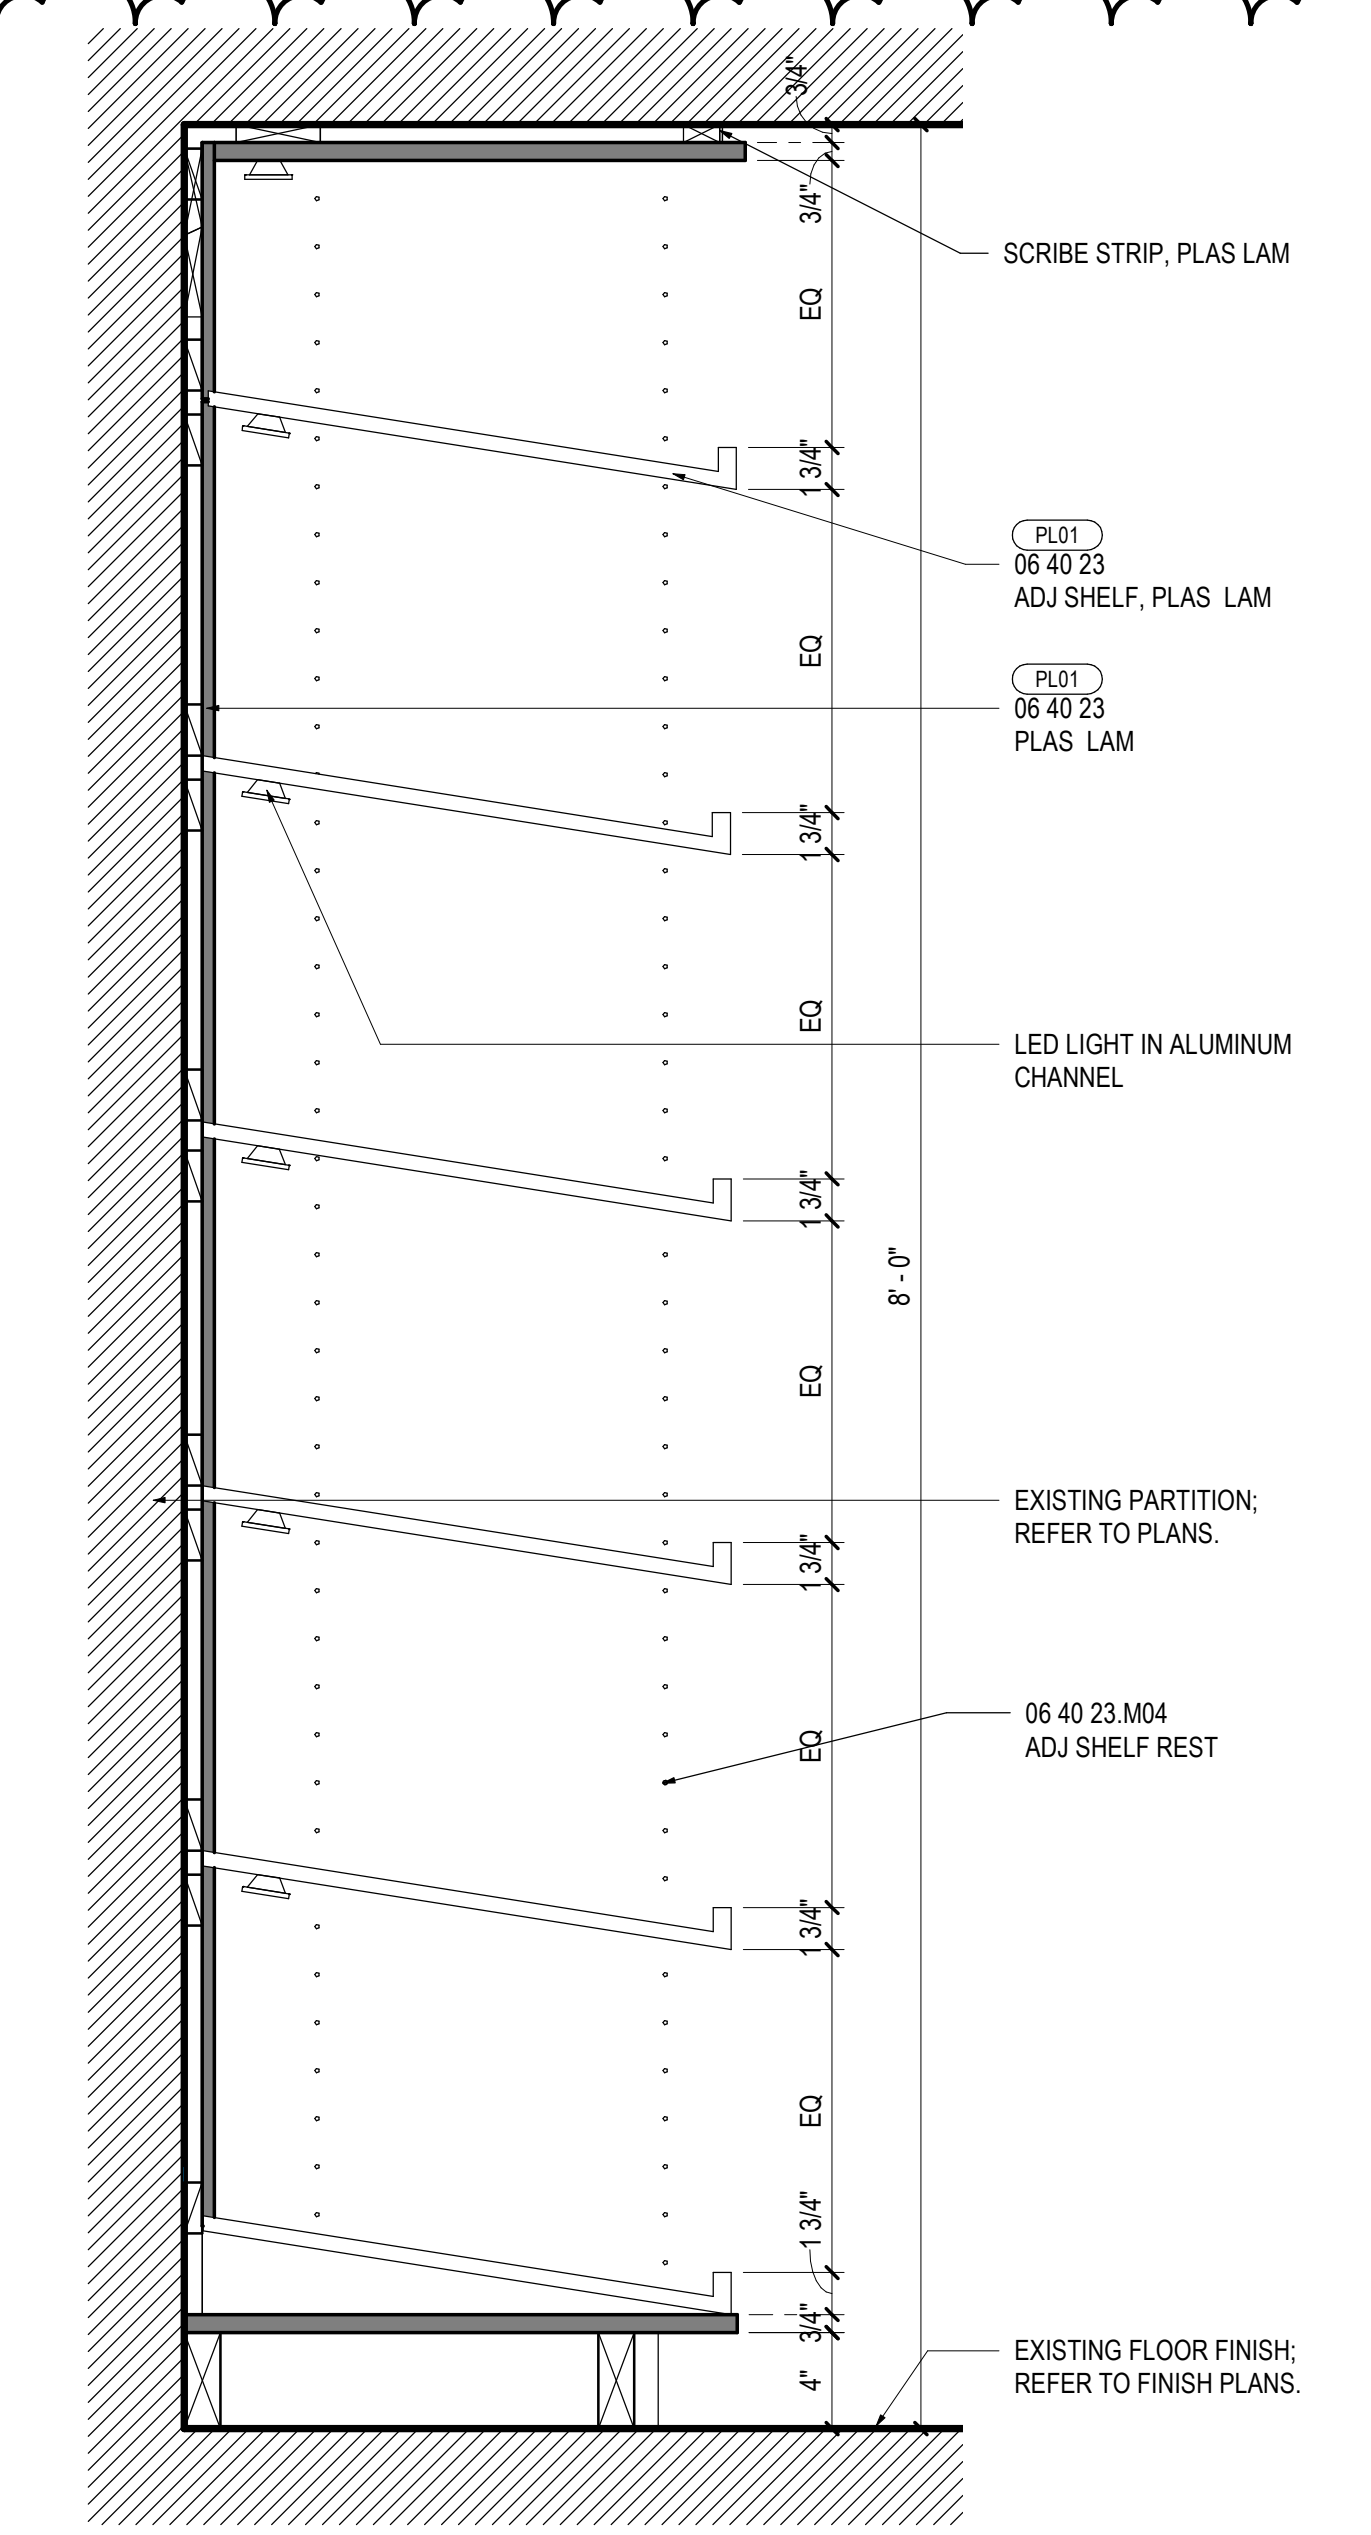


**07** DETAIL SECTION @ SHOE DISPLAY  
SCALE: 1 1/2" = 1'-0"

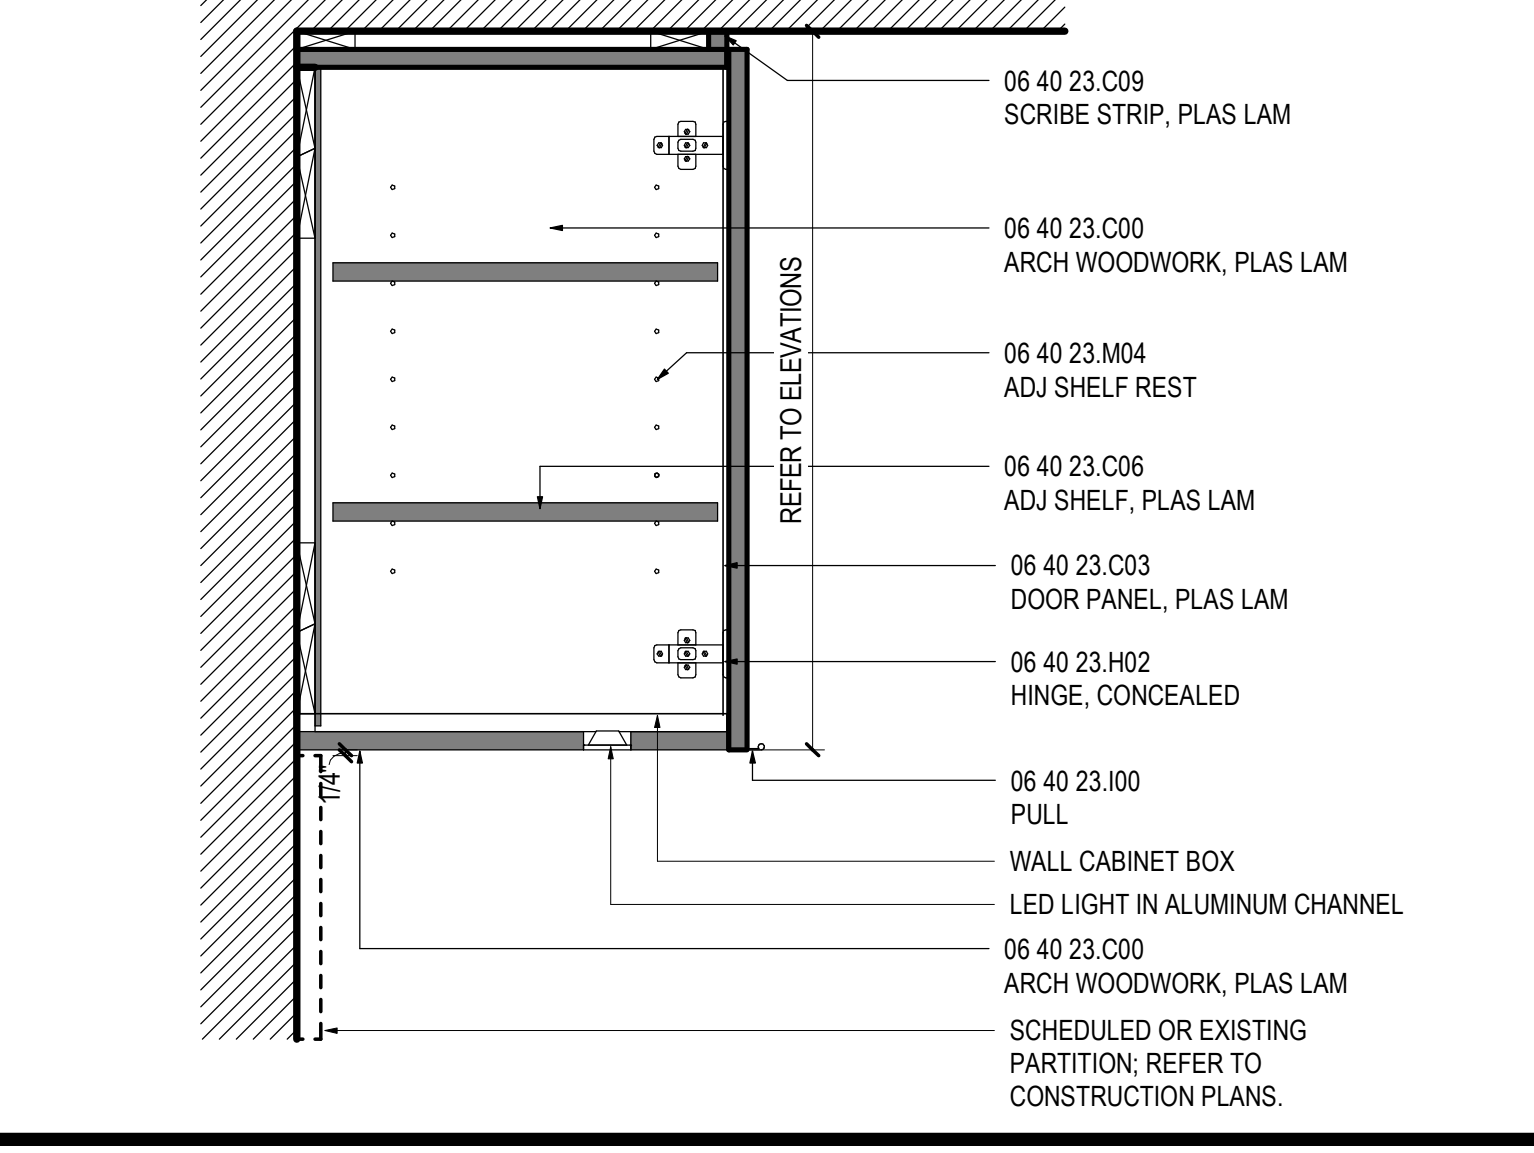


**02** OVERHEAD CABINET  
SCALE: 1 1/2" = 1'-0"

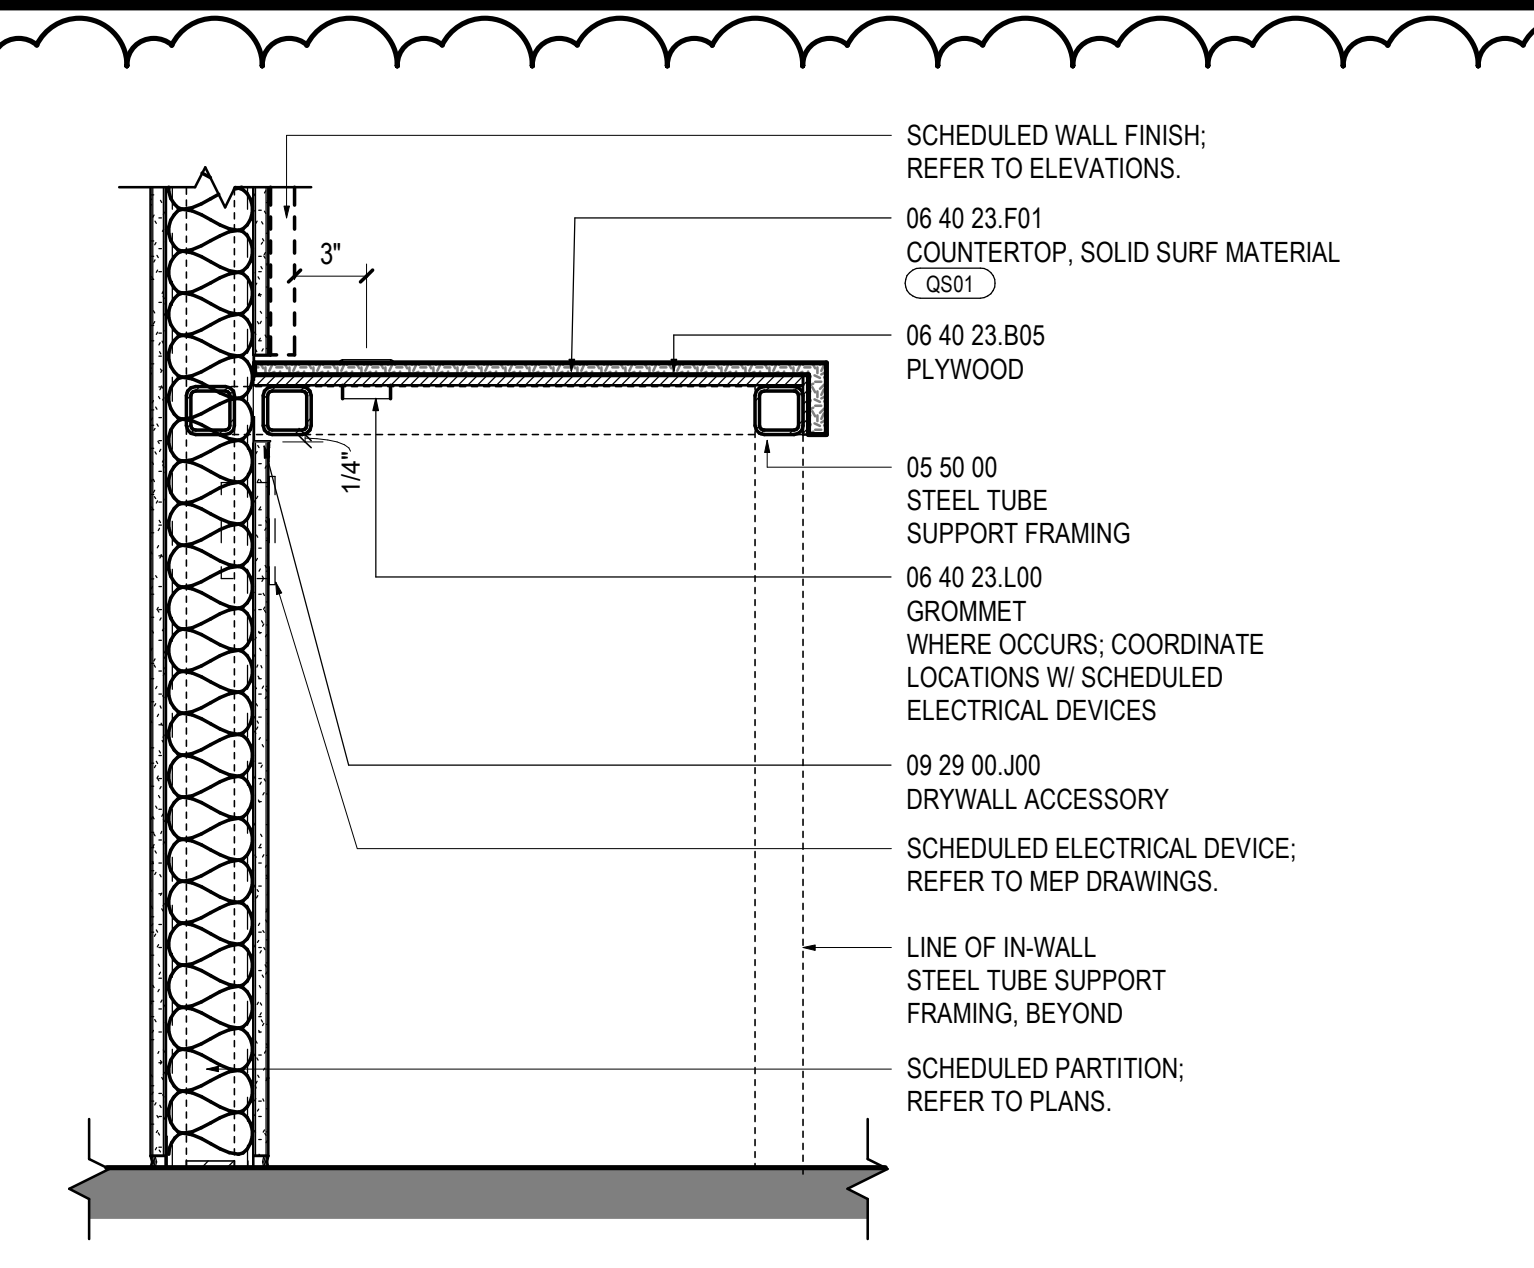


**03** SECTION @ OPEN COUNTER (PLAM)  
SCALE: 1 1/2" = 1'-0"

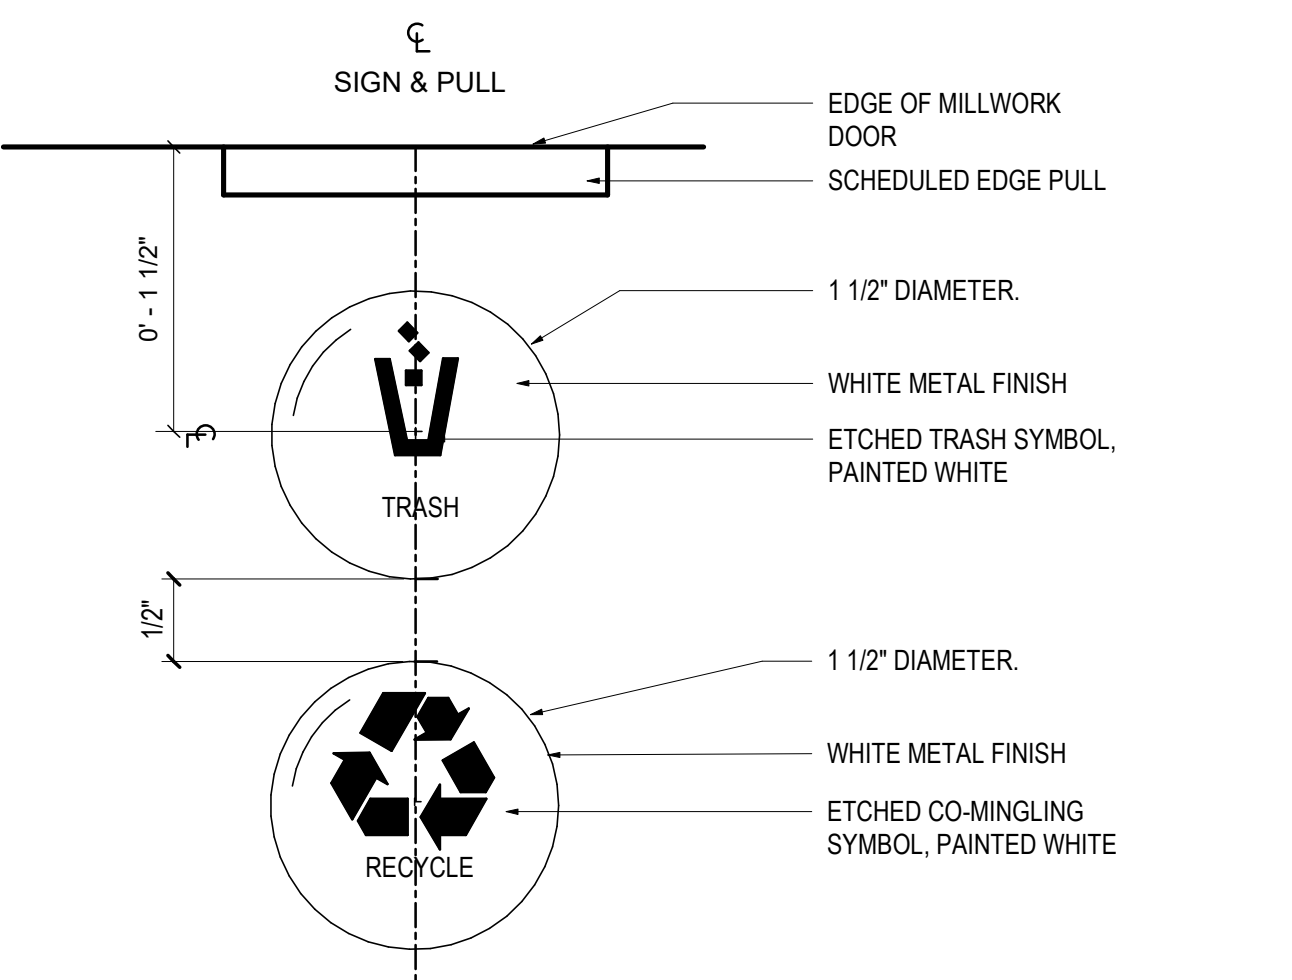


**16** BASE CABINET TRASH/ RECYCLING SIGNAGE  
SCALE: 12" = 1'-0"

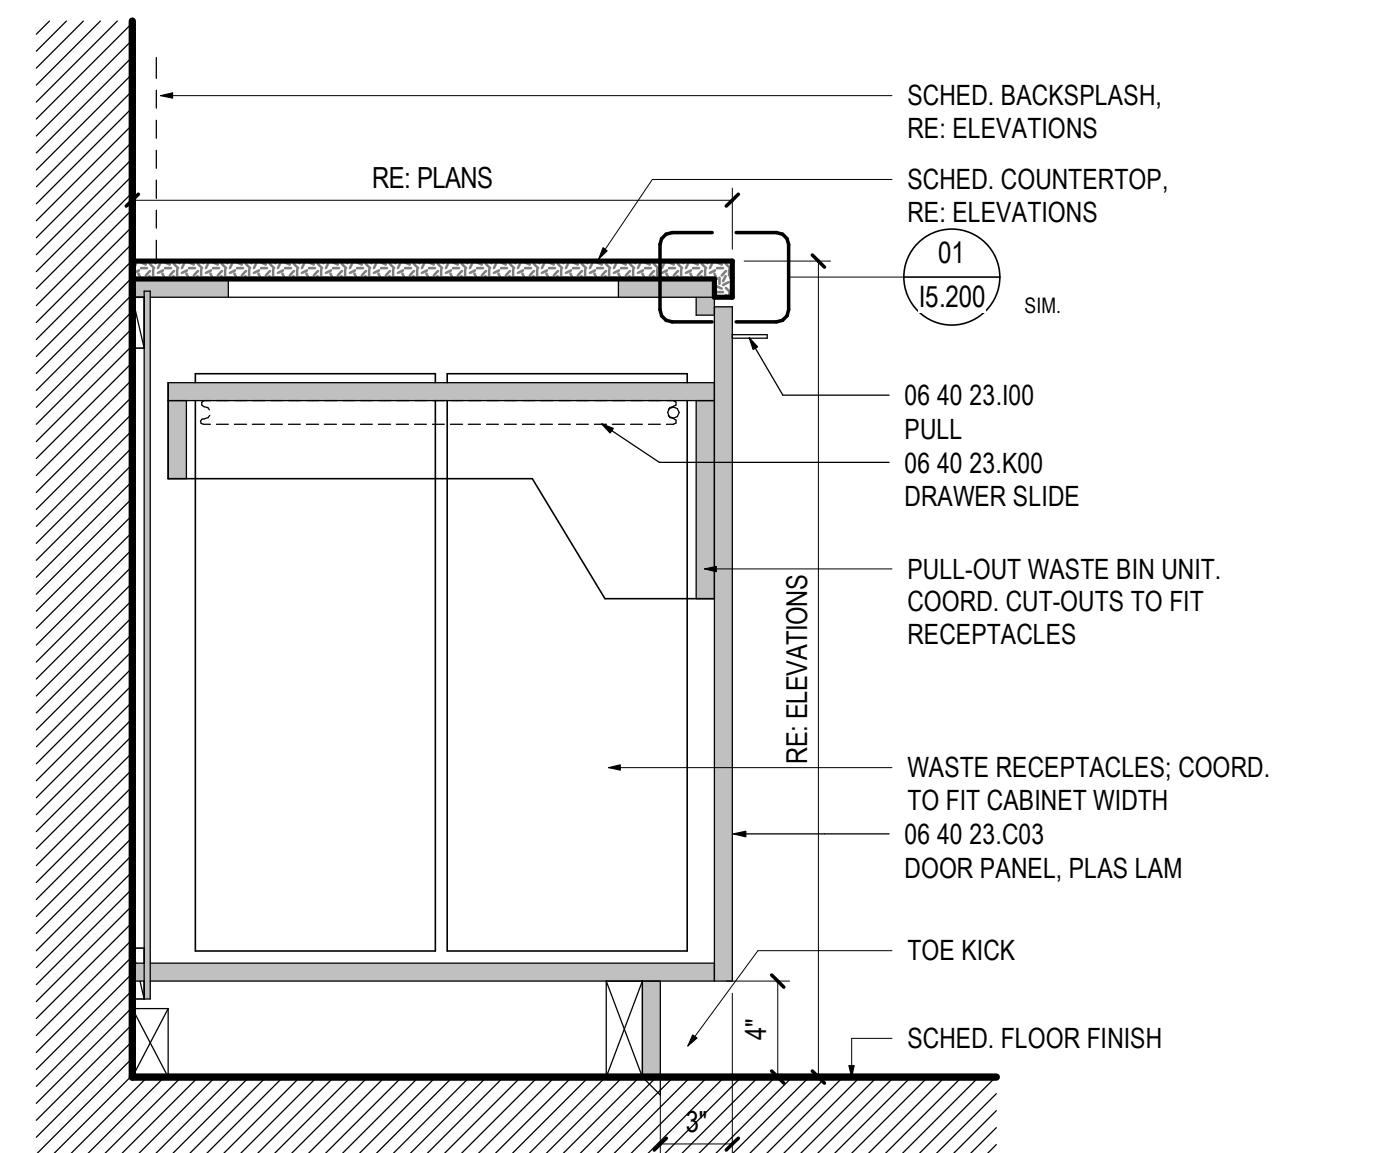

**12** BASE CABINET TRASH DRAWER  
SCALE: 1 1/2" = 1'-0"

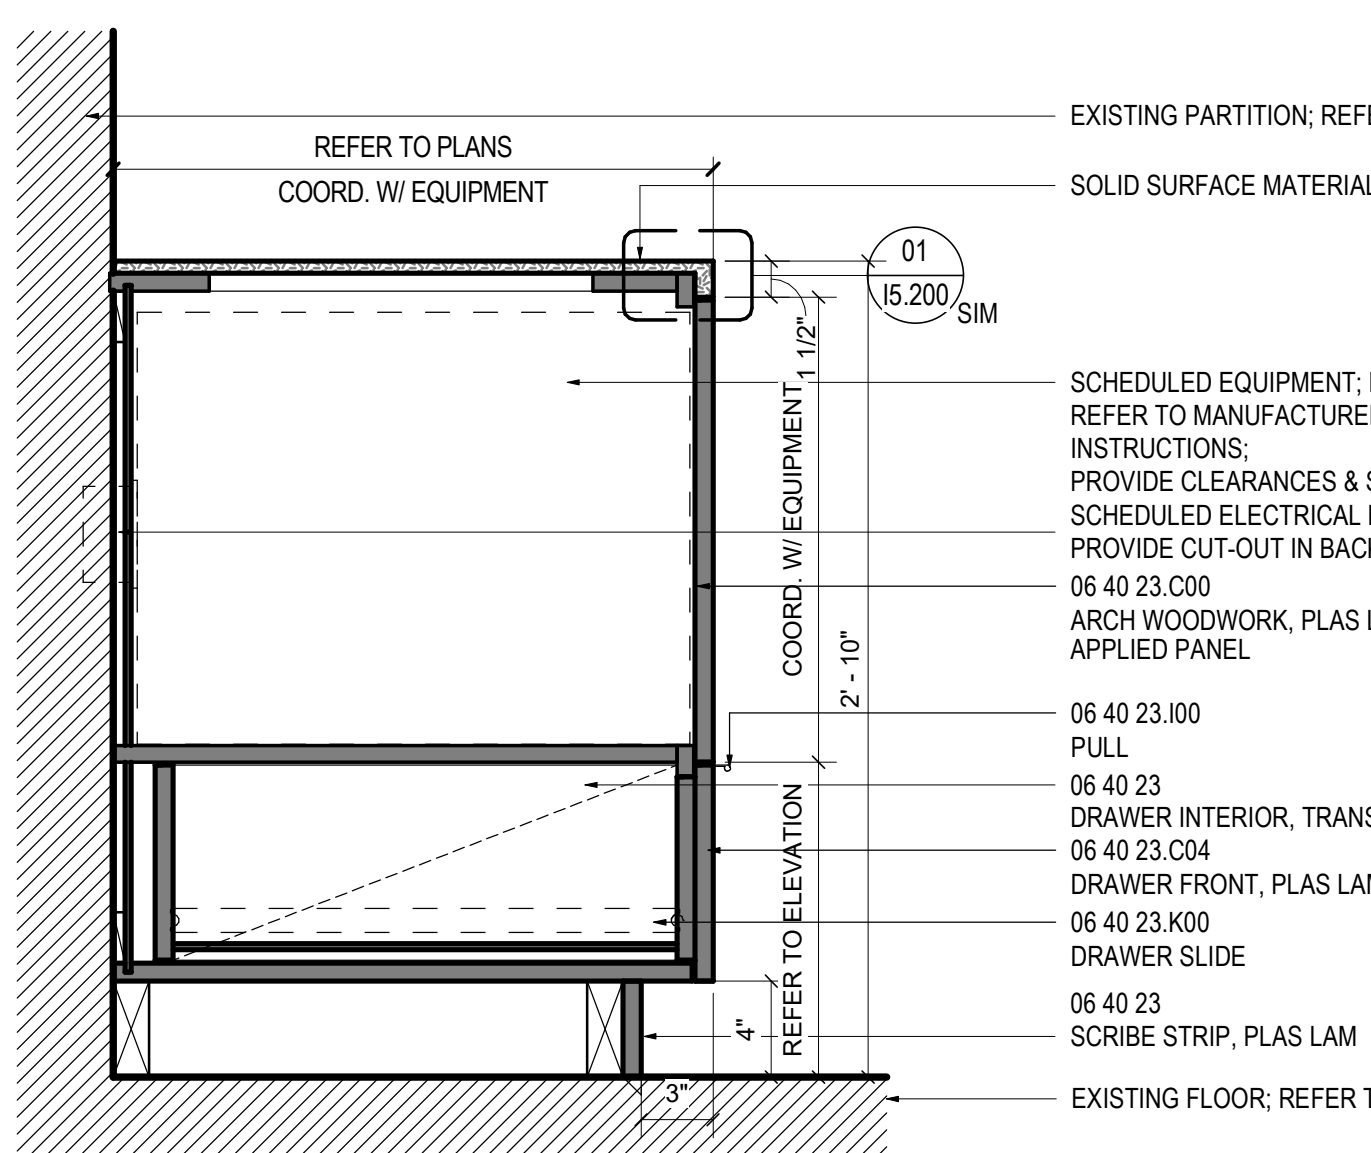

**08** BASE CABINET WITH DRAWER AND MICROWAVE  
SCALE: 1 1/2" = 1'-0"

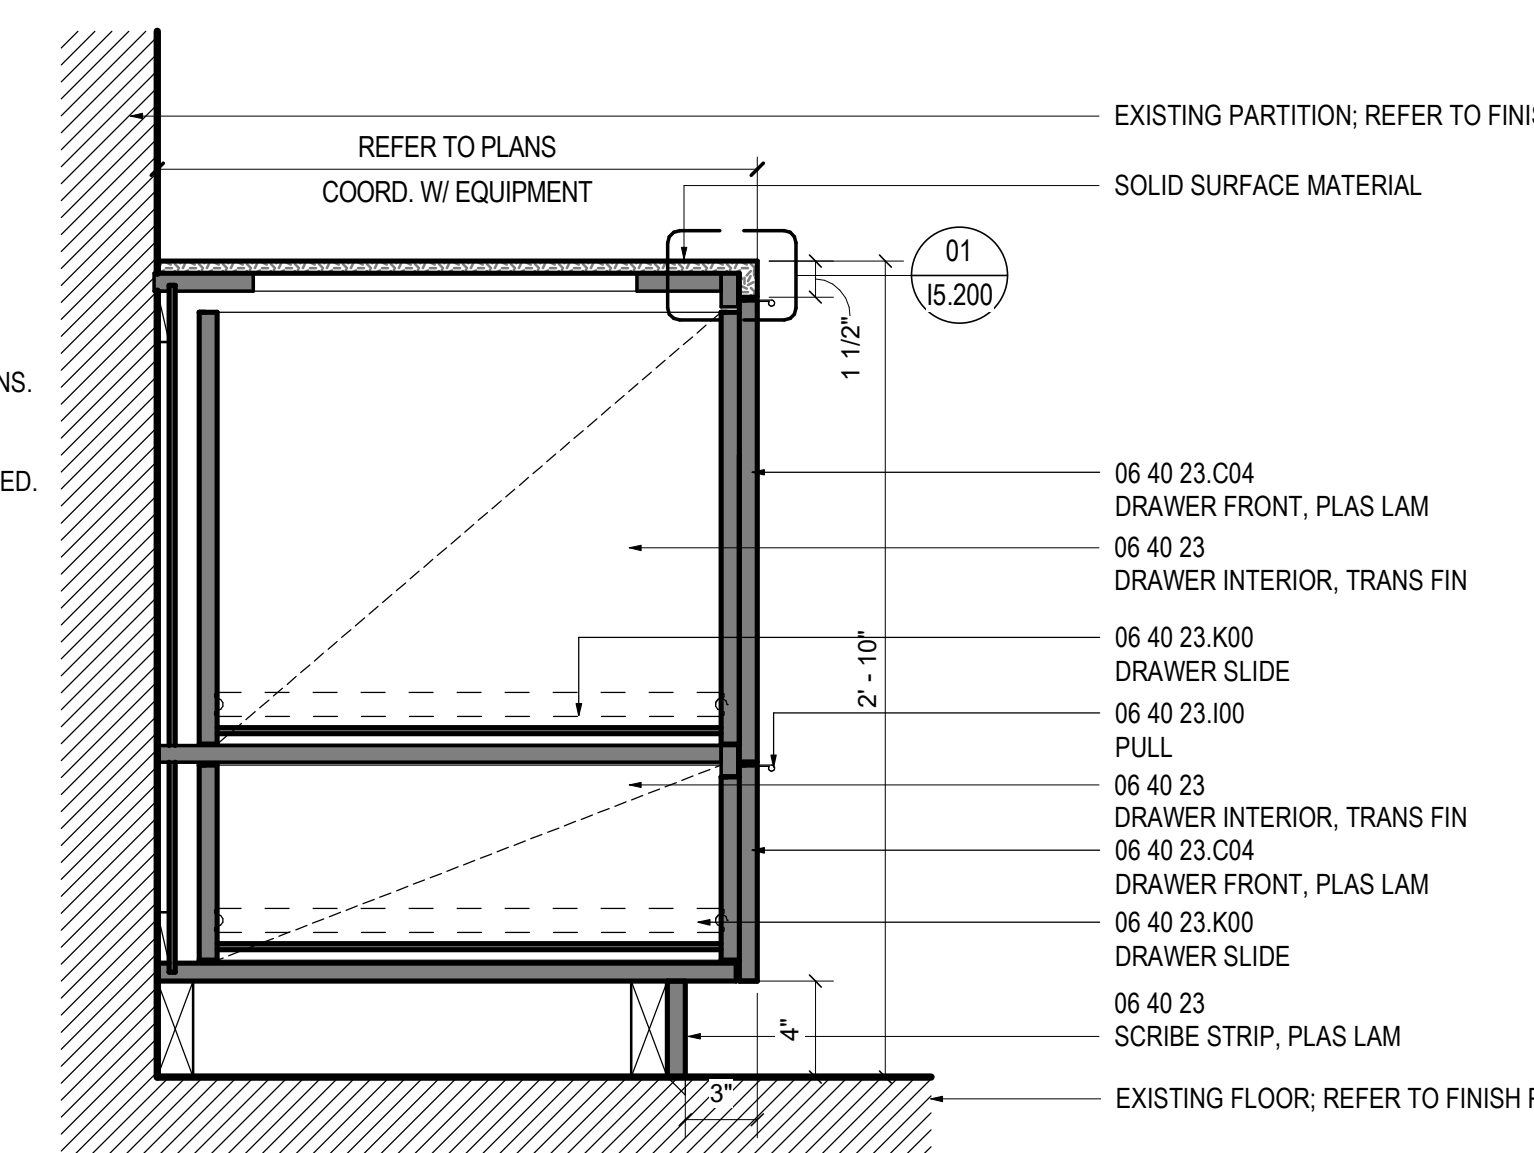

**04** BASE CABINET WITH DRAWERS  
SCALE: 1 1/2" = 1'-0"

**SHEET NOTES**

**GENERAL NOTES**

- A. ALL BLOCKING TO BE FIRE TREATED.
- B. BASIS OF DESIGN FOR MILLWORK PULLS TO BE "EVERYONE" MILLWORK PULLS MANUFACTURED BY P&R; FINISH: SATIN STAINLESS STEEL.
- C. TRASHBINS TO BE THE FOLLOWING COLORS: TRASH- BLACK/GREY - RECYCLING: BLUE - COMPOST: GREEN.

Date	Description
1 03/26/2021	DESIGN DEVELOPMENT - ISSUE FOR PRICING
2 04/19/2021	ISSUE FOR PERMIT
3 06/11/2021	ISSUE FOR PERMIT - RESUBMIT
4 10/18/2021	ISSUE FOR BID
6 11/30/2021	ADDENDUM 02

Seal / Signature

Project Name  
**RAMSEY - BASKETBALL LOCKER ROOM RENOVATION**

Project Number  
**009.9478.000**

Description  
**MILLWORK DETAILS**

Scale  
As indicated

**15.200**



92 Catamount Road  
Cullowhee, NC 28723

**Gensler**

2020 K St NW  
Washington, DC 20006  
United States

Tel (202) 721-5200  
Fax +1 202 872 8587




MEP ENGINEERS  
1927 South Tryon Street  
Suite 300  
Charlotte, NC 28203  
Tel 704.338.1292


SCO ID: 21-22998-01  
CIP: 42029




1/30/2021 4:54:53 PM B:\300\009\9478\00 - WCU RMC Basketball SD-Childrens - 009\9478\000 - WCU Basketball\01.rvt

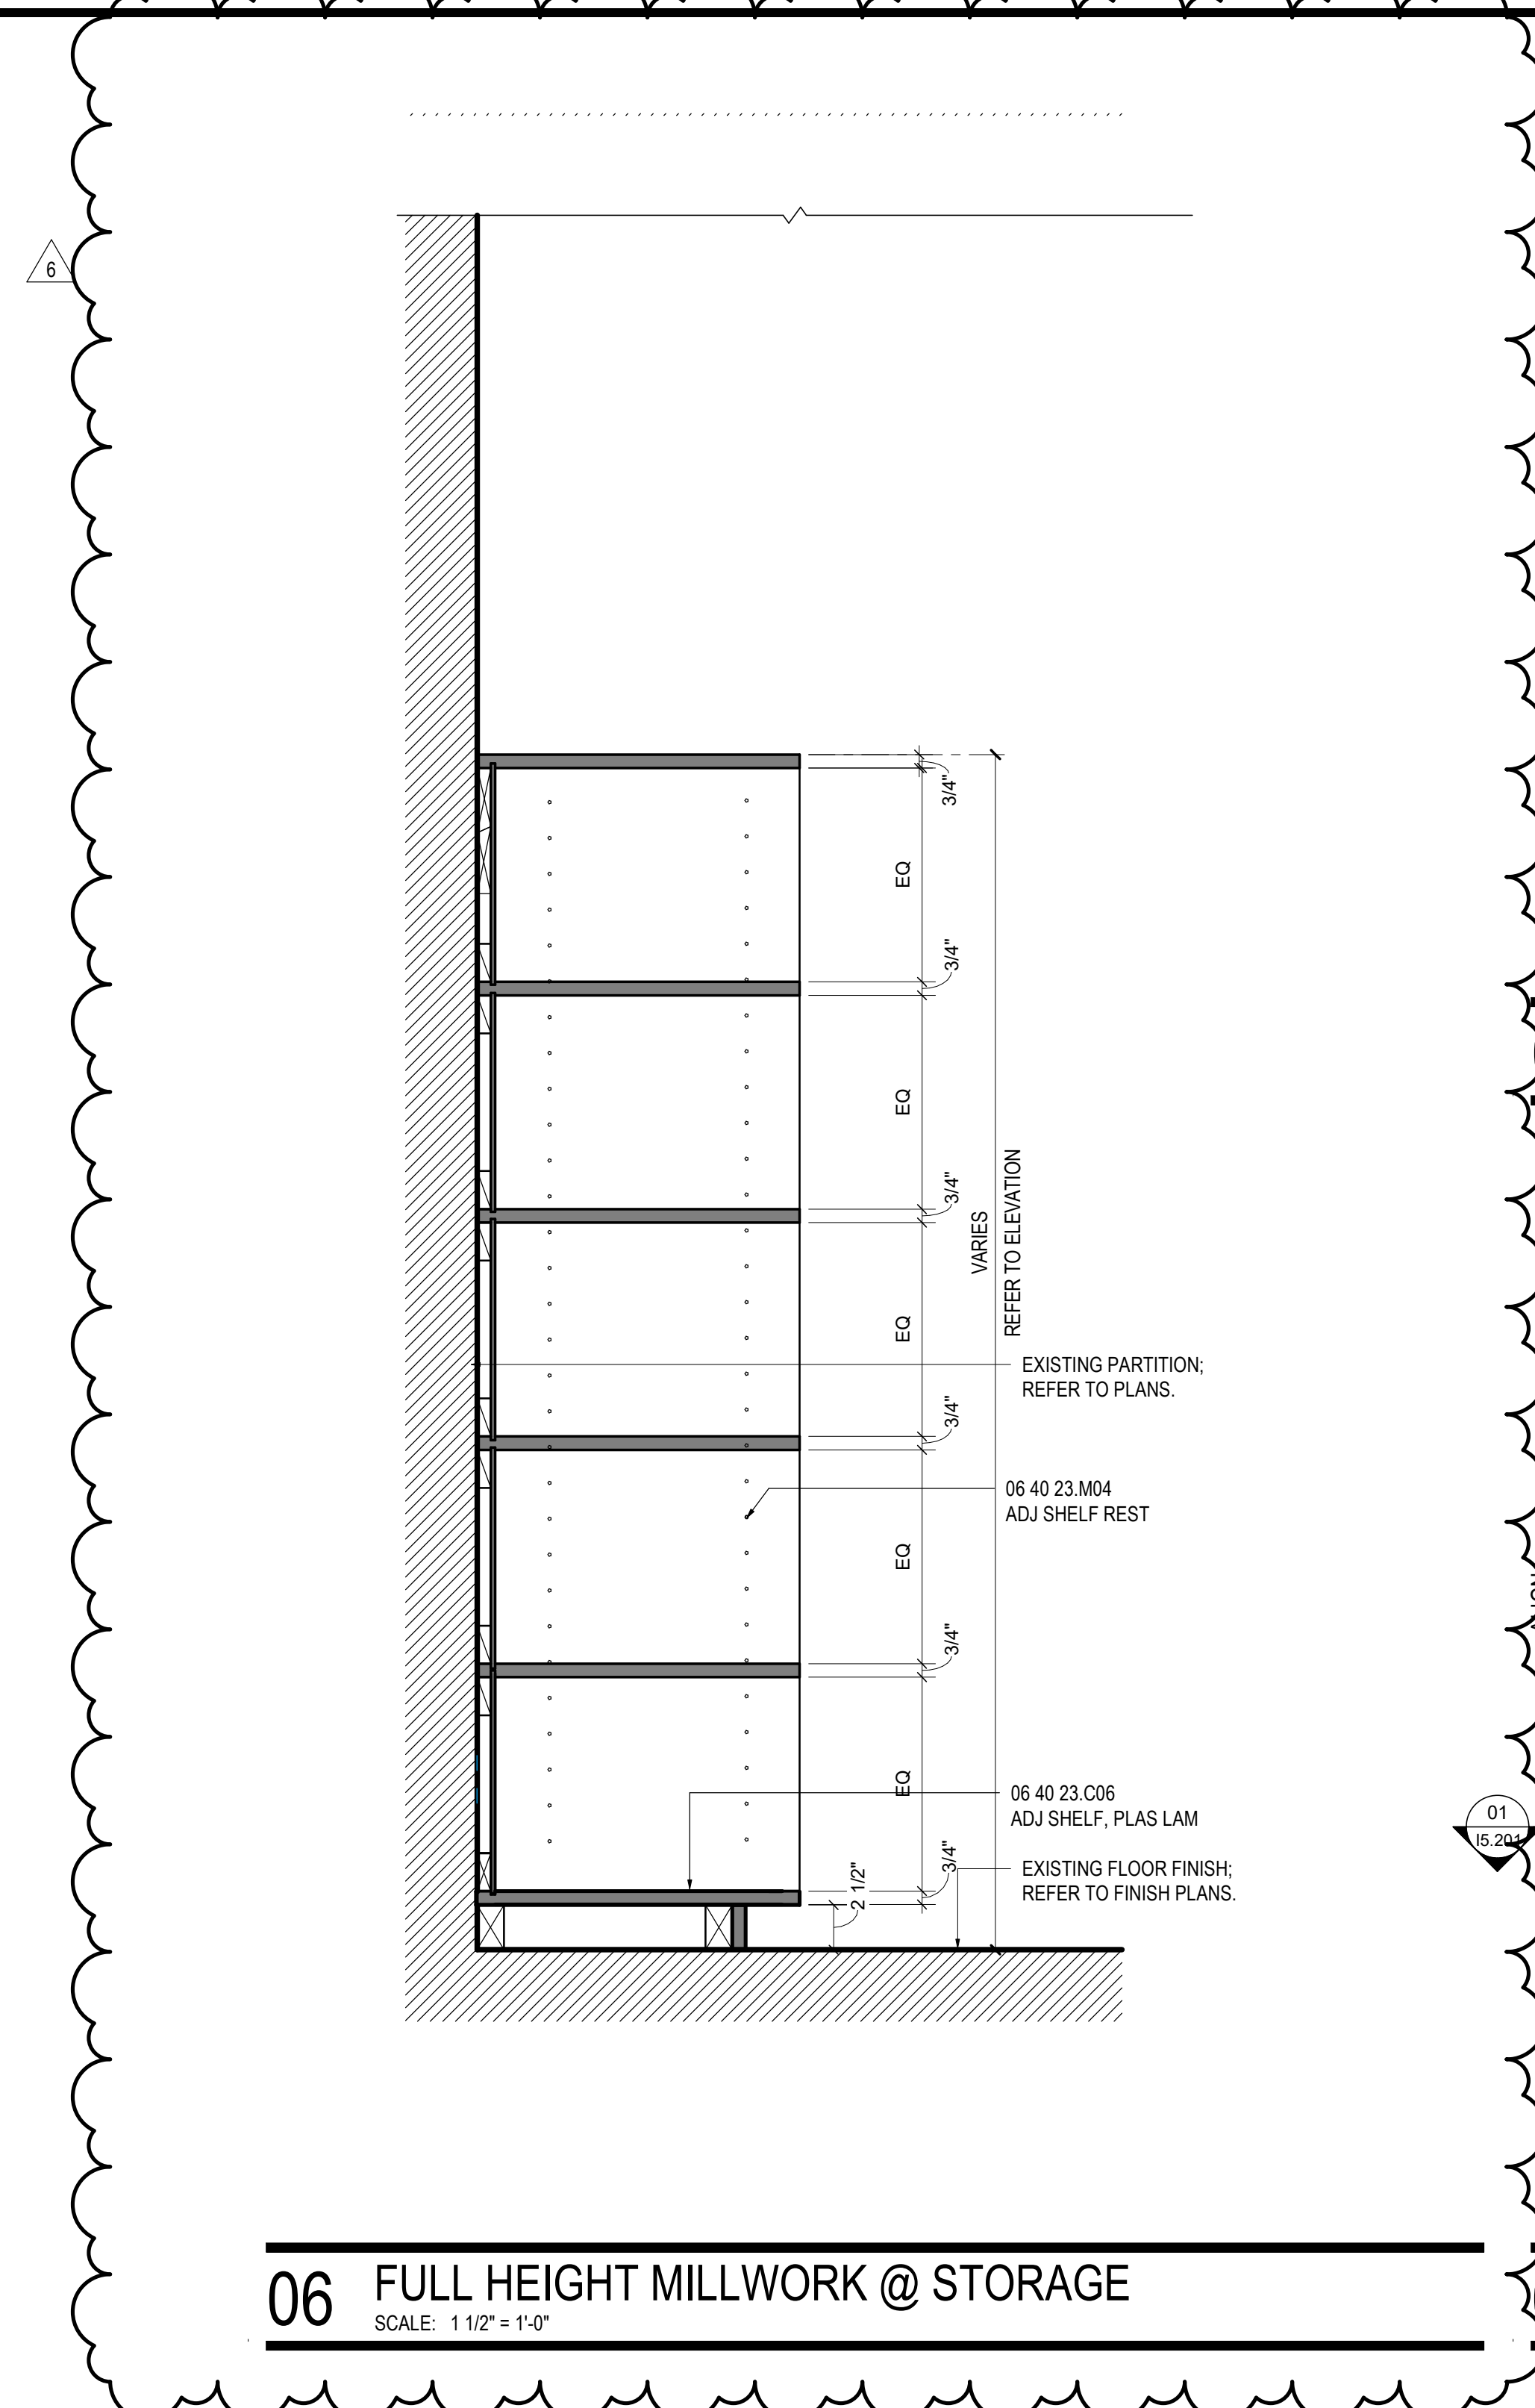

**06 FULL HEIGHT MILLWORK @ STORAGE**  
SCALE: 1 1/2" = 1'-0"

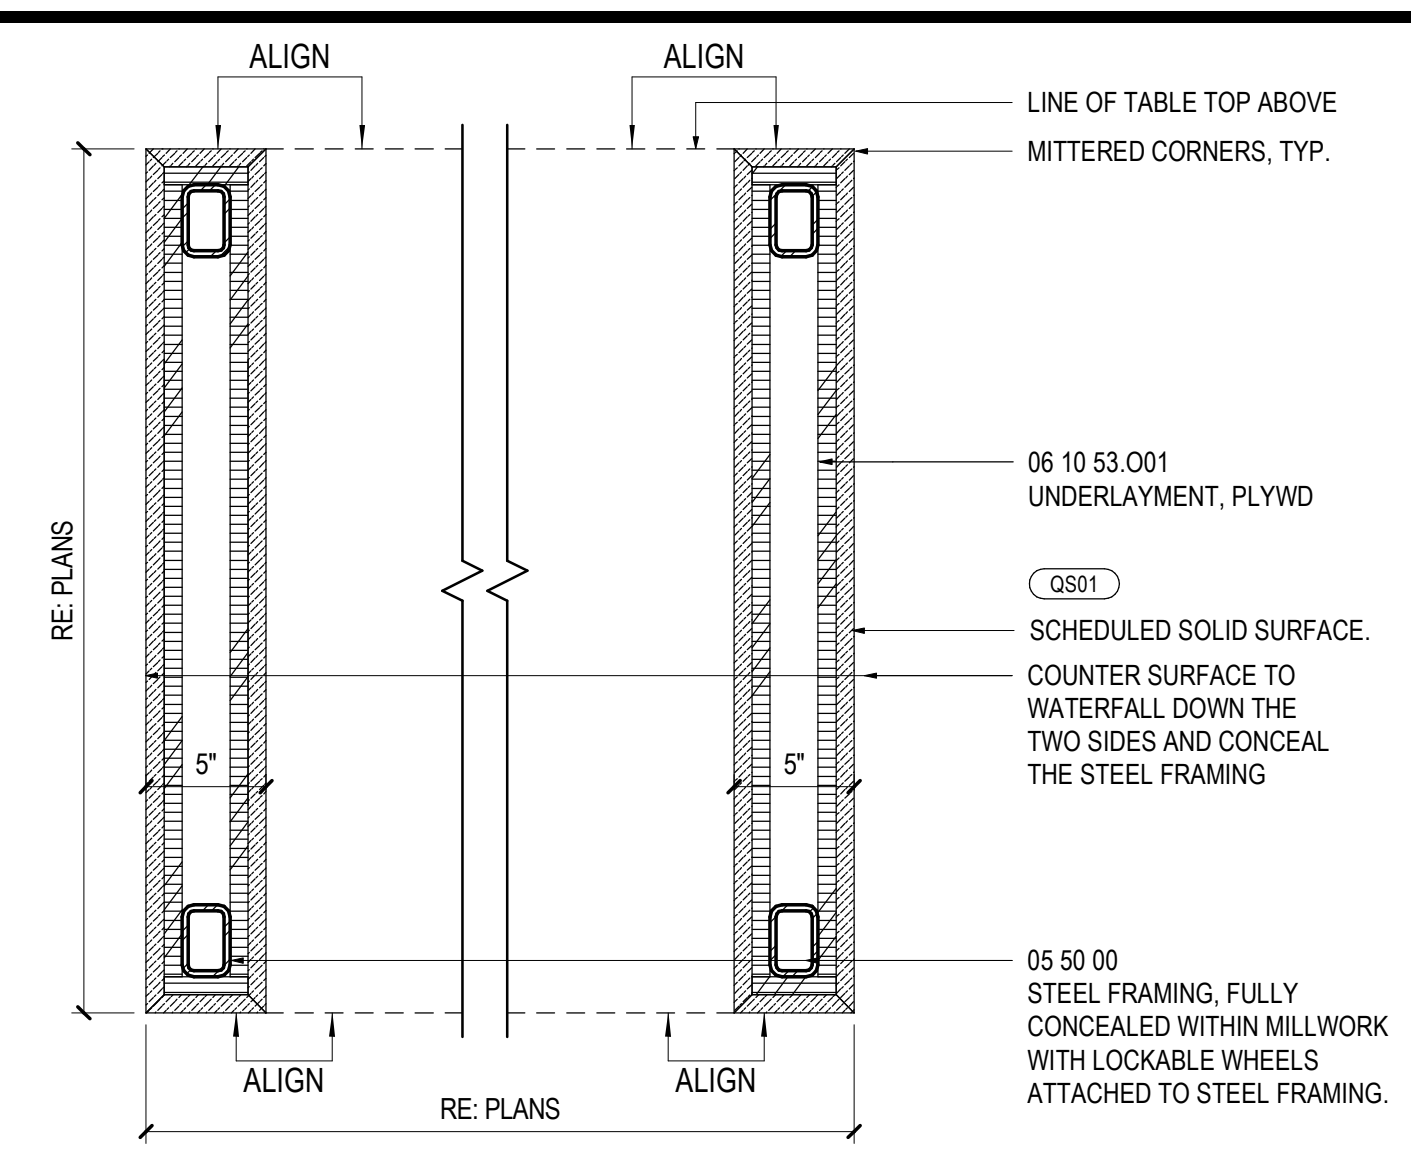

**01 MOVABLE ISLAND - PLAN VIEW**  
SCALE: 1 1/2" = 1'-0"

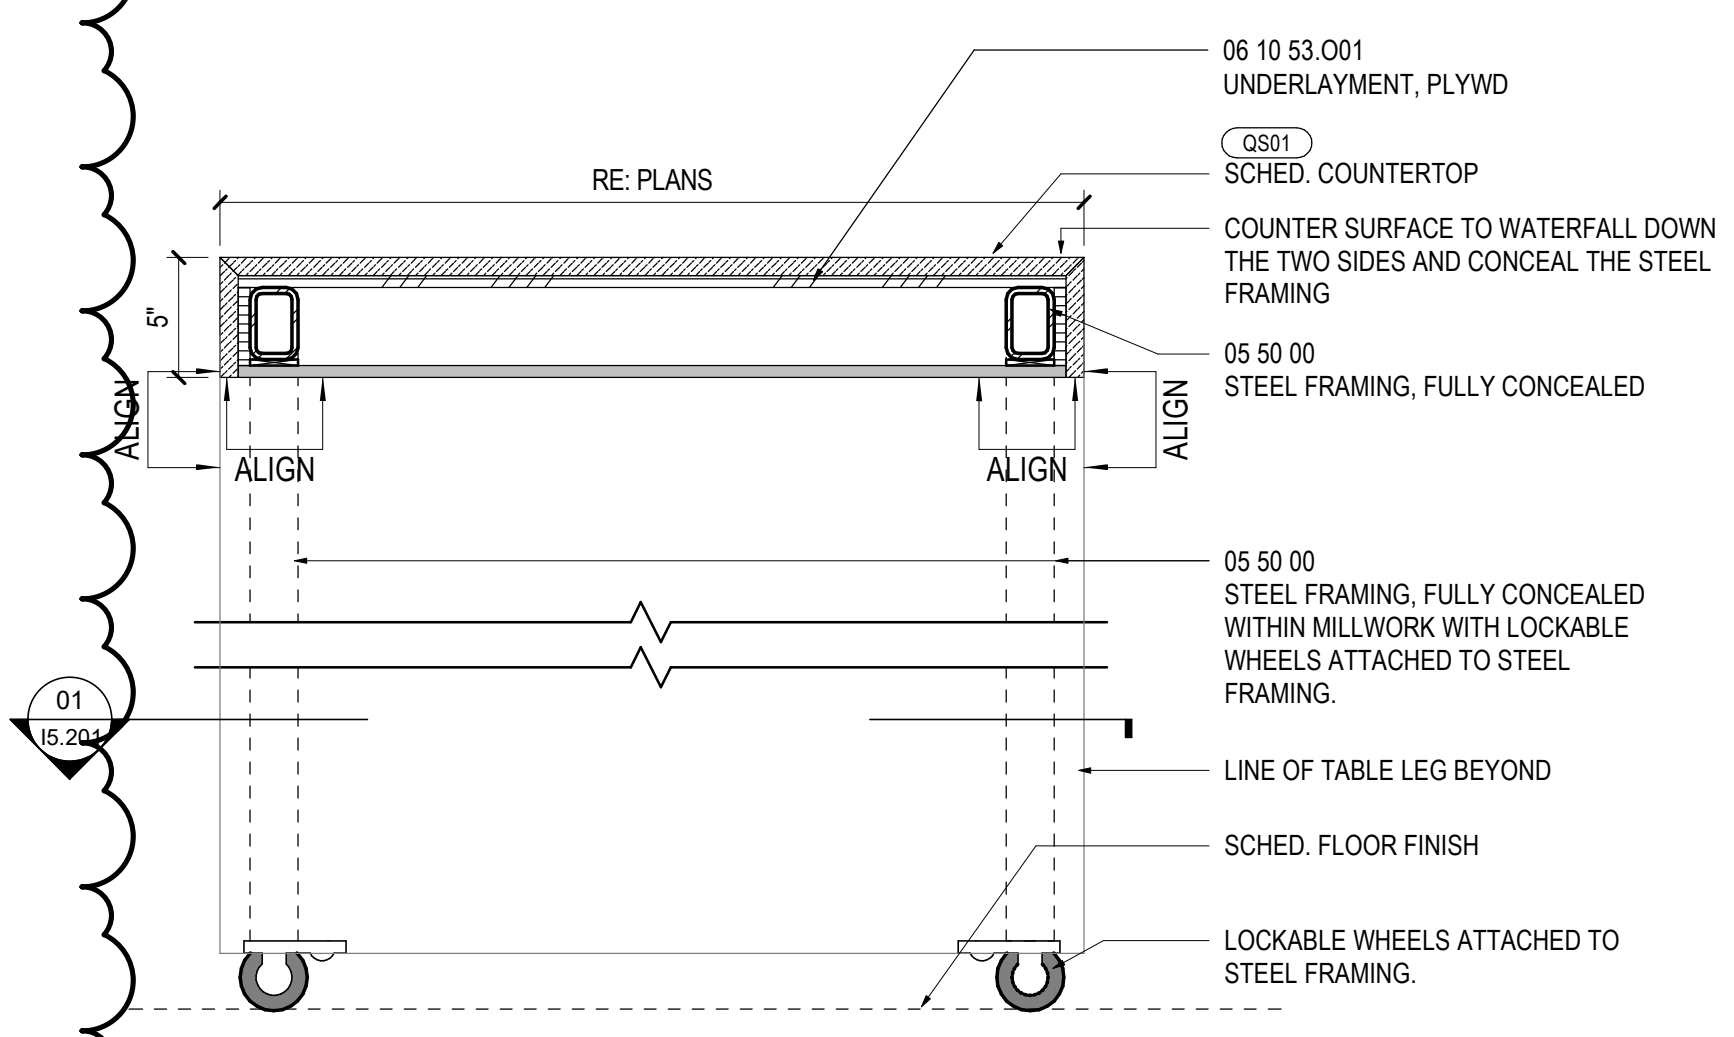

**02 MOVABLE ISLAND - SECTION**  
SCALE: 1 1/2" = 1'-0"

**SHEET NOTES**

**GENERAL NOTES**

- A. ALL BLOCKING TO BE FIRE TREATED.
- B. BASIS OF DESIGN FOR MILLWORK PULLS TO BE "EVERYONE" MILLWORK PULLS MANUFACTURED BY PBA; FINISH: SATIN STAINLESS STEEL.
- C. TRASHBINS TO BE THE FOLLOWING COLORS: TRASH: BLACK/GREY - RECYCLING: BLUE - COMPOST: GREEN.



92 Catamount Road  
Cullowhee, NC 28723

**Gensler**

2020 K St NW  
Washington, DC 20006  
United States  
Tel (202) 721-5200  
Fax +1 202.872.8587



MEP ENGINEERS  
1927 South Tryon Street  
Suite 300  
Charlotte, NC 28203  
Tel 704.338.1292

SCO ID: 21-22998-01  
CIP: 42029

Date	Description
2 04/19/2021	ISSUE FOR PERMIT
3 05/11/2021	ISSUE FOR PERMIT - RESUBMIT
4 10/18/2021	ISSUE FOR BID
6 11/30/2021	ADDENDUM 02

Seal / Signature

Project Name  
**RAMSEY - BASKETBALL LOCKER ROOM RENOVATION**

Project Number  
**009.9478.000**

Description  
**MILLWORK DETAILS**

Scale  
1 1/2" = 1'-0"

**15.201**



92 Catamount Road  
Cullowhee, NC 28723

**Gensler**

2020 K St NW  
Washington, DC 20006  
United States  
Tel (202) 721-5200  
Fax +1 202 872 8587



MEP ENGINEERS  
1927 South Tryon Street  
Suite 300  
Charlotte, NC 28203  
Tel 704.338.1292

SCO ID: 21-22998-01  
CIP: 42029

**SHEET NOTES**

**GENERAL NOTES**

Date	Description
1 03/26/2021	DESIGN DEVELOPMENT - ISSUE FOR PRICING
2 04/19/2021	ISSUE FOR PERMIT
3 06/11/2021	ISSUE FOR PERMIT - RESUBMIT
4 10/18/2021	ISSUE FOR BID
6 11/30/2021	ADDENDUM 02

Seal / Signature


Project Name  
**RAMSEY - BASKETBALL LOCKER ROOM RENOVATION**

Project Number  
**009.9478.000**


Description  
FINISH & FLOOR TRANSITION DETAILS

Scale  
As indicated


**15.300**

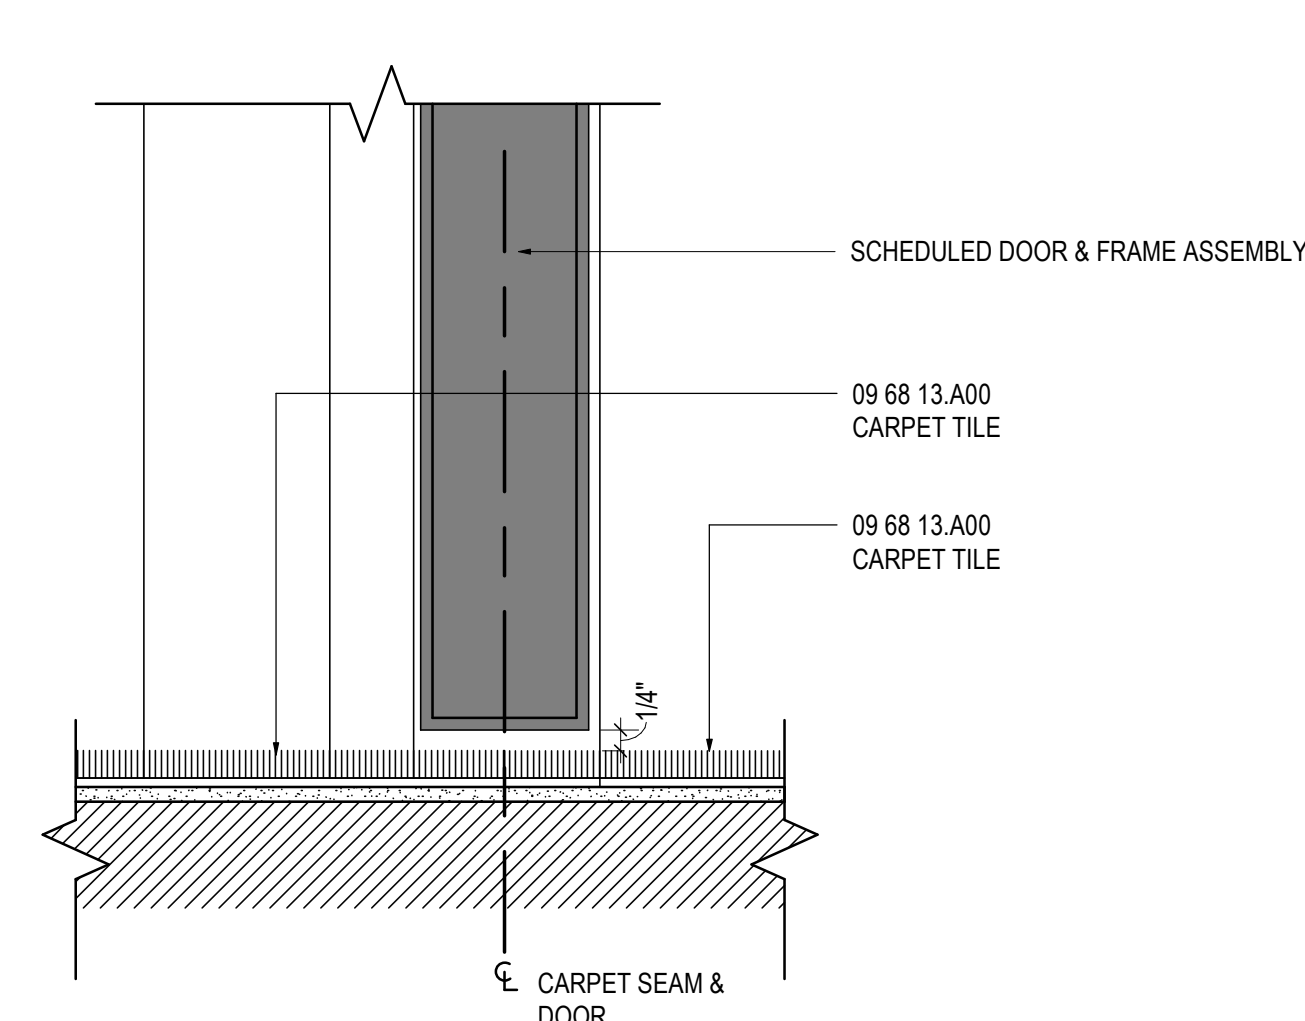


**09 TRANSITION @ CARPET/CARPET**  
SCALE: 6" = 1'-0"

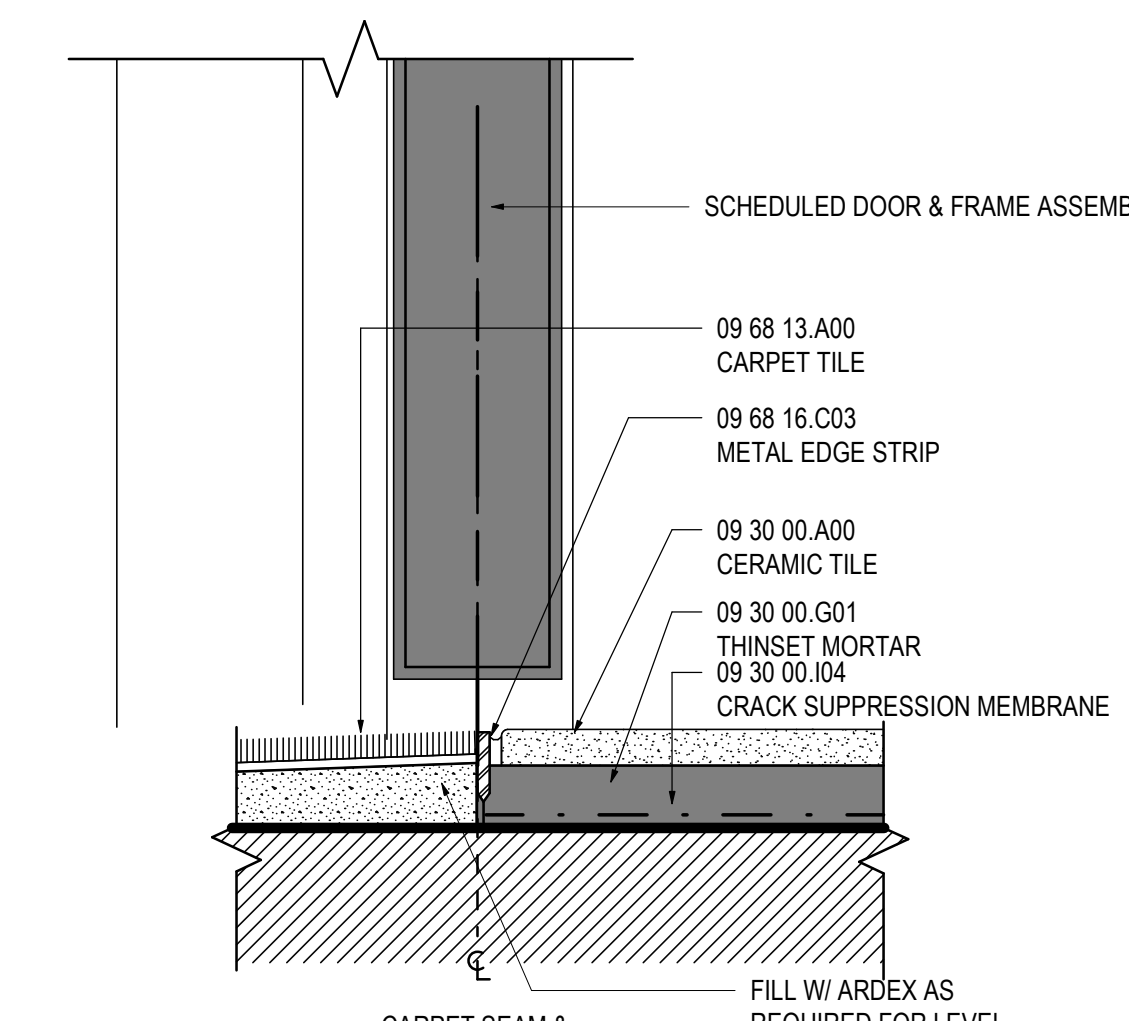


**05 TRANSITION @ 09 / CERAMIC TILE / CARPET**  
SCALE: 6" = 1'-0"

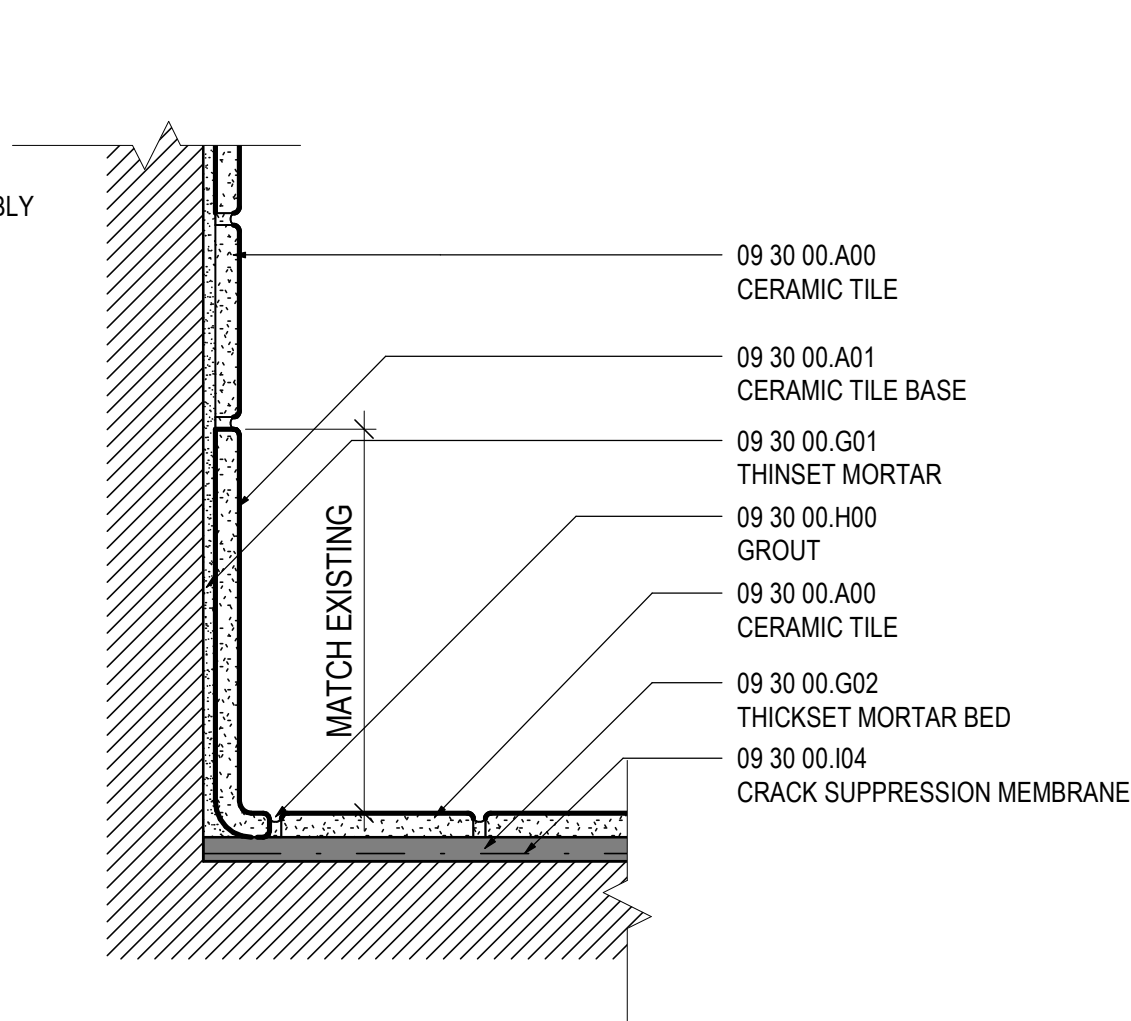


**01 CERAMIC TILE BASE**  
SCALE: 6" = 1'-0"

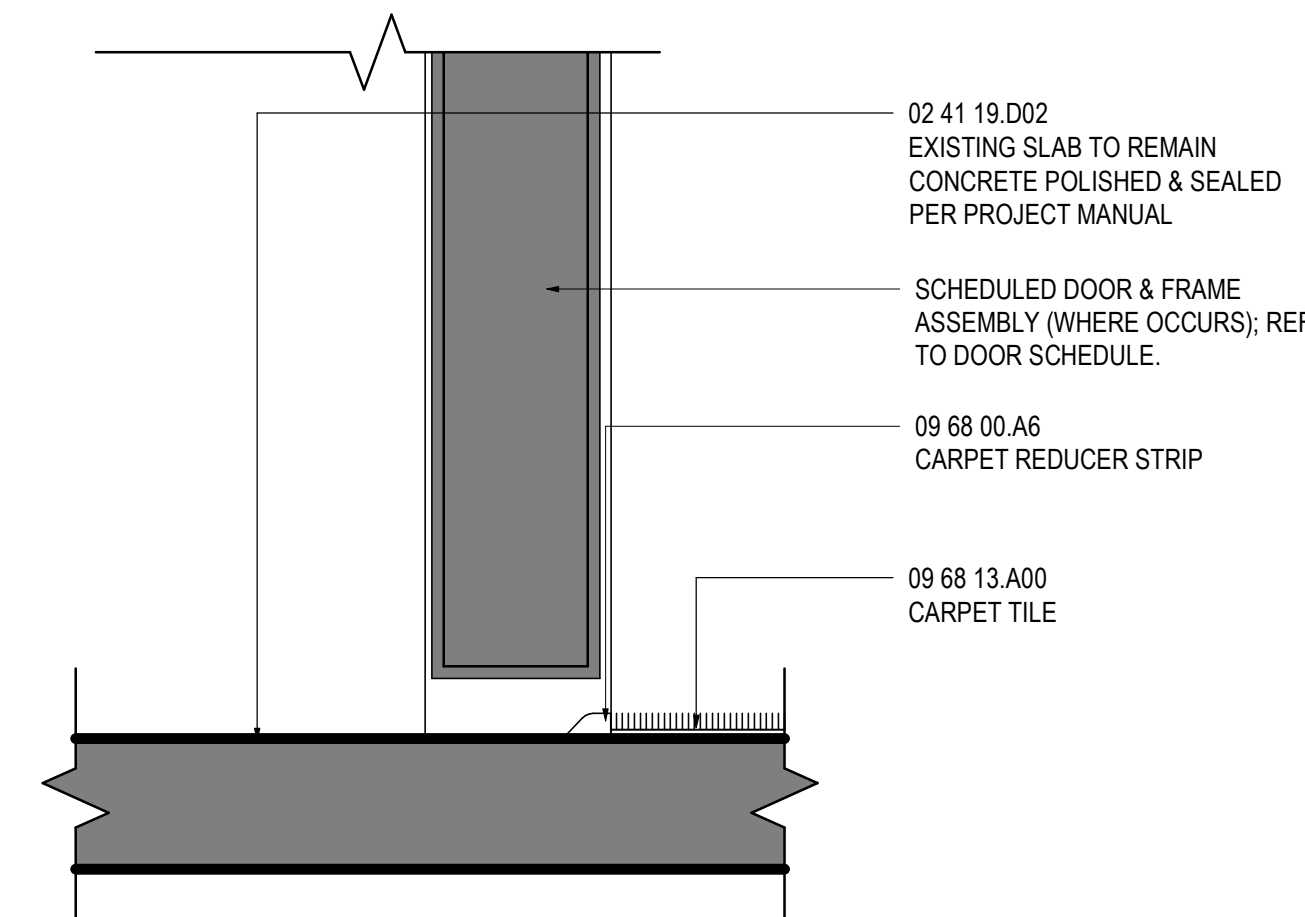


**10 TRANSITION @ CONCRETE / CARPET**  
SCALE: 6" = 1'-0"

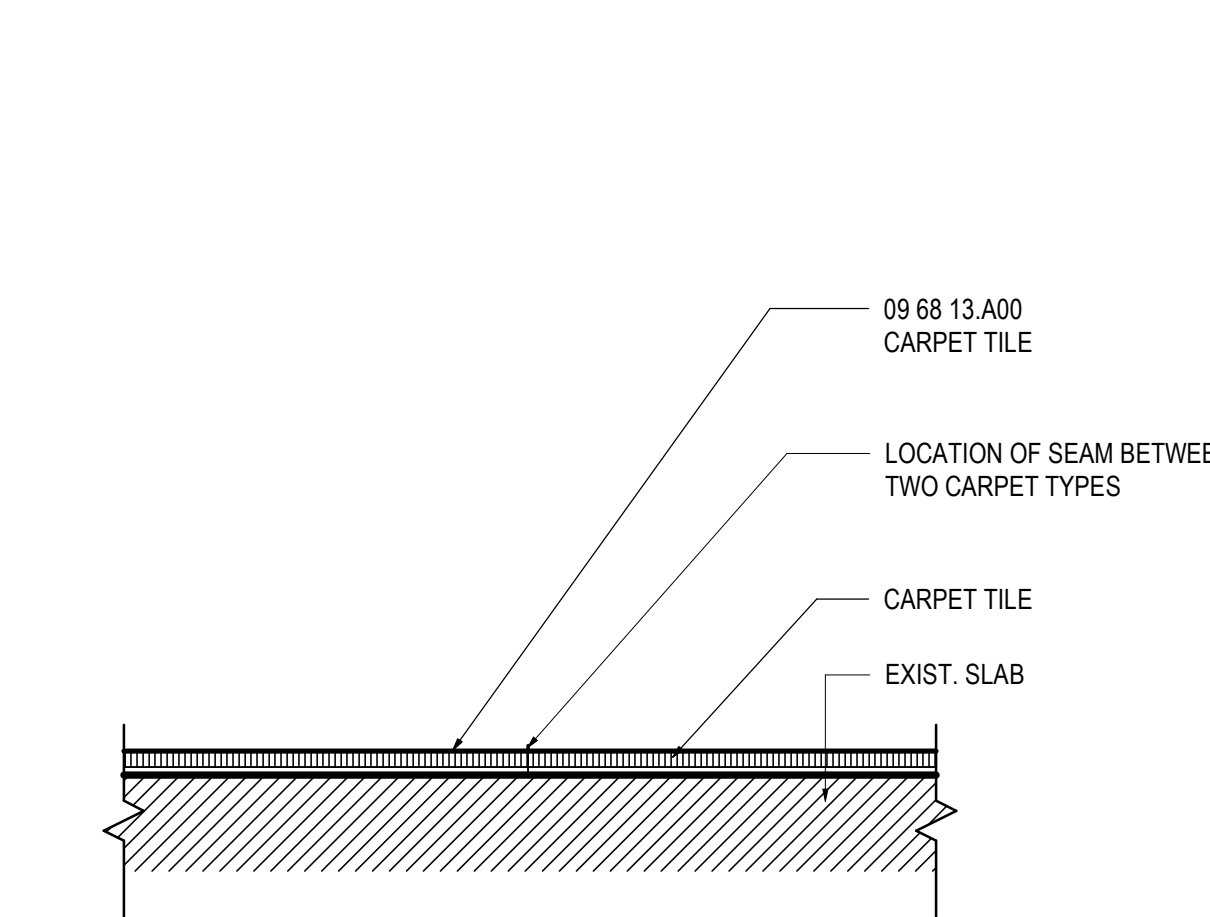


**06 TRANSITION @ TILE CARPET / TILE CARPET**  
SCALE: 6" = 1'-0"

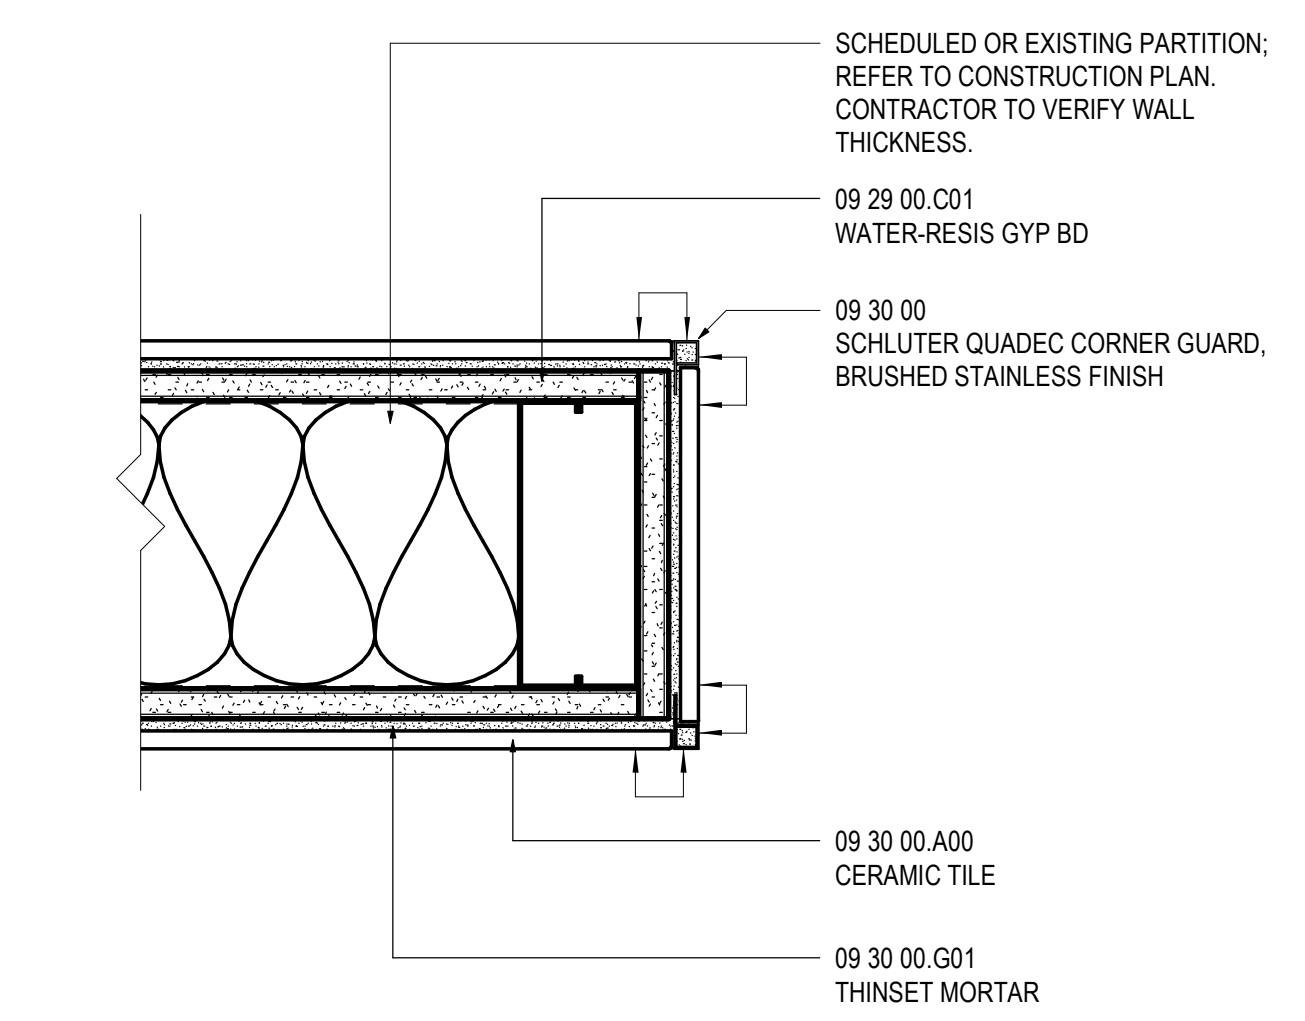


**11 CERAMIC TILE CORNER TRIM**  
SCALE: 3" = 1'-0"

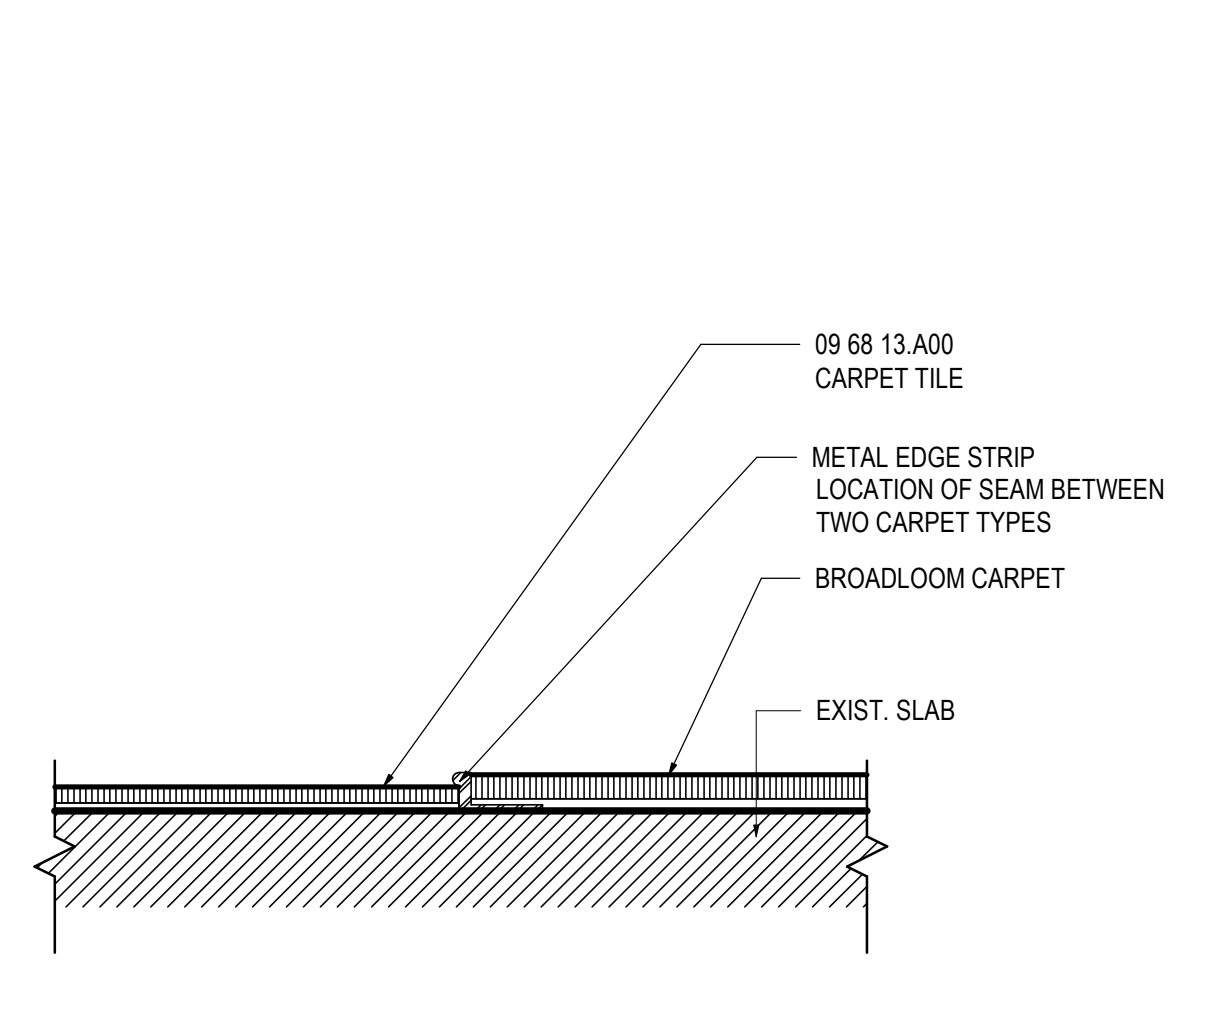


**07 TRANSITION @ TILE CARPET / CARPET**  
SCALE: 6" = 1'-0"

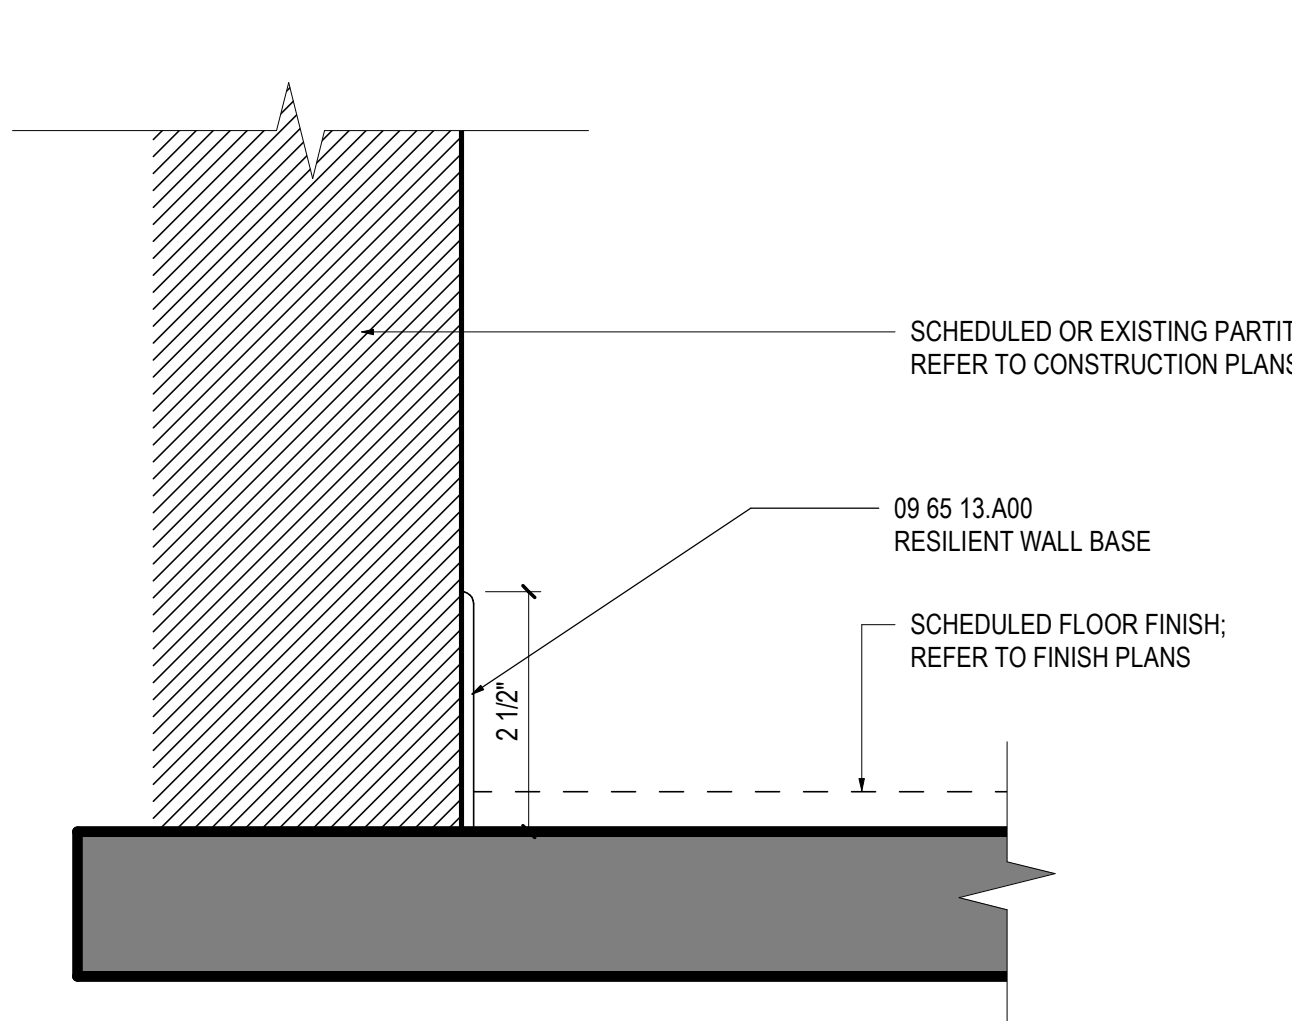

**03 BASE - RESILIENT WALL BASE**  
SCALE: 6" = 1'-0"

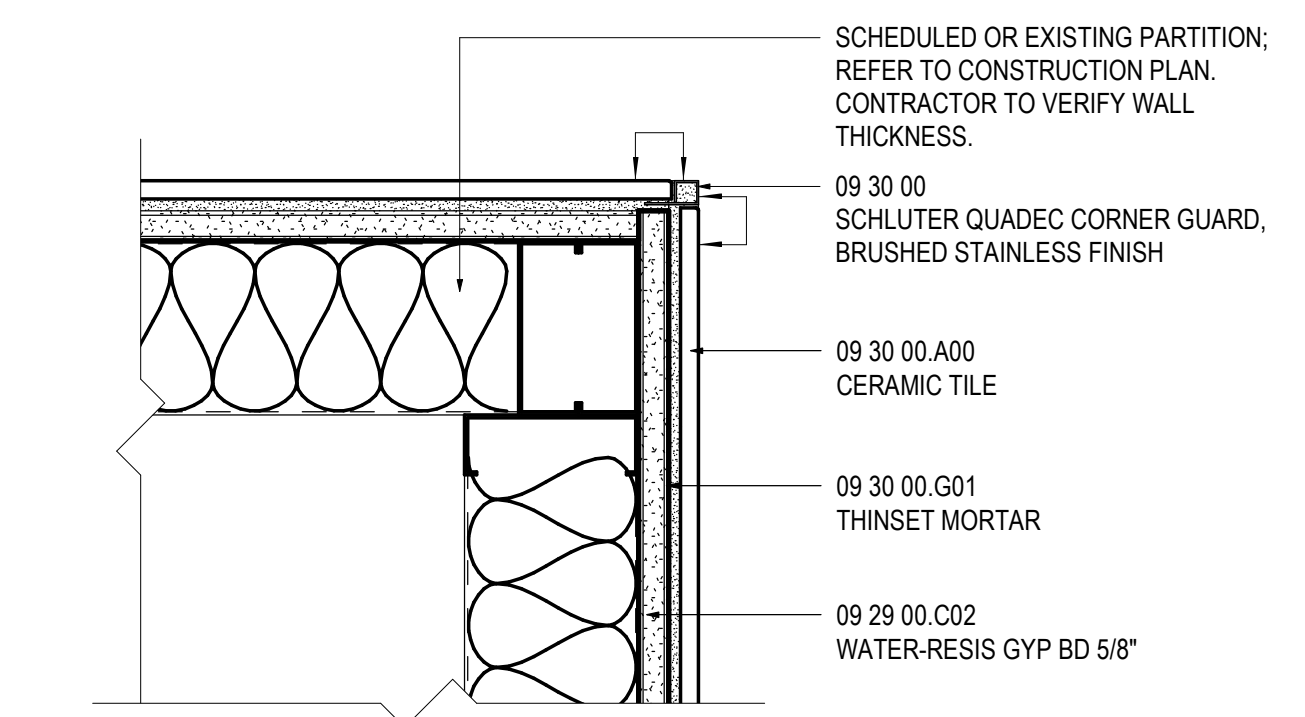

**12 CERAMIC TILE CORNER TRIM**  
SCALE: 3" = 1'-0"

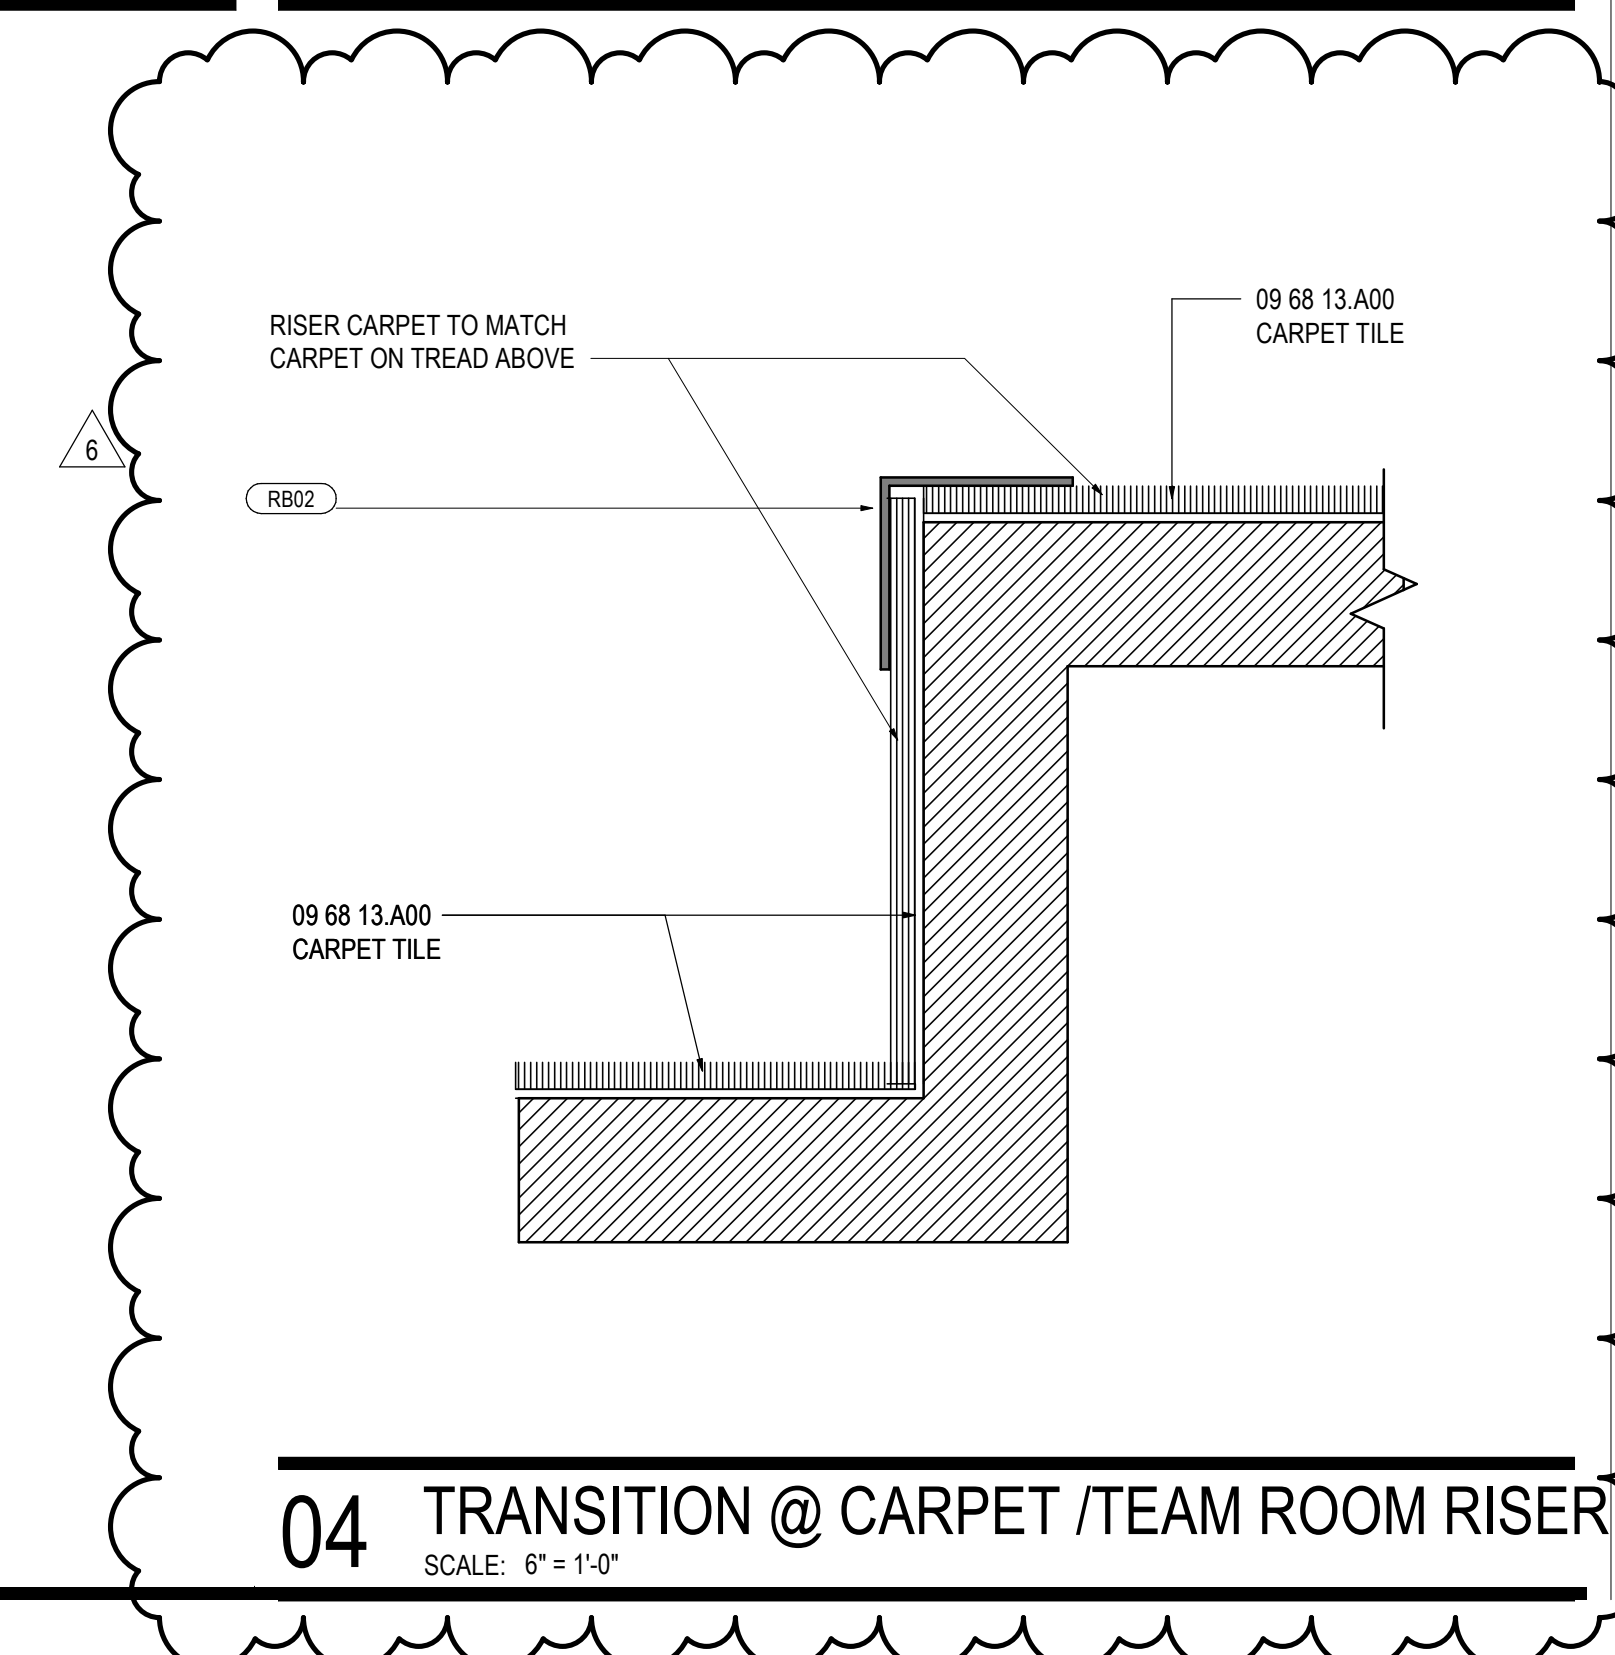

**04 TRANSITION @ CARPET / TEAM ROOM RISER**  
SCALE: 6" = 1'-0"



### Request for Interpretation Log

**Project** WCU Ramsey – Basketball Locker Room Renova  
**Project Location** Cullowhee, NC  
**Owner / Client** Western Carolina University

**Date** 11/30/2021  
**Project Number** 009.9478.000  
**File** 1RFI  
**Page** 1 of 5

No.	Date	Source	Question	Answer	Referred To:	Response Date	Response
1	11/23/2021	Brantley Construction Company	Are any of the items on the furniture schedule on G6.02 to be furnished and/or installed by the contractor? (note M states furniture plans for information only).	Refer to G6.02 updated schedules.	Gensler	11/30/2021	AD01
2	11/23/2021	Brantley Construction Company	Note 04 on D1.001 states to remove existing tile. Is there existing floor tile, wall tile or both in these areas? If there is wall tile what is the existing wall tile height and extent?	There is existing floor tile in the men's and women's restroom. There is existing floor and wall tile in the men's and women's shower that goes up the full height of the wall on all walls.	Gensler	11/30/2021	AD02
3	11/23/2021	Brantley Construction Company	There appear to be numerous items in Room 1401 to be demolished that are not labeled on the demolition plan. Please provide information on all items to be demolished in this room.	Owner to remove all equipment prior to demolition. Any remaining items when it comes time for demolition are to be demoed.	WCU	11/30/2021	AD02
4	11/23/2021	Brantley Construction Company	The countertop shown on 03/I1.101 is noted as solid surface on the elevation (QS01) but section 03/I5.200 shows this as a plastic laminate countertop. Which is correct?	Countertop to be solid surface (QS01). Refer to update on Section 03/I5.200.	Gensler	11/30/2021	AD02
5	11/23/2021	Brantley Construction Company	The countertop shown on 02/I1.102 is noted as solid surface on the elevation (QS01) but section 03/I5.200 shows this as a plastic laminate countertop. Which is correct?	Countertop to be solid surface (QS01). Refer to update on Section 03/I5.200.	Gensler	11/30/2021	AD02
6	11/23/2021	Brantley Construction Company	Acrylic Panel @ lockers, displays?	Acrylic panels are part of the locker manufactures scope.	Gensler	11/30/2021	AD02
7	11/23/2021	Brantley Construction Company	There are two carpet options noted on I1.104 (note 09) but this is not reflected on the bid form. If this alternate is required please provide a revised bid form.	See updated bid documents per add alternate.	Gensler	11/30/2021	AD02
8	11/23/2021	Brantley Construction Company	There are two carpet options noted on I1.106 (note 08) but this is not reflected on the bid form. If this alternate is required please provide a revised bid form.	See updated bid documents per add alternate.	Gensler	11/30/2021	AD02

9	11/23/2021	Brantley Construction Company	Are the graphic walls noted on the plans and interior elevations to be provided and installed by the contractor? If so please provide additional information – no graphic specs information has been provided other than locations (reference note 05 on 06/I1.106 for example).	Contractor to prepare wall with level 05 finish at potential fugure graphic wall locations.	Gensler	11/30/2021	AD02
10	11/23/2021	Brantley Construction Company	Are the custom applied full court graphics to be provided and installed by the contractor?	Custom applied full court graphics are a manufactured product DG02 to be provided and intalled by contractor.	Gensler	11/30/2021	AD02
11	11/23/2021	Brantley Construction Company	There are elevations labeled on 10/I1.108 at the Men's and Women's Shower Rooms 1423 and 1423A but the sheet noted for these elevations (XXI1.105) has not been provided. Please provide this sheet.	Men's and Women's Shower elevations have been provided on Sheet I1.110.	Gensler	11/30/2021	AD02
12	11/23/2021	Brantley Construction Company	There appears to be some sort of shelving or cabinetry shown at Storage Room 1420 on 02, 03, 05 & 06/I1.109 but there are no notes or sections provided to explain what is required. Please clarify if shelving or cabinetry is required at this room and if so please provide additional information.	Refer to G6.02 updated schedules.	Gensler	11/30/2021	AD02
13	11/23/2021	Brantley Construction Company	There are dashed lines shown on D1.001 along 2 walls at existing rooms 1427 and 1428. Do these dashed lines represent items to be demolished? If so please provide information on these items.	Dashed lines have been removed from rooms 1427 and 1428.	Gensler	11/30/2021	AD02
14	11/23/2021	Brantley Construction Company	Please confirm that the lockers should NOT be included in the base bid.	See bid alternate 1 in Adendum 01.	Gensler	11/30/2021	AD01
15	11/23/2021	Brantley Construction Company	Please confirm that the existing toilet partitions at rooms 1424 and 1424A should be demolished and replaced with new.	Existing toilet partitions at rooms 1424 and 1424A to be replaced in kind/ like to existing.	Gensler	11/30/2021	AD02
16	11/23/2021	Brantley Construction Company	I have been unable to locate any hydraulic cement underlayment shown or noted on the plans. Does section 035416 apply to this project? If so please provide locations and requirements.	This may not be required but are included in case they are required by field conditions.	Gensler	11/30/2021	AD02

17	11/23/2021	Brantley Construction Company	I have been unable to locate any access doors shown or noted on the plans. Does section 083113 apply to this project? If so please provide locations and requirements.	This may not be required but are included in case they are required by field conditions.	Gensler	11/30/2021	AD02
18	11/23/2021	Brantley Construction Company	Fire extinguishers and cabinets are specified in section 104400 but there are no fire extinguishers or cabinets shown on the plans. Does section 104400 apply to this project? If so please provide locations and requirements.	This may not be required but are included in case they are required by field conditions.	Gensler	11/30/2021	AD02
19	11/23/2021	Brantley Construction Company	Elevation 04/11.102 notes glazing type GL01 at the front of the clothing & shoe display. Sections 7 & 11/15.200 note the front of the display as acrylic panel. Which is correct?	There is no glazing at the front of the clothing and shoe display. This has been updated in sections 7 & 11 on sheet I5.200.	Gensler	11/30/2021	AD02
20	11/23/2021	Brantley Construction Company	Please verify that the fixed seating is provided and installed by the Owner per the note under the "Miscellaneous Equipment" heading (item 400) on G6.02.	Refer to G6.02 updated schedules.	Gensler	11/30/2021	AD01
21	11/23/2021	Brantley Construction Company	Is plywood sheathing required behind all plastic laminate wall panels?	Plywood sheathing is required behind all plastic laminate wall panels.	Gensler	11/30/2021	AD02
22	11/23/2021	Brantley Construction Company	Is plywood sheathing required behind all decorative glass wall panels?	Plywood sheathing is required behind all decorative glass wall panels.	Gensler	11/30/2021	AD02
23	11/23/2021	Brantley Construction Company	The Supplementary General Conditions of the Formal Contract, Article 8, Paragraph I restricts use of employees on this project with criminal charges and convictions. Will this be implemented on this project?	Yes this will be implemented on this project.	WCU	11/30/2021	AD02
24	11/23/2021	Brantley Construction Company	The Supplementary General Conditions of the Formal Contract, Article 8, Paragraph J requires background checks for all employees who work on the site. Is this for new hires or all employees?	Yes this will be for all employees.	WCU	11/30/2021	AD02
25	11/23/2021	Brantley Construction Company	Please confirm Fixed Audience Seating is by Owner as stated on G6.02 Miscellaneous Equipment Note 400.	Refer to G6.02 updated schedules.	Gensler	11/30/2021	AD01

26	11/22/2021	Jordan White	Is the UPHOLSTERY for the lockers rooms supplied by the GC and is there a spec section associated with the Upholstered?	Upholstery in the lockers to be provided by locker manufacture. All other upholstery to be provided by GC.	Gensler	11/30/2021	AD02
27	11/22/2021	Jordan White	For clarification, what is the owner furnishing for this project. There is some discrepancy from the pre-bid meeting and the Bid documents?	Refer to G6.02 updated schedules.	Gensler	11/30/2021	AD01
28	11/22/2021	Jordan White	Is there specs for the toilet partitions?	Toilet partitions have been added to the specifications.	Gensler	11/30/2021	AD02
29	11/22/2021	Jordan White	On the I1.104, it refers to I1.105 # 05,02,03,01, but on I1.105, there is only details 01 and 03, no 02 or 05.	Elevations 02 and 05 are located on sheet I5.104. This has been updated in the reference elevation.	Gensler	11/30/2021	AD02
30	11/24/2021	Brantley Construction Company	I have been unable to locate any retrofit fire resistive material shown or noted on the plans. Does section 070180 apply to this project? If so please provide locations and requirements.	This may not be required but are included in case they are required by field conditions.	Gensler	11/30/2021	AD02
31	11/24/2021	Brantley Construction Company	RB02 is noted on 04/I5.300. RB02 is not listed on the on the finish materials legend on G6.02. Please provide information for RB02.	RB02 has been added to the finish legend on G6.02.	Gensler	11/30/2021	AD02
32	11/24/2021	Brantley Construction Company	Details for a movable island are provided on I5.201 but I have not been able to locate any mention of a movable island anywhere else on the plans. Are movable islands required to be furnished and installed by the contractor? If so how many are required?	Movable island is to be furnished and installed by contractor. There is one that is required located in the Women's Players Lounge 1427. See sheet 08/I1.106 detail 02/I5.201.	Gensler	11/30/2021	AD02
33	11/24/2021	Brantley Construction Company	Is the wall tile in Shower Rooms 1423 & 1423A full height, floor to ceiling?	The wall tile in Shower Rooms 1423 & 1423A are full height, floor to ceiling. Refer to Sheet I1.110.	Gensler	11/30/2021	AD02
34	11/24/2021	Brantley Construction Company	Are locker rooms considered "wet areas" requiring moisture resistant gypsum board per note 15 on A1.000?	Yes locker rooms are considered "wet areas" and require moisture resistant gypsum board.	Gensler	11/30/2021	AD02

<p>35</p>	<p>11/24/2021</p>	<p>Brantley Construction Company</p>	<p>There is not enough information on the demolition drawings to determine if the existing wall tile is on a mortar bed over block walls. If that is the case, we would highly suggest the installation be changed to tile over tile installation per NTCA method TR713 in conjunction with Mapei Eco Prime grip bond promoting primer in lieu of demo of these walls. Detail Below and additional information attached.</p>	<p>We do not accept the suggested method of installation.</p>	<p>Gensler</p>	<p>11/30/2021</p>	<p>AD02</p>
-----------	-------------------	--------------------------------------	--	---	----------------	-------------------	-------------